


WEST HEAD WALL AND WING WALL ELEVATION
 SHOWING REINFORCING STEEL IN FRONT FACE OF HEAD WALL AND WING WALL
 SCALE 1:40

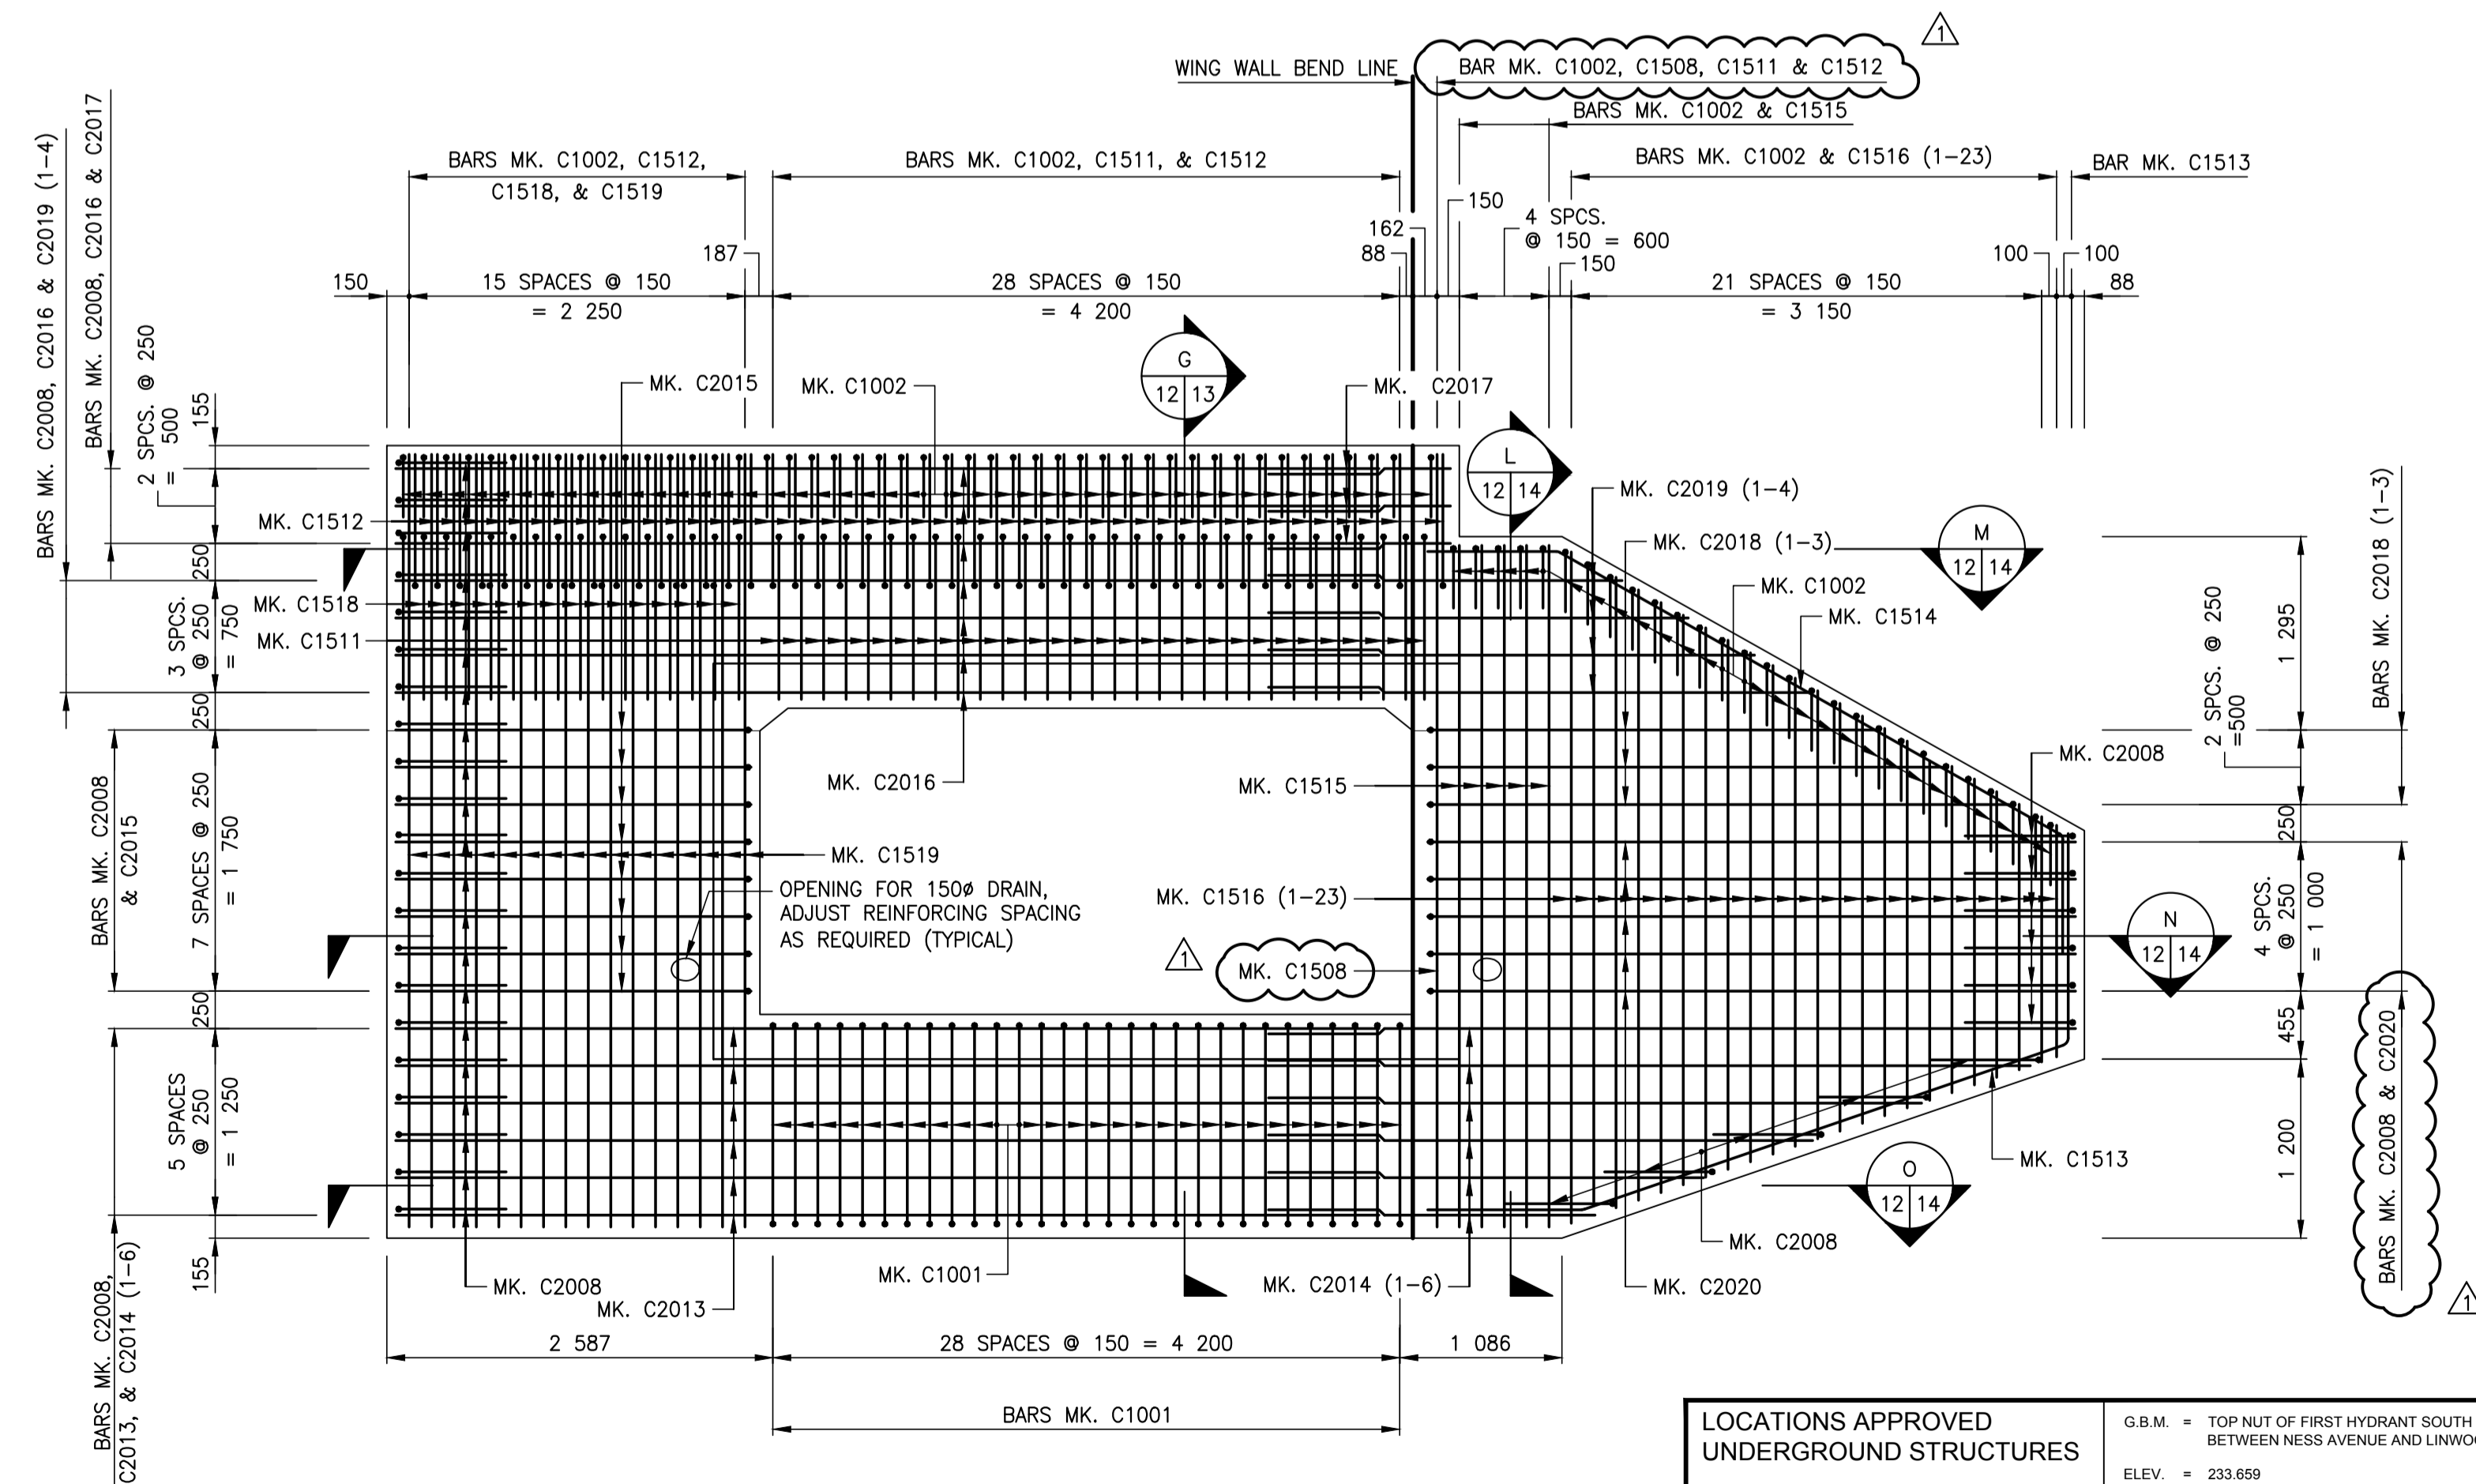

WEST HEAD WALL AND WING WALL ELEVATION
 SHOWING REINFORCING STEEL IN REAR FACE OF HEAD WALL AND WING WALL
 SCALE 1:40

NOTE


- 1. FOR SECTION G-G, SEE SHEET 13.
- 2. FOR SECTION L-L, M-M, N-N, AND O-O SEE SHEET 14.
- 3. FOR BILL OF REINFORCING STEEL, SEE SHEET 21 TO 22.



METRIC
 WHOLE NUMBERS INDICATE MILLIMETRES
 DECIMALIZED NUMBERS INDICATE METRES

LOCATIONS APPROVED UNDERGROUND STRUCTURES		G.B.M. = TOP NUT OF FIRST HYDRANT SOUTH OF INTERSECTION BETWEEN NESS AVENUE AND LINWOOD STREET ELEV. = 233.659	
SIGNED BY:	DATE	DESIGNED BY:	DATE
LOCATION OF UNDERGROUND STRUCTURES AS SHOWN ARE BASED ON THE BEST INFORMATION AVAILABLE BUT NO GUARANTEE IS GIVEN THAT ALL EXISTING UTILITIES ARE SHOWN OR THAT THE GIVEN LOCATIONS ARE EXACT CONFIRMATION OF EXISTANCE AND EXACT LOCATION OF ALL SERVICES MUST BE OBTAINED FROM THE INDIVIDUAL UTILITIES BEFORE PROCEEDING			
No.	REVISIONS	DATE	BY
1	ISSUED FOR ADDENDUM No. 2	17.12.08	JL
0	ISSUED FOR TENDER	17.11.23	JL

wsp		WSP Canada Group Limited 93 Lombard Avenue, Suite 111 Winnipeg MB R3B 3B1 T+ 1 204-943-3178 F+ 1 204-943-4948 www.wsp.com	
DESIGNED BY:	AG	CHECKED BY:	MLW
DRAWN BY:	FD	APPROVED BY:	JL
HOR. SCALE:	1:40	RELEASED FOR CONSTRUCTION:	
VERTICAL:	1:40		
		DATE:	17.11.23

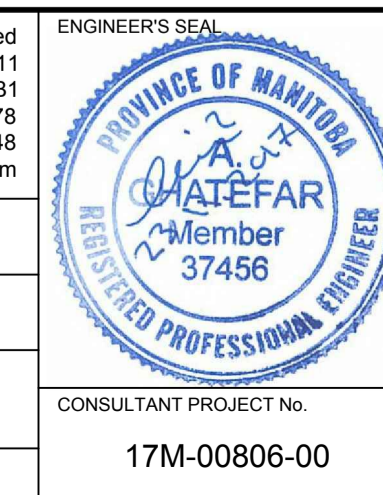

THE CITY OF WINNIPEG
 PUBLIC WORKS DEPARTMENT
 ENGINEERING DIVISION

Winnipeg

TRURO CREEK CULVERT REPLACEMENT AT WINCHESTER STREET

CITY DRAWING NUMBER: C322-17-12
 BID OPPORTUNITY NUMBER: 1014-2017
 SHEET OF: 12 OF 25
 REV 1

REINFORCING DETAILS (SHEET 3 OF 5)

CONSULTANT PROJECT No. 17M-0806-00