




1
A5.4 WALL SECTION AT SERVICE ENTRANCE
SCALE 1:10

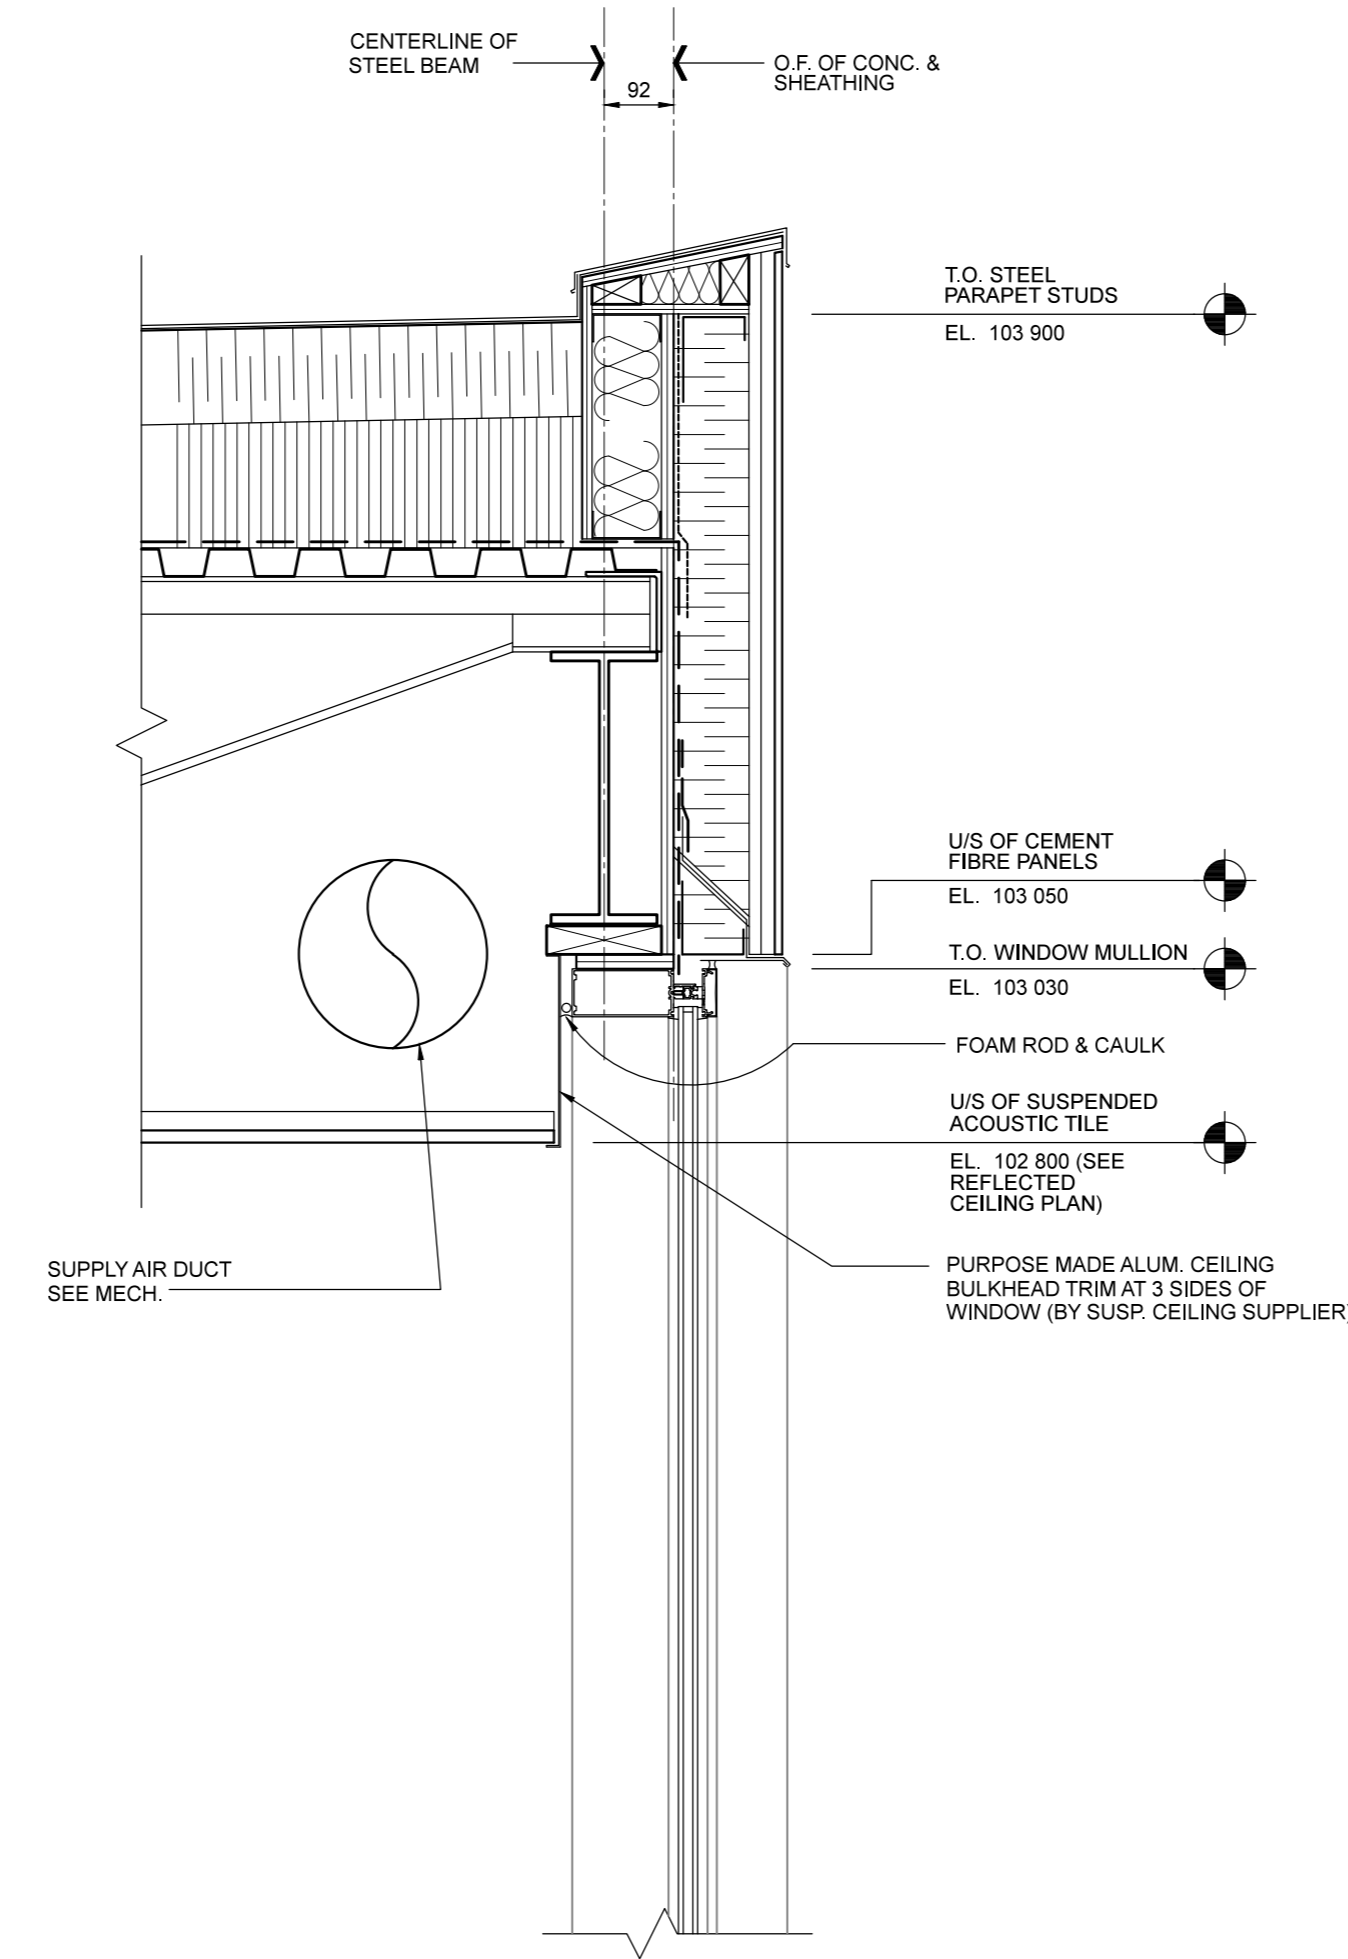

4
A5.4 OFFICE WINDOW SECTION
SCALE 1:10

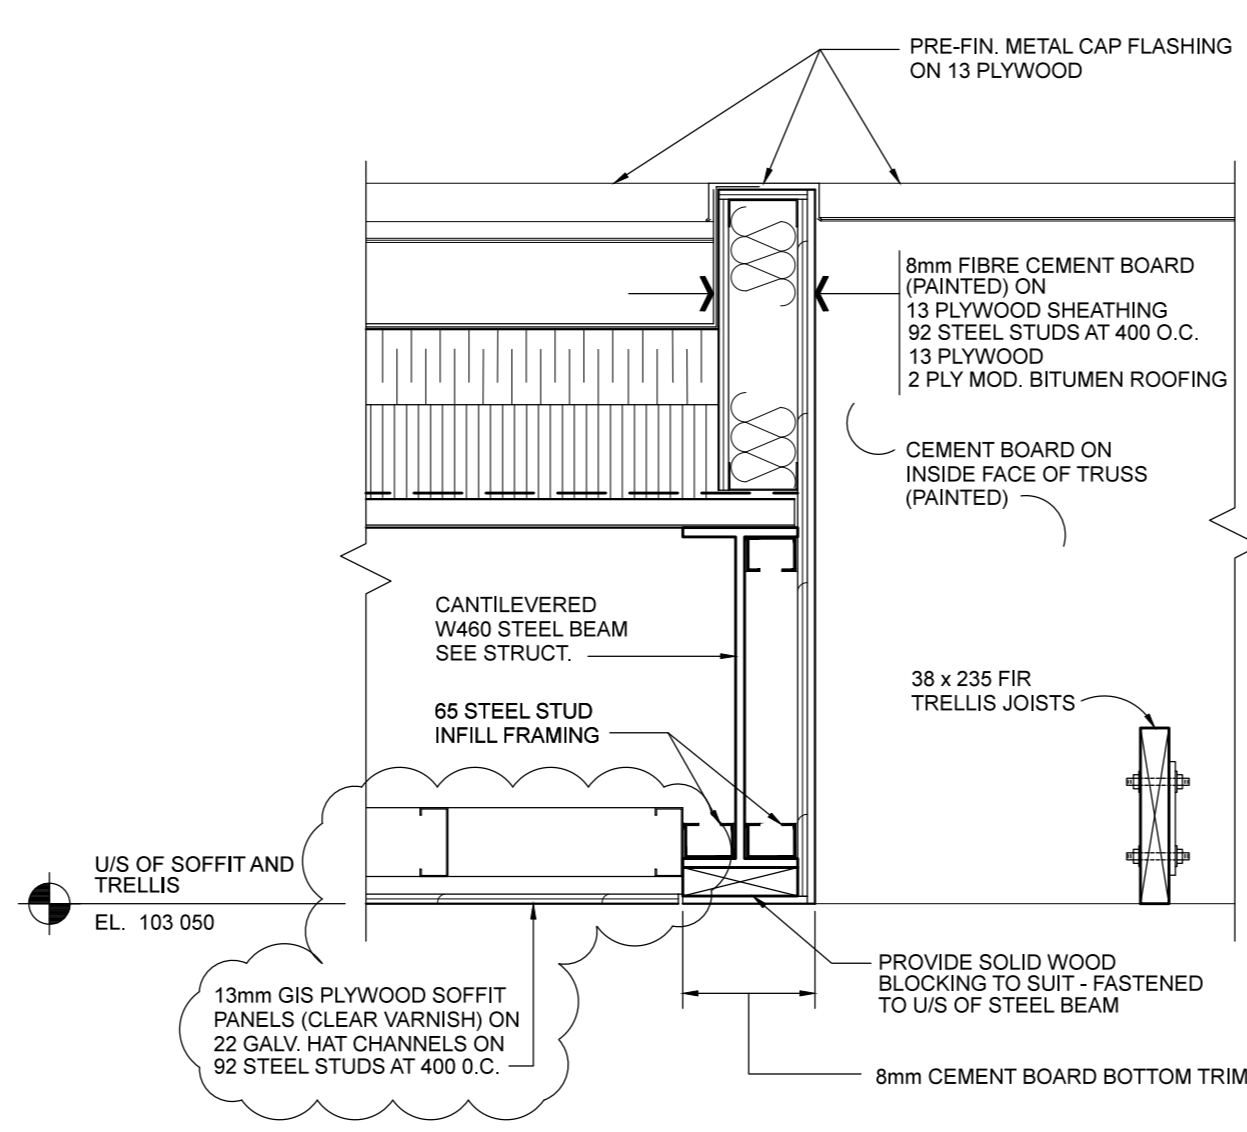


5
A5.4 SECTION
SCALE 1:10

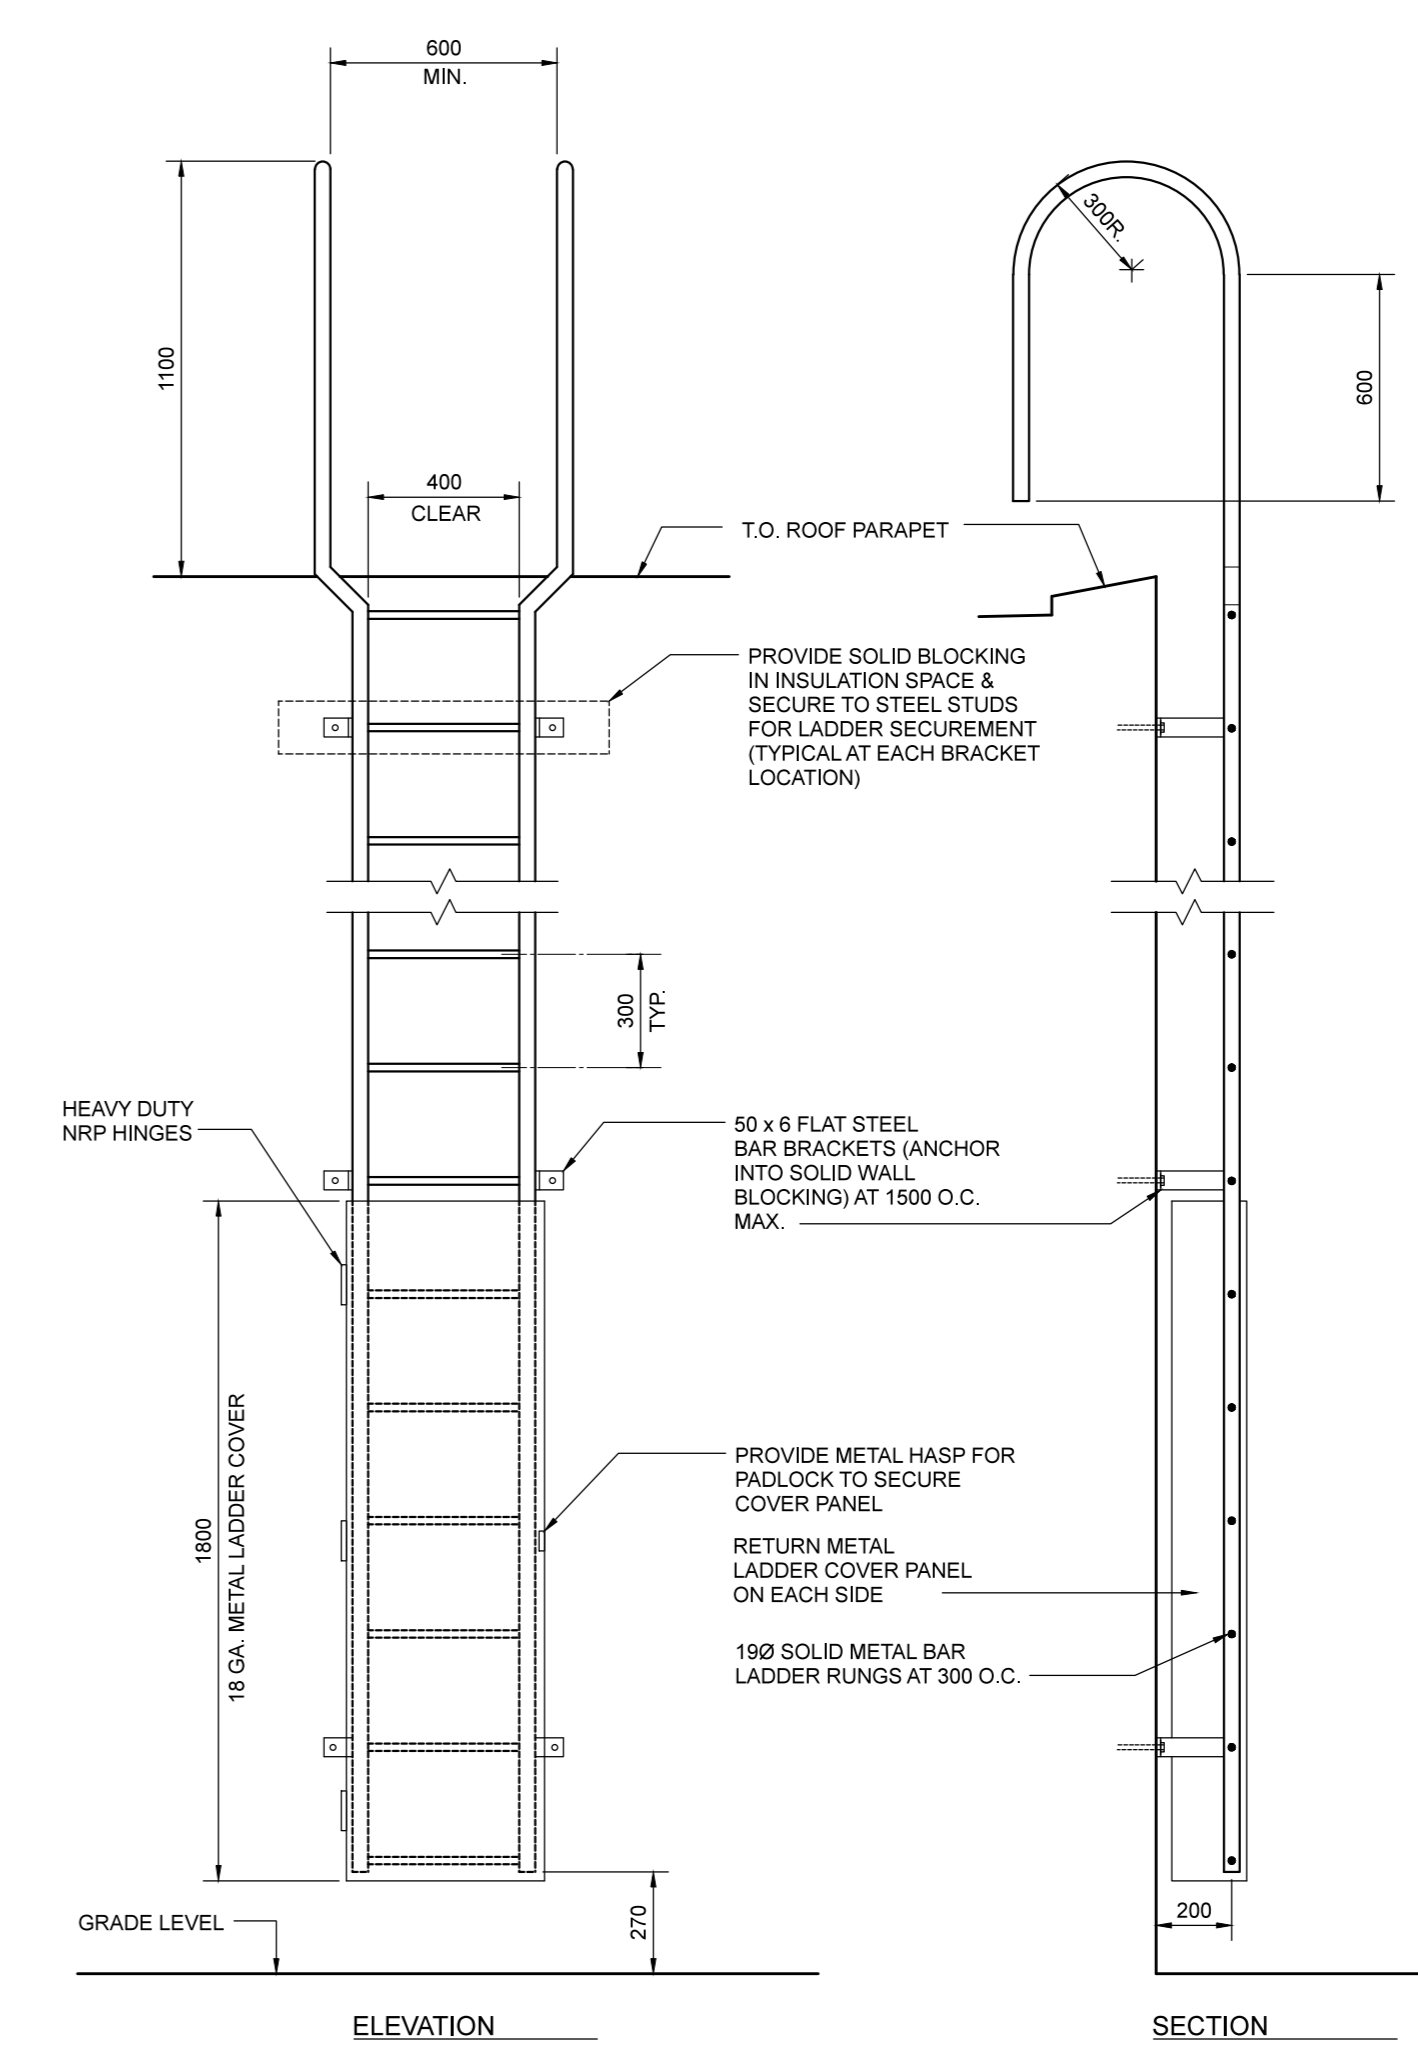

2
A5.4 ROOF ACCESS LADDER DETAILS
SCALE 1:20

NOTE: ALL METAL COMPONENTS TO BE GALVANIZED AND PAINTED

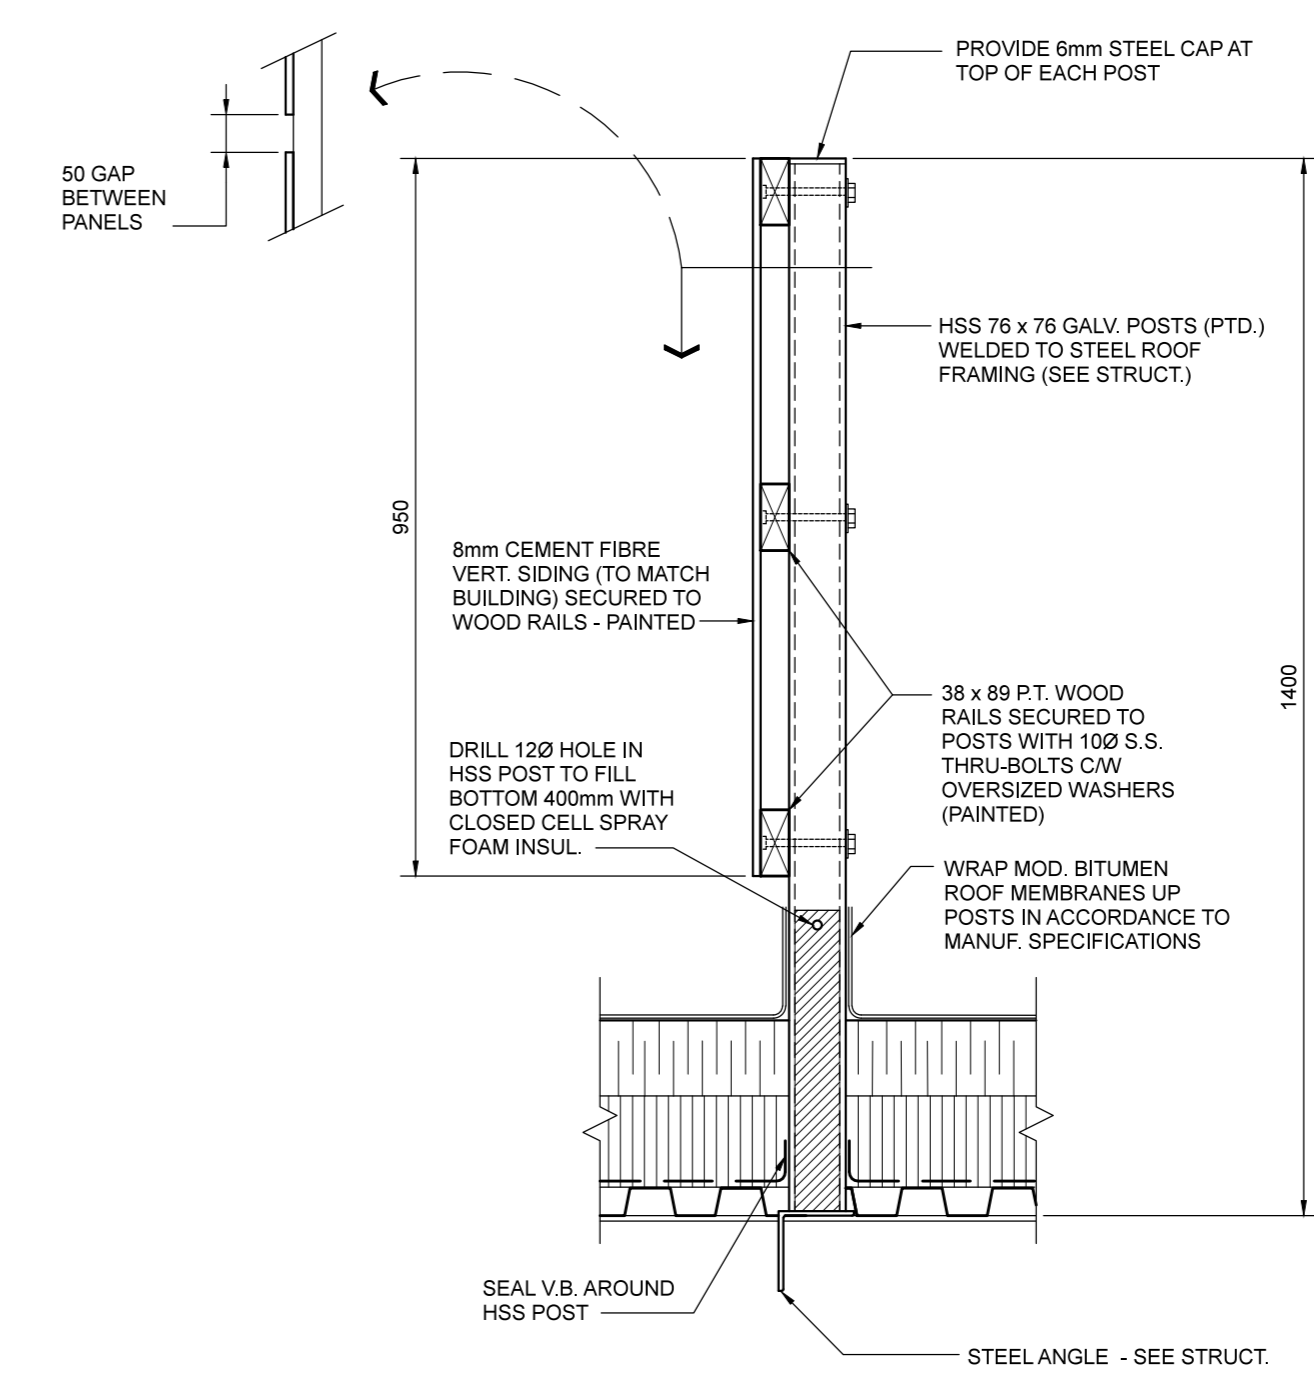

3
A5.4 ROOF TOP SCREEN DETAIL
SCALE 1:10

4	YY.MM.DD	-
3	YY.MM.DD	-
2	YY.MM.DD	-
1	17.08.24	ISSUED FOR ADDENDUM 1
0	17.06.30	ISSUED FOR CONSTRUCTION
No.	DATE	REVISION / ISSUANCE

Architect

| x | architecture inc.

Engineer

Project

KILDONAN PARK MAINTENANCE BUILDING

Sheet Title

SECTIONS & DETAILS

Project No. 1559

Date

JUNE 30, 2017

Sheet

A5.4