




1 VESTIBULE & HIGHER ROOF SECTION
SCALE: 1:20

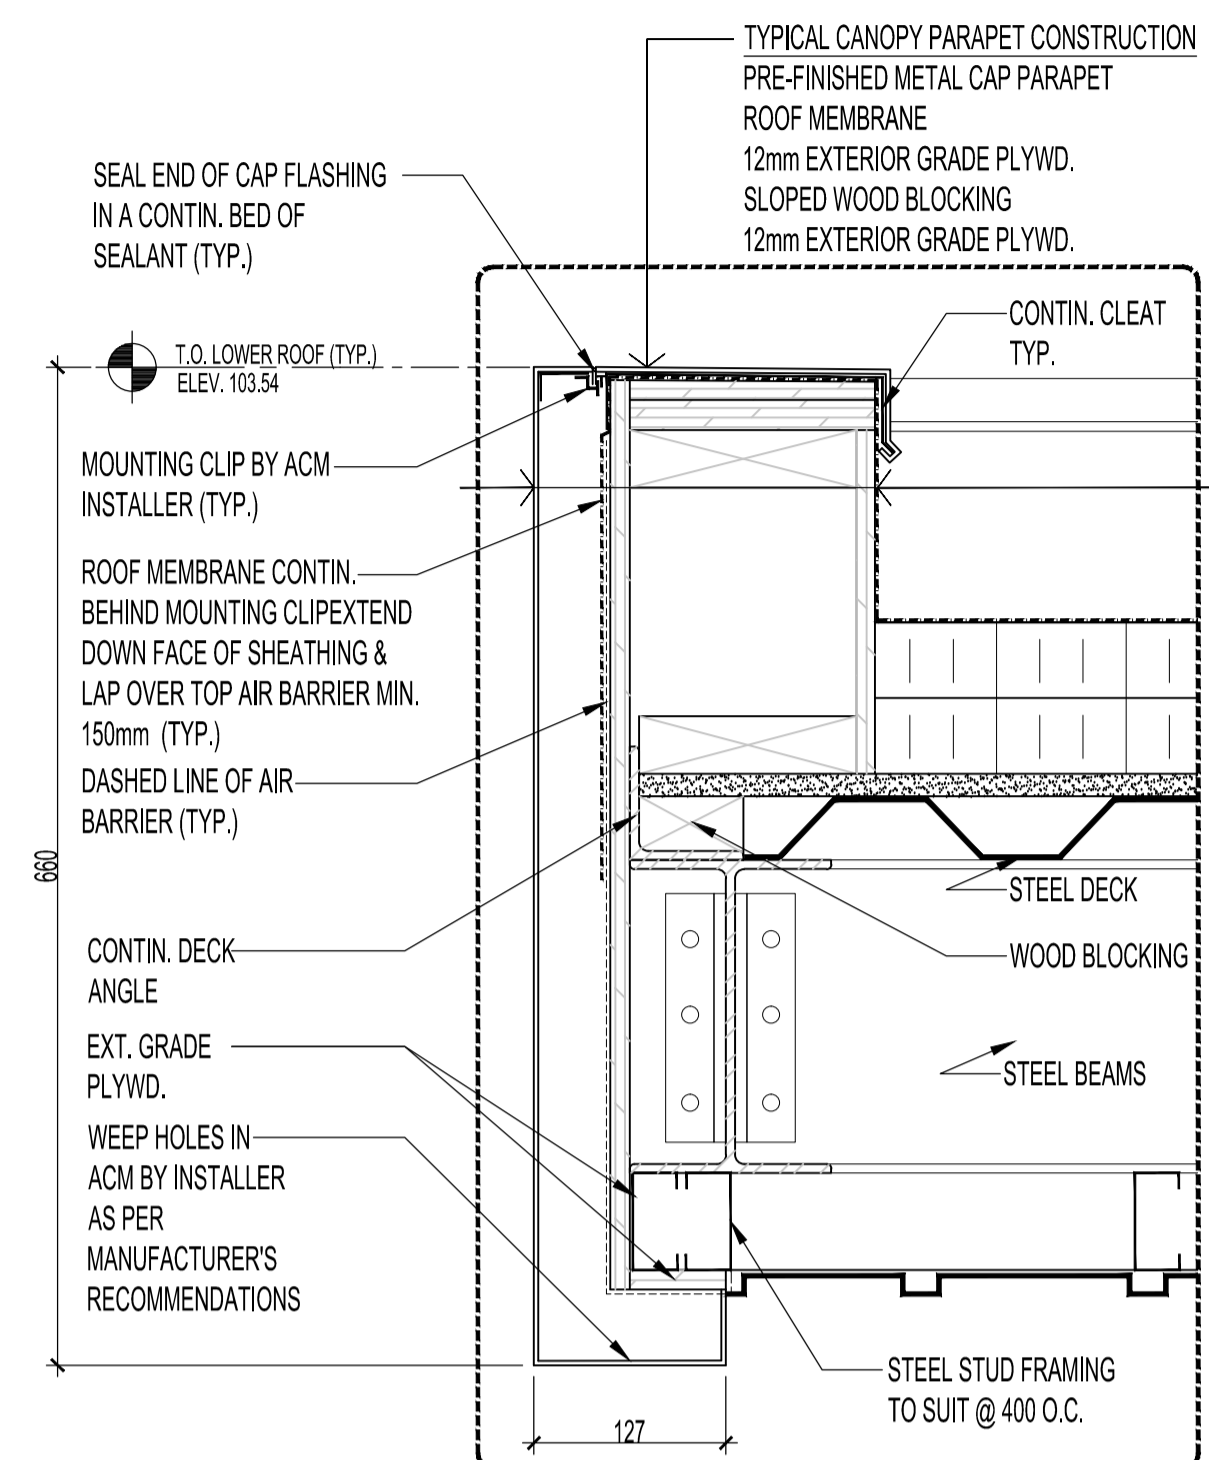

1 CANOPY PARAPET DETAIL
SCALE: 1:5

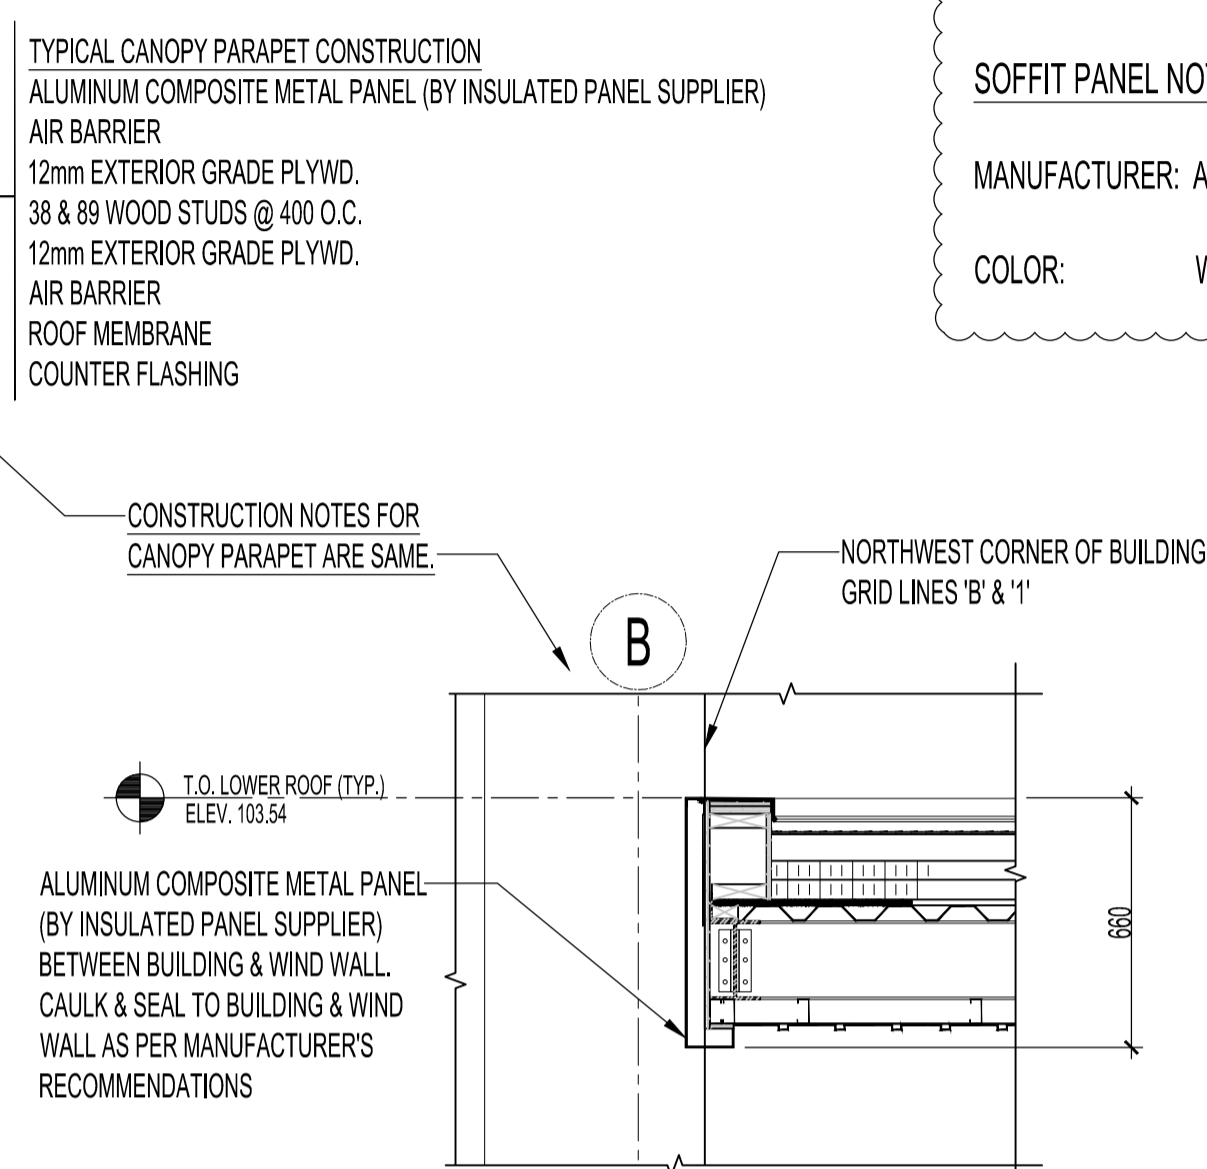

4 VESTIBULE CANOPY SECTION
SCALE: 1:20

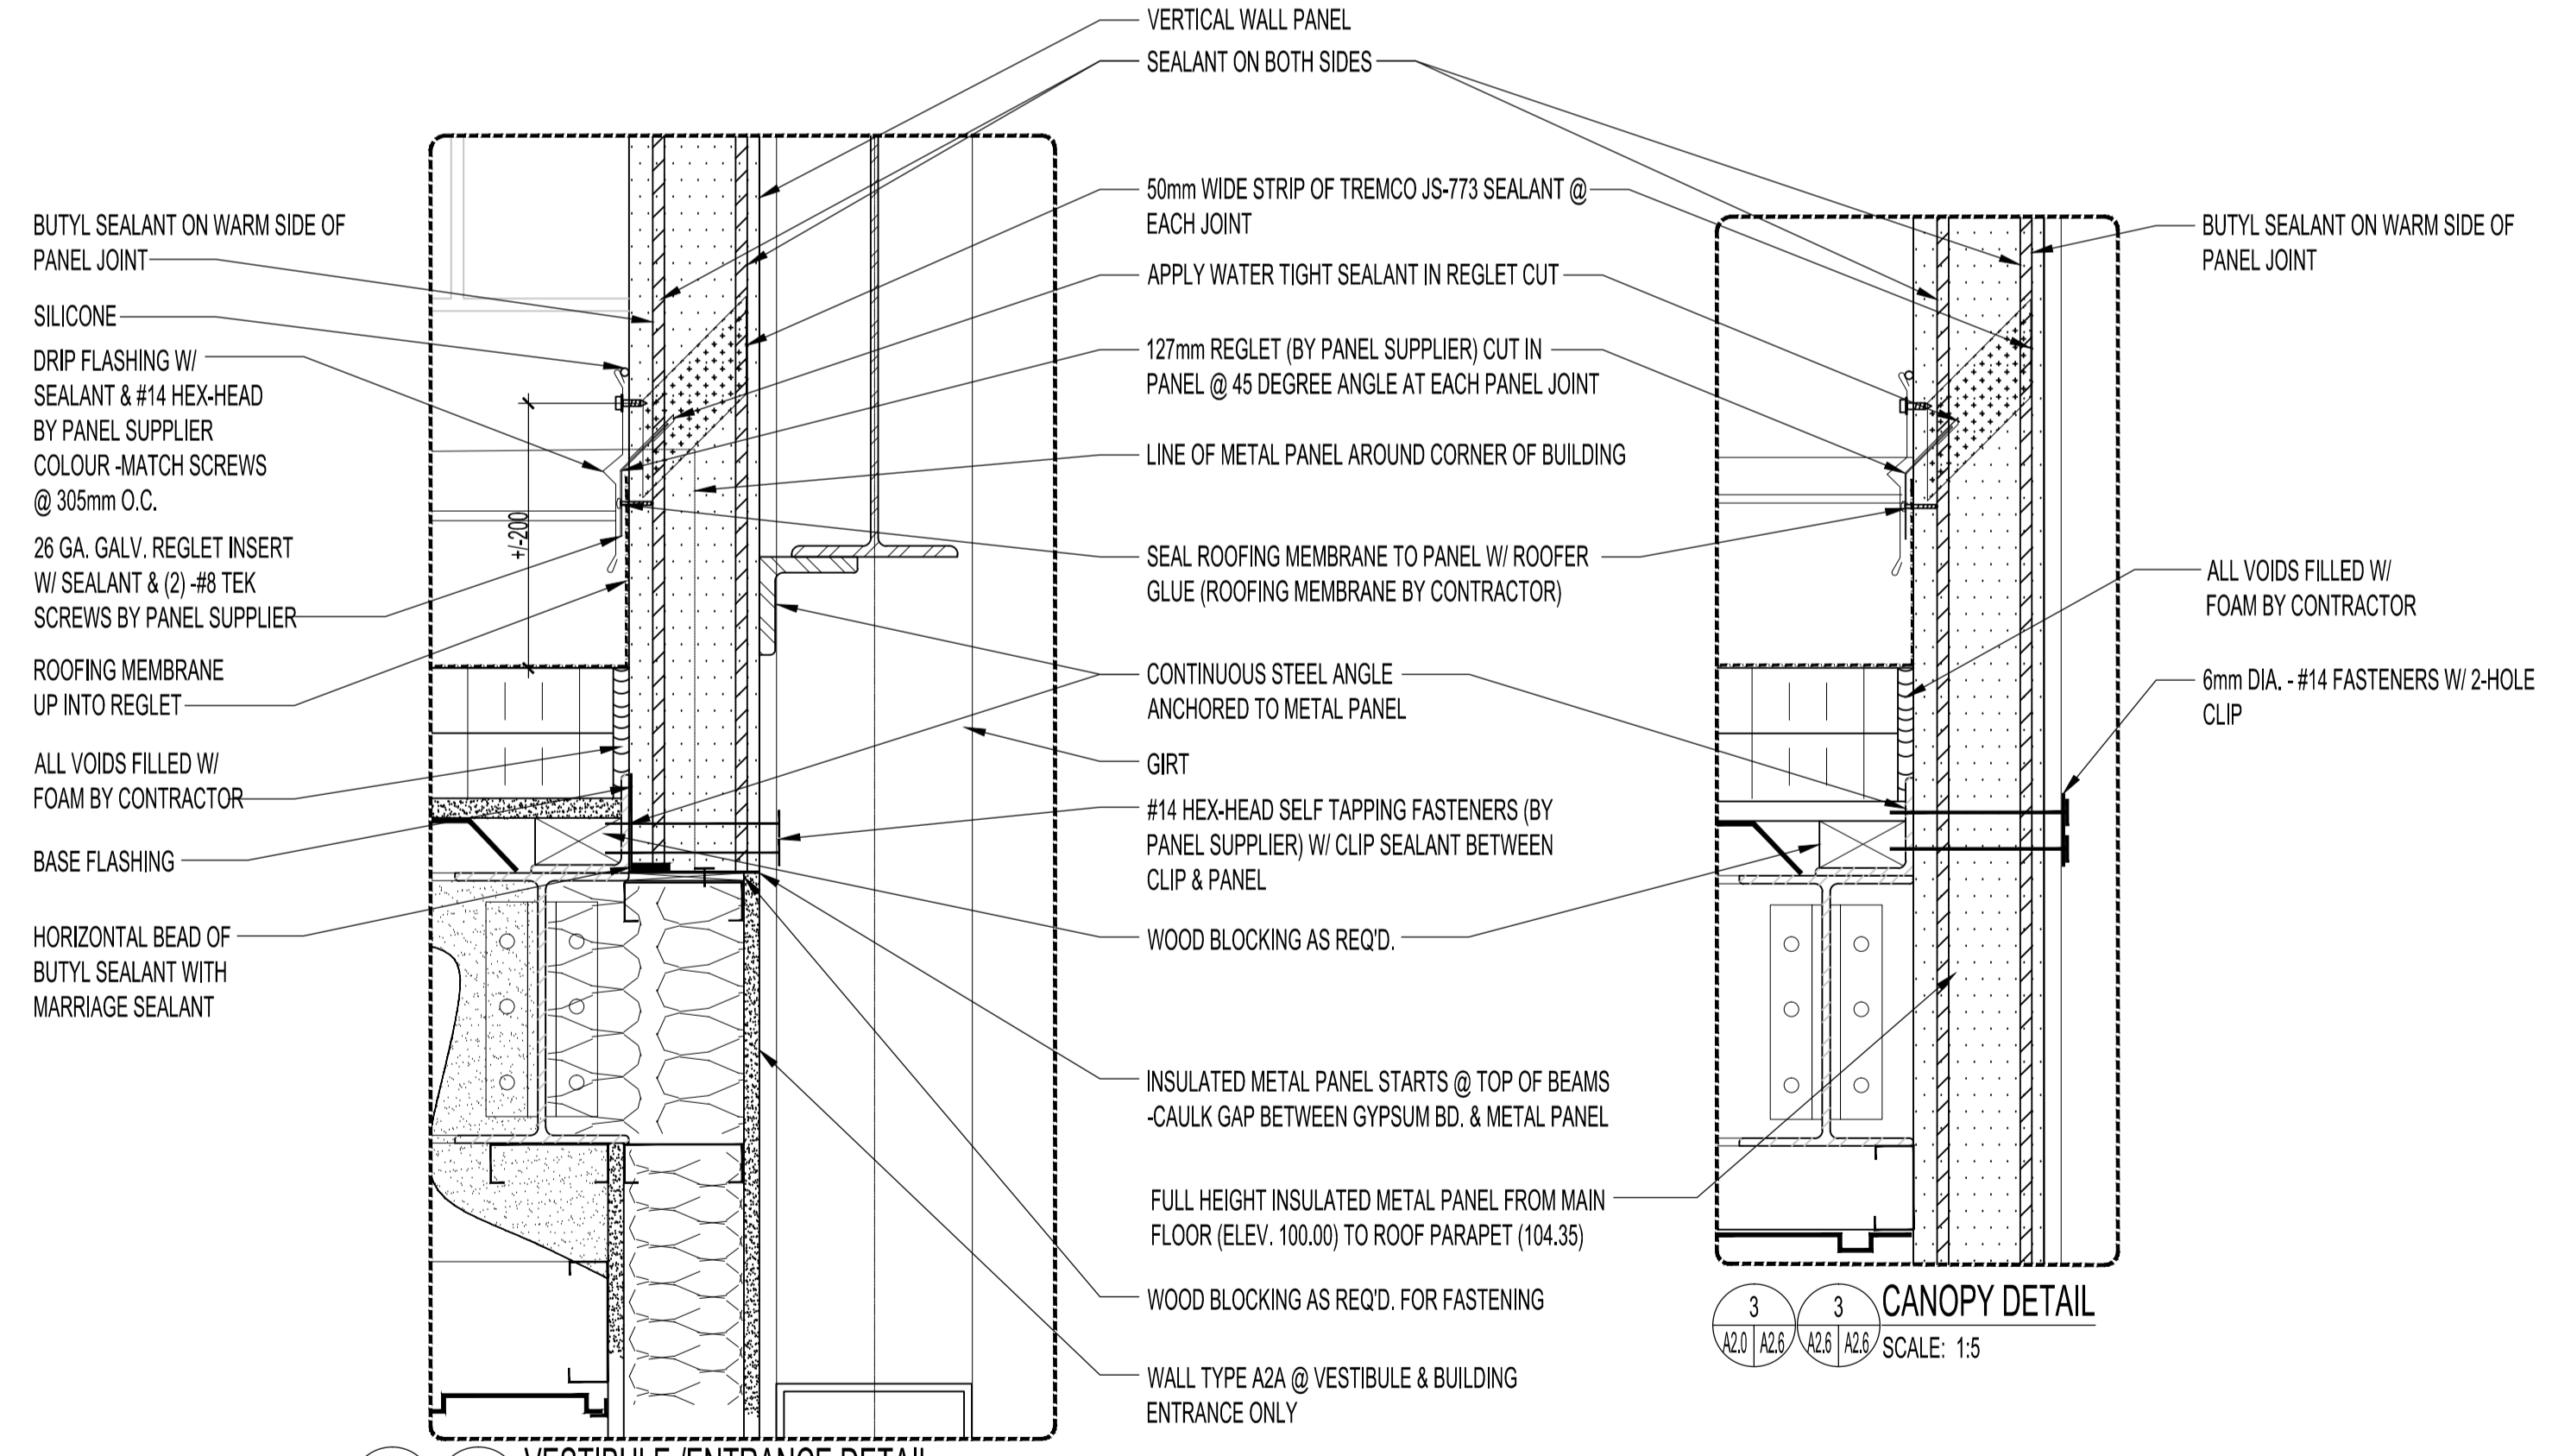

2 VESTIBULE ENTRANCE DETAIL
SCALE: 1:5

3 CANOPY DETAIL
SCALE: 1:5

COMPOSITE PANEL NOTES:
 MANUFACTURER: ALPOLIC, AS MANUFACTURED BY MITSUBISHI PLASTICS COMPOSITES AMERICA, INC. REYNOBOND, AS MANUFACTURED BY ALCOA ARCHITECTURAL PRODUCTS
 MATERIAL: 4MM, THERMOPLASTIC RESIN CORE - 'PE' CORE.
 FINISH: PREFINISHED SHEET WITH FACTORY APPLIED 2-COAT PAINT FINISH.
 COLOR: 2-COAT SOLID/MICA COLORS

SOFFIT PANEL NOTES:
 MANUFACTURER: AGWAY HF12-F - 22 GA.
 COLOR: WHITE

NOTES:

No.	REVISION/DESCRIPTION	BY	DATE
1	ISSUED FOR ADDENDUM #2	JAW	JUNE 15, 2017
0	ISSUED FOR CONSTRUCTION	MMK	MAR 17, 2017

ORIGINAL STAMPED BY: R. LI
 DATE: MARCH 20, 2017

DRAWN	CHECKED	DESIGNED	APPROVED
MMK			
DATE: 2016.08.30	USER APPROVAL		

THE CITY OF WINNIPEG
 PLANNING, PROPERTY AND
 DEVELOPMENT DEPARTMENT
 MUNICIPAL ACCOMMODATIONS DIVISION
 3-65 GARRY STREET, R3C 4K4

PROJECT
 BRADY ROAD LANDFILL
 ADMINISTRATION BUILDING
 DEVELOPMENT FOR BRADY LANDFILL
 1777 BRADY ROAD

SHEET TITLE
 VESTIBULE SECTION
 CANOPY DETAILS

SCALE	PROJECT No:	SHEET No:
AS SHOWN	2015-037	A2.6-R1