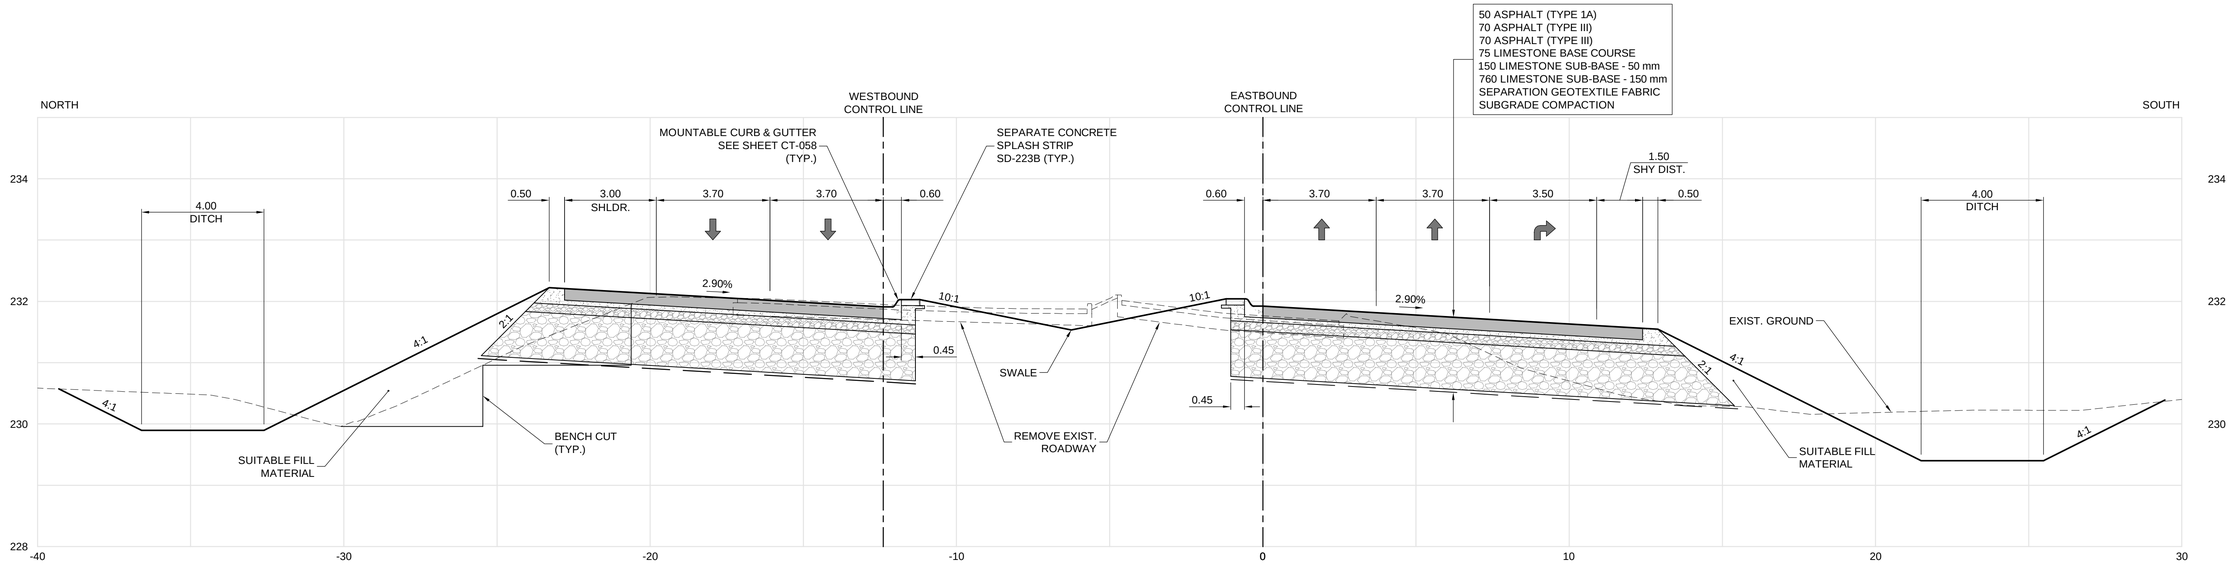

D CT-016 CT-053 FERMOR - STA: 4+570
SCALE: HORZ. 1:100 VERT. 1:50

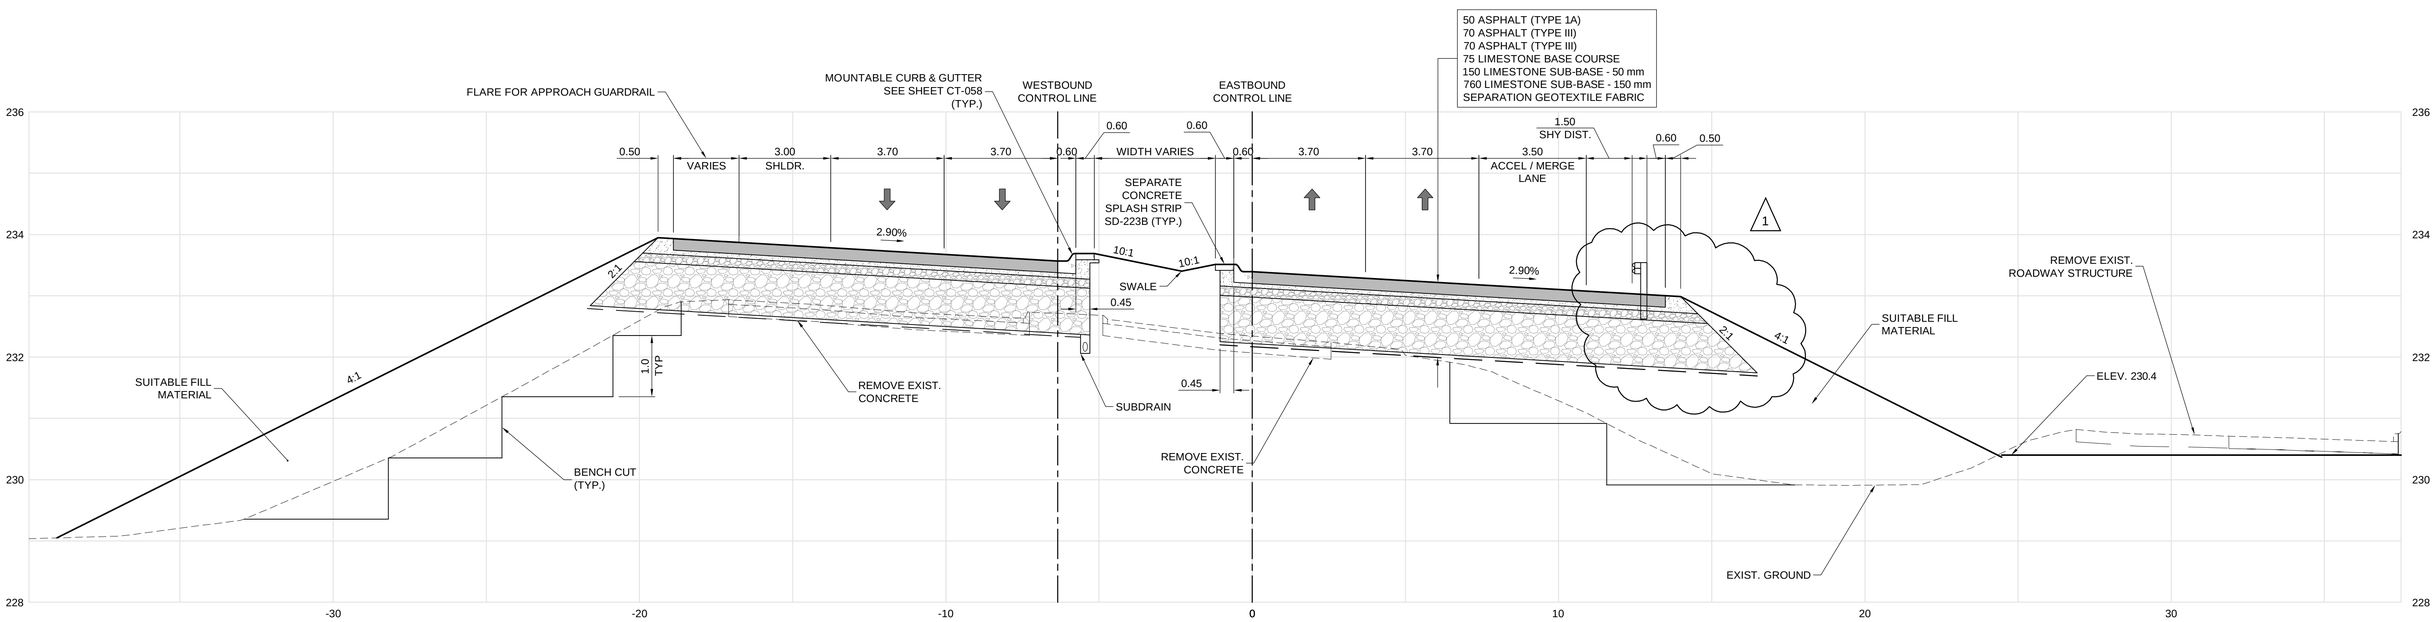

E CT-019 CT-053 FERMOR - STA: 4+805
SCALE: HORZ. 1:100 VERT. 1:50

APEGM
Certificate of Authorization
Dillon Consulting Limited (MB)
No. 1789 Date: 18/02/09

UNDERGROUND STRUCTURES

SUPV. U/G STRUCTURES — DATE

LOCATION OF UNDERGROUND STRUCTURES AS SHOWN ARE BASED ON THE BEST INFORMATION AVAILABLE, BUT NO GUARANTEE IS GIVEN THAT ALL EXISTING UTILITIES ARE SHOWN OR THAT THE GIVEN LOCATIONS ARE EXACT. CONFIRMATION OF EXISTENCE AND EXACT LOCATION OF ALL SERVICES MUST BE OBTAINED FROM THE INDIVIDUAL UTILITIES BEFORE PROCEEDING WITH CONSTRUCTION.

B.M. ELEV. SEE SHEET CT-001 FOR CONTROL POINT INFORMATION

NO.	REVISIONS	DATE	BY
1	ADDENDUM #5	18/03/16	JNC
0	ISSUED FOR TENDER	18/02/09	JNC

DESIGNED BY	JAT
DRAWN BY	PMW
CHECKED BY	JNC
APPROVED BY	JNC
HOR. SCALE	AS NOTED
VERTICAL	AS NOTED
DATE	

DILLON CONSULTING

RELEASED FOR CONSTRUCTION — DATE

ENGINEER'S SEAL: PROVINCE OF MANITOBA — J.N. CRANG — REGISTERED PROFESSIONAL ENGINEER

CONSULTANT PROJECT NUMBER: 17-5932

THE CITY OF WINNIPEG
PUBLIC WORKS DEPARTMENT

FERMOR AVENUE BRIDGE OVER SEINE RIVER
BRIDGE REHABILITATION, PEDESTRIAN-CYCLIST UNDERPASS STRUCTURE AND ROADWORKS FROM ST. ANNE'S ROAD TO ARCHIBALD STREET

CITY DRAWING NUMBER: P-3489-2017-CT-053
SHEET 053 OF 067

CROSS SECTIONS (2 OF 6)

CONSULTANT DRAWING NUMBER: CT-053

G:\CAD\175932\Drawings\Roadworks\Contract\175932-CON-CT-SECTIONS.dwg