


**F FERMO - STA: 4+900**  
 SCALE: HORZ. 1:100 VERT. 1:50

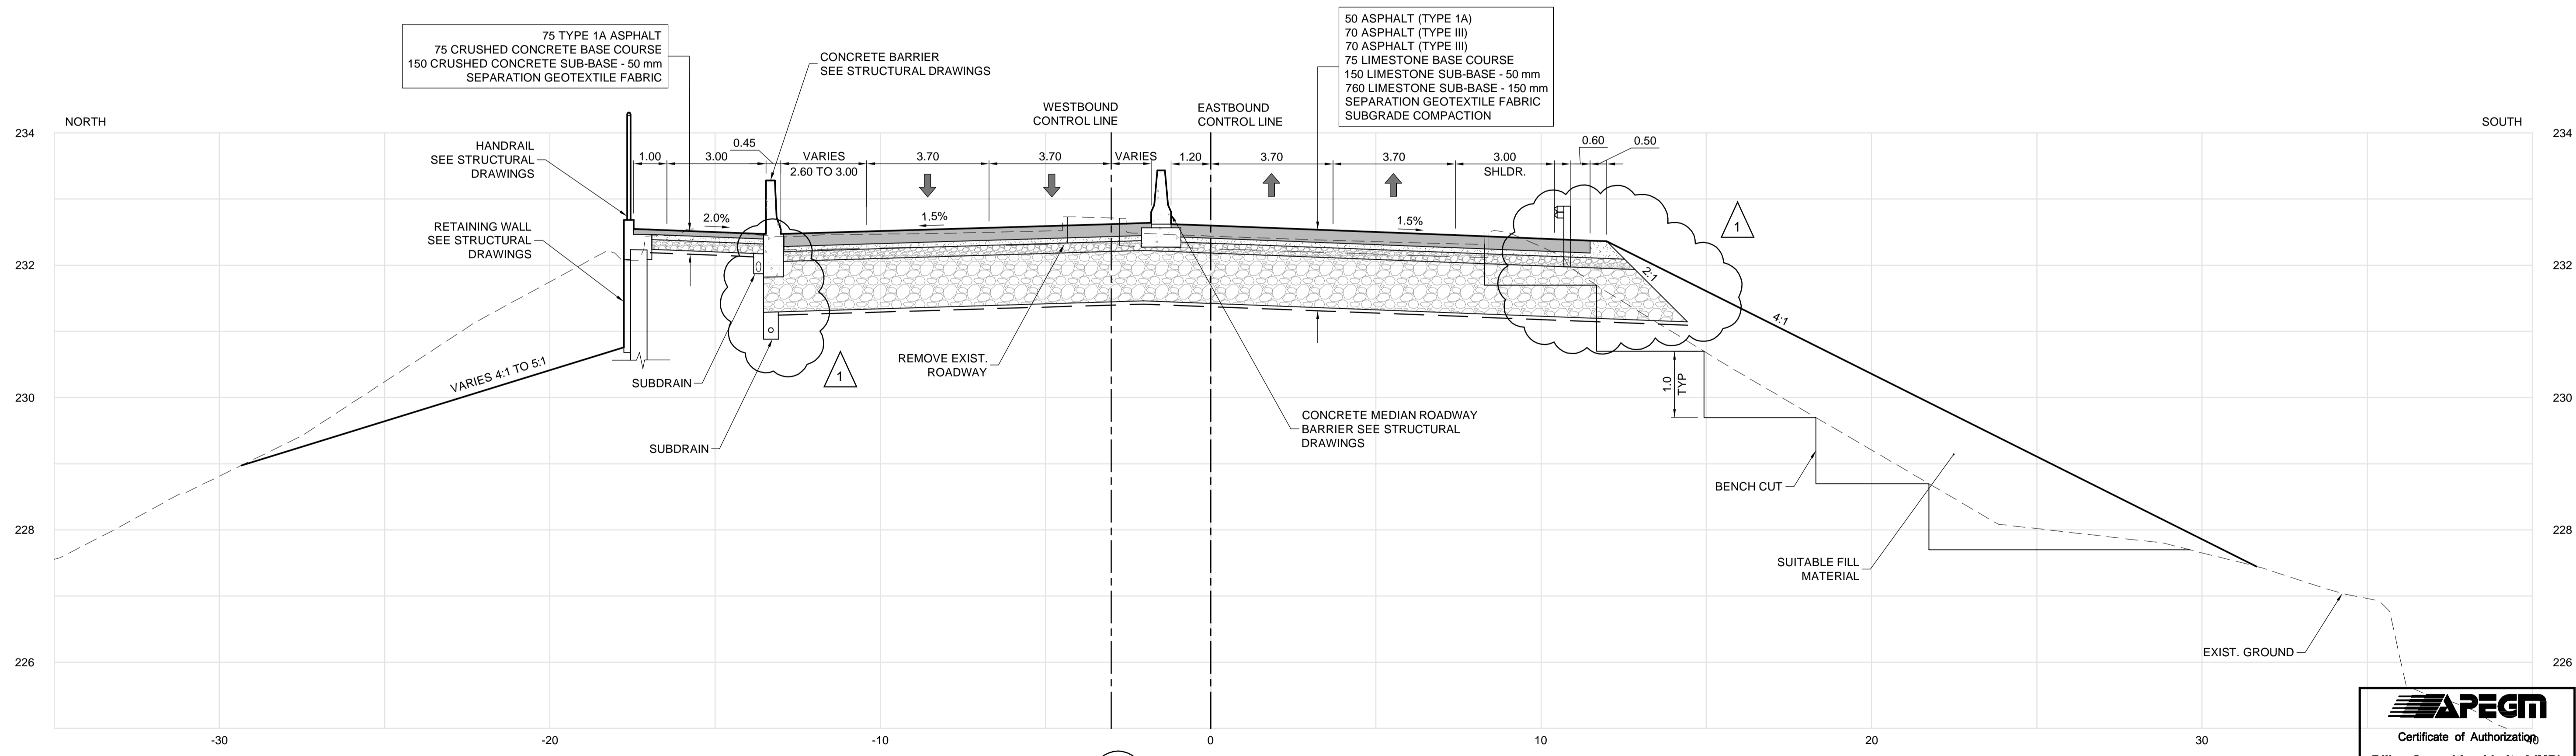

**G FERMO - STA: 4+970**  
 SCALE: HORZ. 1:100 VERT. 1:50

**APEGN**  
 Certificate of Authorization  
**Dillon Consulting Limited (MB)**  
 No. 1789 Date: 18/02/09

UNDERGROUND STRUCTURES	
SUPV. U/G STRUCTURES	DATE

LOCATION OF UNDERGROUND STRUCTURES AS SHOWN ARE BASED ON THE BEST INFORMATION AVAILABLE, BUT NO GUARANTEE IS GIVEN THAT ALL EXISTING UTILITIES ARE SHOWN OR THAT THE GIVEN LOCATIONS ARE EXACT. CONFIRMATION OF EXISTENCE AND EXACT LOCATION OF ALL SERVICES MUST BE OBTAINED FROM THE INDIVIDUAL UTILITIES BEFORE PROCEEDING WITH CONSTRUCTION.

B.M. ELEV.	SEE SHEET CT-001 FOR CONTROL POINT INFORMATION

DESIGNED BY	JAT
DRAWN BY	PMW
CHECKED BY	JNC
APPROVED BY	JNC
HOR. SCALE	AS NOTED
VERTICAL	AS NOTED

**DILLON CONSULTING**

RELEASED FOR CONSTRUCTION

DATE

ENGINEER'S SEAL

PROVINCE OF MANITOBA

**J.N. CRANG**

REGISTERED PROFESSIONAL ENGINEER

CONSULTANT PROJECT NUMBER

17-5932

**THE CITY OF WINNIPEG**  
 PUBLIC WORKS DEPARTMENT

**Winnipeg**

**FERMO AVENUE BRIDGE OVER SEINE RIVER**  
 BRIDGE REHABILITATION, PEDESTRIAN-CYCLIST UNDERPASS STRUCTURE AND ROADWORKS FROM ST. ANNE'S ROAD TO ARCHIBALD STREET

CITY DRAWING NUMBER  
 P-3489-2017-CT-054

SHEET  
 054 OF 067

CONSULTANT DRAWING NUMBER  
 CT-054

CROSS SECTIONS (3 OF 6)

G:\CAD\175932\Drawings\Roadworks\Contract\175932-CO-CT-SECTIONS.dwg