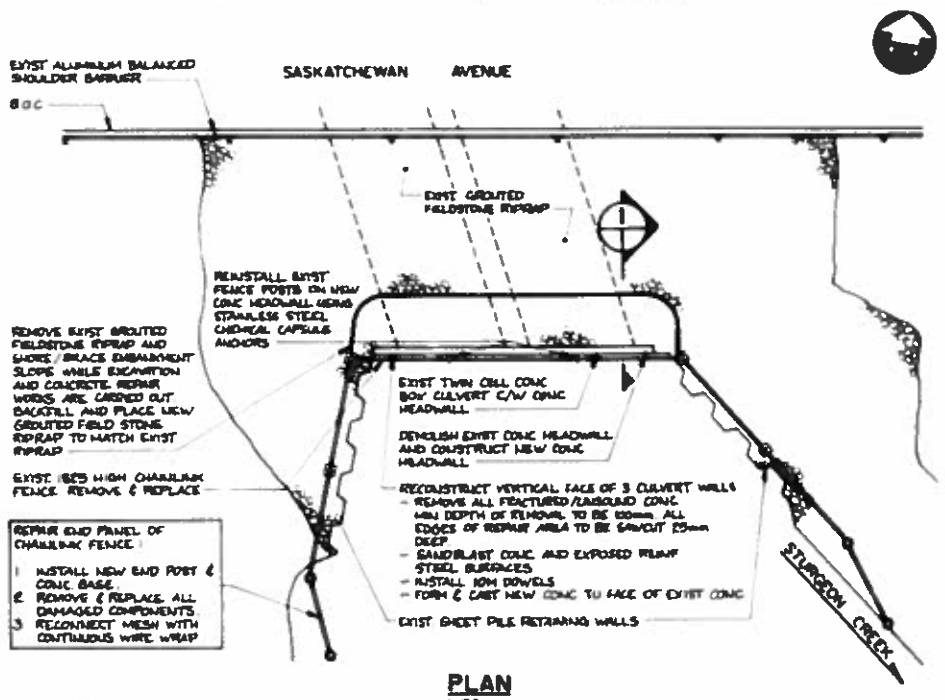

PLAN
N.T.S.

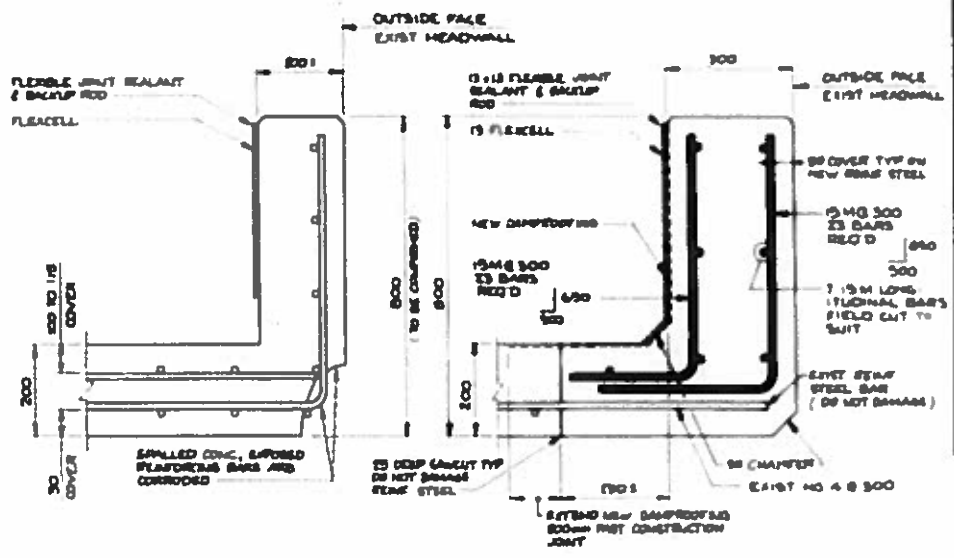

SECTION 2
1:15

LOCATION PLAN

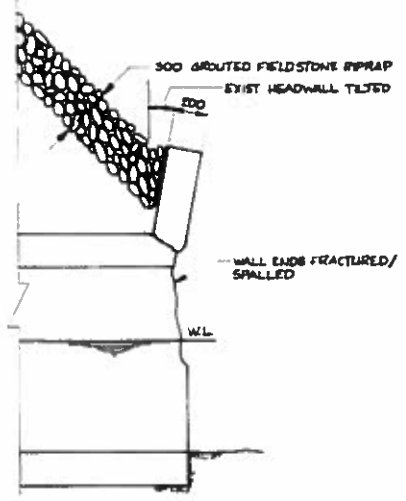

EXISTING

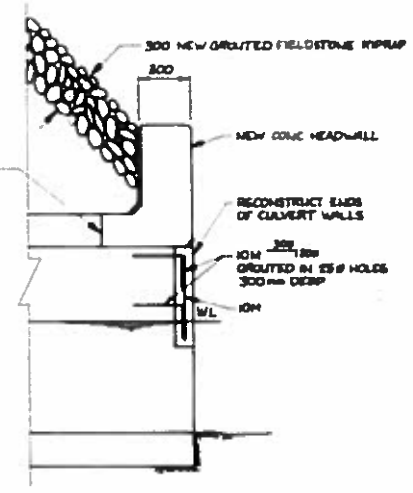

PROPOSED

SECTION 1
1:20

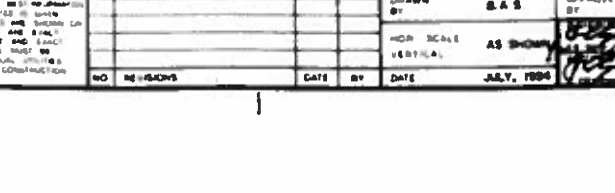

EXISTING HEADWALL POST BRACKET DETAIL
1:4

END POST INSTALLATION DETAIL
1:15

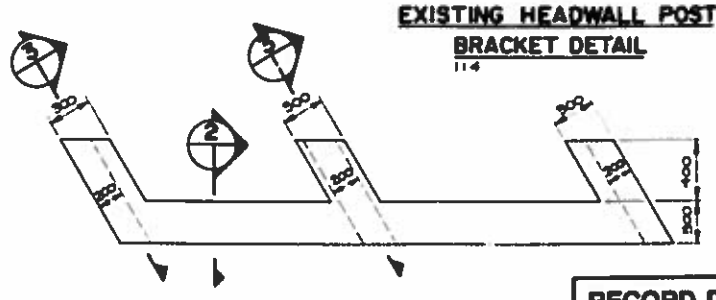

HEADWALL REPAIR PLAN
N.T.S.

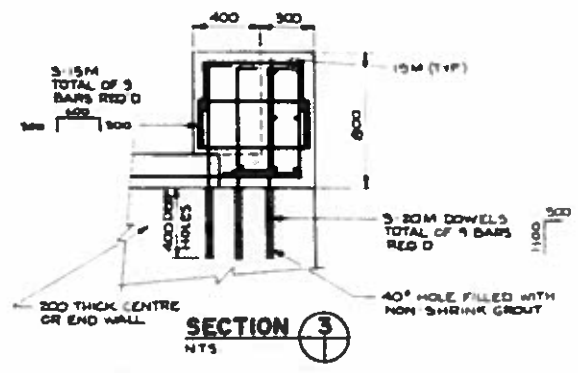

SECTION 3
N.T.S.

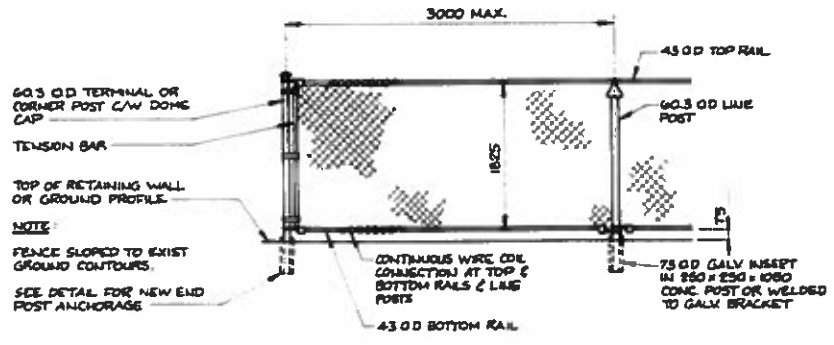

EXISTING CHAINLINK FENCE DETAIL
N.T.S.

RECORD DRAWING
M. Chislett 95-03-06

LOCATION APPROVED
UNDERGROUND STRUCTURES
N/A
SUPV. U/G STRUCTURES — DATE
COMMITTEE

NOTE

NO	REVISIONS	DATE	BY

DILLON
Consulting Engineers • Planners
Environmental Scientists

DESIGNED BY	M C	CHECKED BY	M C
DRAWN BY	B A S	APPROVED BY	
HOR. SCALE (VERTICAL)	AS SHOWN		
DATE	JULY, 1994		

M. B. CHISLETT 94 07 28 — PROFESSIONAL ENGINEER — PROVINCE OF MANITOBA

CONSULTANT DRAWING NO.

MMD 94-1909-01-01

THE CITY OF WINNIPEG
WORKS AND OPERATIONS DIVISION
STREETS AND TRANSPORTATION DEPARTMENT

1994 BRIDGE MAINTENANCE MISCELLANEOUS CONC. REHABILITATION WORKS	C309-94-01
SASKATCHEWAN AVE. CULVERT AT STURGEON CREEK CONC. HEADWALL & CHAINLINK FENCE REPAIRS	B-5961-1