The City of Winnipeg Appendix D RFP No. 963-2017

Template Version: SrC120171218 - Consulting Services RFP

APPENDIX D - ASBESTOS INVENTORY CONTROL – 25 POSEIDON BAY, THE CITY OF WINNIPEG, OCTOBER 6, 2016

## **ASBESTOS INVENTORY CONTROL**



Planning, Property and Development Department Municipal Accommodations Division 4th Floor - 185 King Street • Winnipeg, MB • R3B 1J1

Building Name:	Pan Am Pool - Building	Inspection Date:	October 6, 2016
Building Code:	PI-13	Inspected By:	Ryan Matthews
Building Address:	25 Poseidon Bay	Construction Date:	1967

·			Material	
Material Location	Material Description	Label	Condition	
	All Plaster Walls & Ceilings Contain Asbestos		Good	
	All pre existing door jams are insulated with asbestos		Good	
	containing insulation.		0000	
Basement				
	All ACM from Pre-2016 Boilers Removed Prior to Demolition.			
Boiler Room	Duct Insulation	DI	Good	
	Pipe Fitting Insulation	PF	Good	
	Pipe Insulation	PI	Good	
	Pipe Insulation Yellow	PI	Good	
	Boiler Tanks Inspections Holes	TI	Removed/16	
	Tank Insulation ( Hot Water Tanks )	TI	Removed /11	
	Tank Gasket	TI	Removed/16	
	Valve - Strainer Gasket	GA	Removed/16	
	Duct Insulation (Breeching Wrap)	DI	Removed/16	
	Transite Pipe	TP	Good	
Boiler Tank No.1	Boiler Tanks Inspections Holes (hand holes)	TI*	Removed/16	
	Burner Cap - Rope Gasket at gas valve	GA	Removed2/16	
	Burner Cap - Rope Gasket at converter oil valve	GA	Removed/16	
	Burner Cap - Cementitious material		Removed/16	
	Mortar, Gasket Seal and Firebrick (on both doors)		Removed/16	
North Stairwell	Drain Pipe Elbow Insulation	PF	Removed/16	
Communication Room	9x9 Floor Tile	F9	Removed /13	
Pool Engineers Office	Plaster - Ceiling	PL	Good	
Main Floor	All Plaster Walls & Ceilings Contain Asbestos			
Men's Washroom/ Locker Room	Pipe Fitting Insulation	PF	Good	
	Plaster - Ceiling	PL	Good	
Men's Showers	Plaster - Ceiling	PL	Removed/16	

Testing	Date	Test	Est.
Status	M/Y	<b>%</b> 1-10	%
TESTED		1-10	
TESTED	May'12	20	
TESTED		40-50	
TESTED		20-50	
TESTED	Jan/'11	65-80	
TESTED	Aug/11	3-40	
TESTED	Dec/11	60-75	
TESTED	Aug/11	0	
TESTED	Feb'16	75	
TESTED	Apr/'16	85	
TESTED	Feb'16	25	
TESTED	Feb'16	75	
			75
TESTED	Feb'16	0	
TESTED	Feb'16	0	
TESTED		0	
			1-10
			1-10
			1-10

			Material	
Material Location	Material Description	Label	Condition	
North Stairwell	Plaster - Ceiling	PL	Good	
	Plaster - Walls	PL	Good	
Women's Washroom/Locker Room	Pipe Fitting Insulation (Inside Of North Wall)	PF	Good	
	Plaster - Ceiling	PL	Good	
Women's Showers	Plaster - Ceiling	PL	Removed	
South Stairwell	Plaster - Ceiling	PL	Good	
	Plaster - Walls	PL	Good	
South Pool Room	Pipe Fitting Insulation	PF	Good	
Second Floor				
Track Exterior Walls/ Elevator				
Wall	Plaster Walls encapsulated behind retrofitted stucco wall		Good	
Under South Bleachers	All Plaster Walls & Ceilings Contain Asbestos			
West Mechanical Area	Spray On Insulation	SO	Removed	
	Pipe Fitting Insulation	PF	Good	
	Pipe Mastic	MA	Good	
	Mastic - Duct	MA	Good	
	Plaster - Walls	PL	Good	
Canteen & Washrooms	Plaster - Ceiling	PL	Good	
	Plaster - Walls	PL	Good	
Centre Mechanical Area	Spray On Insulation	SO	Removed	
	Pipe Fitting Insulation	PF	Good	
	Pipe Mastic	MA	Good	
	Plaster - Walls	PL	Good	
East Mechanical Area	Spray On Insulation	SO	Removed	
	Pipe Fitting Insulation	PF	Good	
	Pipe Mastic	MA	Good	
	Plaster - Walls	PL	Good	
South Bleachers Attic Area	Spray On Insulation	SO	Removed	
	Pipe Fitting Insulation	PF	Removed	
Top Of Bleachers				
Stairways and Back Walls	Plaster - Walls	PL	Good	

Testing	Date	Test	Est.
Status	M/Y	%	%
			1-10
			1-10
			1-10
			1-10
			1-10
	_		
			1-10
			1-10
			20-40
			10
TESTED	Feb/'12	10	
			1-10
			1-10
			1-10
		20-40	
			10
			1-10
TESTED		50-60	
			10
			1-10
			-
			1-10
		-	

			Material
Material Location	Material Description	Label	Condition
Storage Room	Plaster - Walls	PL	Good
	Plaster - Ceiling	PL	Good
Under North Bleachers	All Plaster Walls & Ceilings Contain Asbestos		
West Mechanical Area	Spray On Insulation	SO	Removed
	Pipe Fitting Insulation	PF	Removed
	Pipe Mastic	MA	Good
	Plaster - Walls	PL	Good
Washrooms & Canteen	Plaster - Ceiling	PL	Good
	Plaster - Walls	PL	Good
Central Mechanical Area	Spray On Insulation	SO	Removed
	Pipe Fitting Insulation	PF	Good
	Pipe Mastic	MA	Good
	Plaster - Walls	PL	Good
East Mechanical Area	Plaster - Walls	PL	Good
	Spray On Insulation	SO	Removed
	Pipe Fitting Insulation	PF	Good
	Pipe Mastic	MA	Good
Offices	Plaster - Ceiling	PL	Good
	Plaster - Walls	PL	Good
	Sheet Flooring	FS	Good
Under North Bleachers Attic	Spray On Insulation	SO	Removed
	Pipe Fitting Insulation	PF	Removed
Top Of Bleachers			
Stairways and Back Walls	Plaster - Walls	PL	Good
Storage Room	Plaster - Ceiling	PL	Good
	Plaster - Walls	PL	Good
Catwalk Area			
	Duct Insulation (Black Mastic Only)	DI	Good
Southwest Air Handling Unit	Pipe Fitting Insulation	PF	Good
Northwest Air Handling Unit	Pipe Fitting Insulation	PF	Removed/16
Northeast Air Handling Unit	Pipe Fitting Insulation	PF	Good
Centre Fan Unit	Pipe Fitting Insulation	PF	Good
	Duct Insulation	DI	Good
30"Exhaust Pipe @ North East	Transite Pipe	TP	Good
30"Exhaust Pipe @ South East	Transite Pipe	TP	Good
Roof Drains	Transite Pipe	TP	Good


Testing	Date	Test	Est.
Status	M/Y	%	%
			1-10
			1-10
			10
			1-10
			1-10
			1-10
TESTED		40-50	
TESTED	Jan/'12	10	
			1-10
			1-10
			1-10
			40-50
			10
			1-10
			1-10
TESTED	Feb/'13	15	
			10
TESTED		15	
TESTED	Mar/'12	30-50	
			40-50
			40-50
			40-50
TESTED	Feb/'13	0	


		Drawing	Material	Testing	Date	Test	Est.
Material Location	Material Description	Label	Condition	Status	M/Y	%	%
Above Pool Area	Transite Ceiling Tile	С	Good	TESTED		30-50	
Roof							
30" Exhaust Pipe East End of Roof	Transite Pipe	TP	Good				
Exterior							
C O 2 Storage Room	Pipe Fitting Insulation	PF	Good				
	Stucco - Ceiling	ST	Good				
	Stucco - Walls	ST	Good				
Exterior: U/S of Cantilever	Stucco	ST	Good	TESTED	Apr'15	<1	


## **NOTES:**


- 2. There may be asbestos containing materials present that were not located during asbestos inspections.
- 2. There may be asbestos containing materials present that were not located during asbestos inspections.
- 3. Floor tile and sheet flooring installed before 1990 may contain asbestos and must be treated as an asbestos containing material.
- 4. Vermiculite insulation may contain pockets of asbestos. All vermiculite insulation must be treated as an asbestos containing material.
- 5. For asbestos related inquiries, call Central Control at 204-986-2382


**PI-13** 

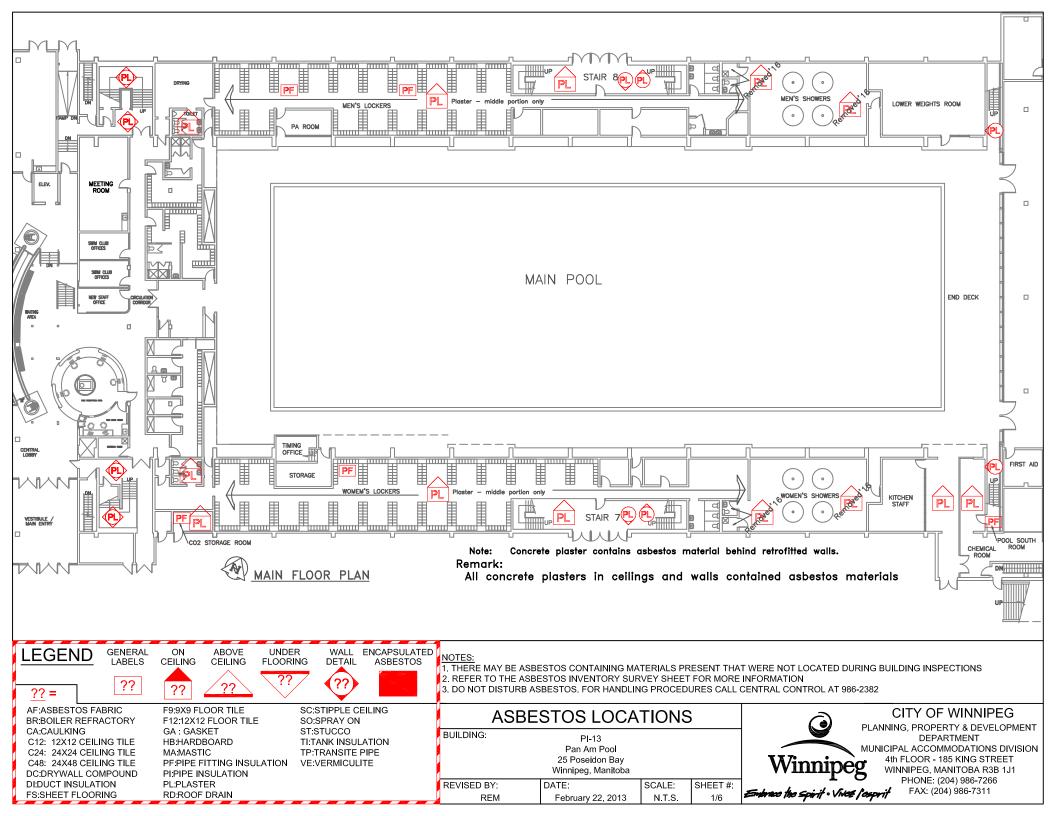

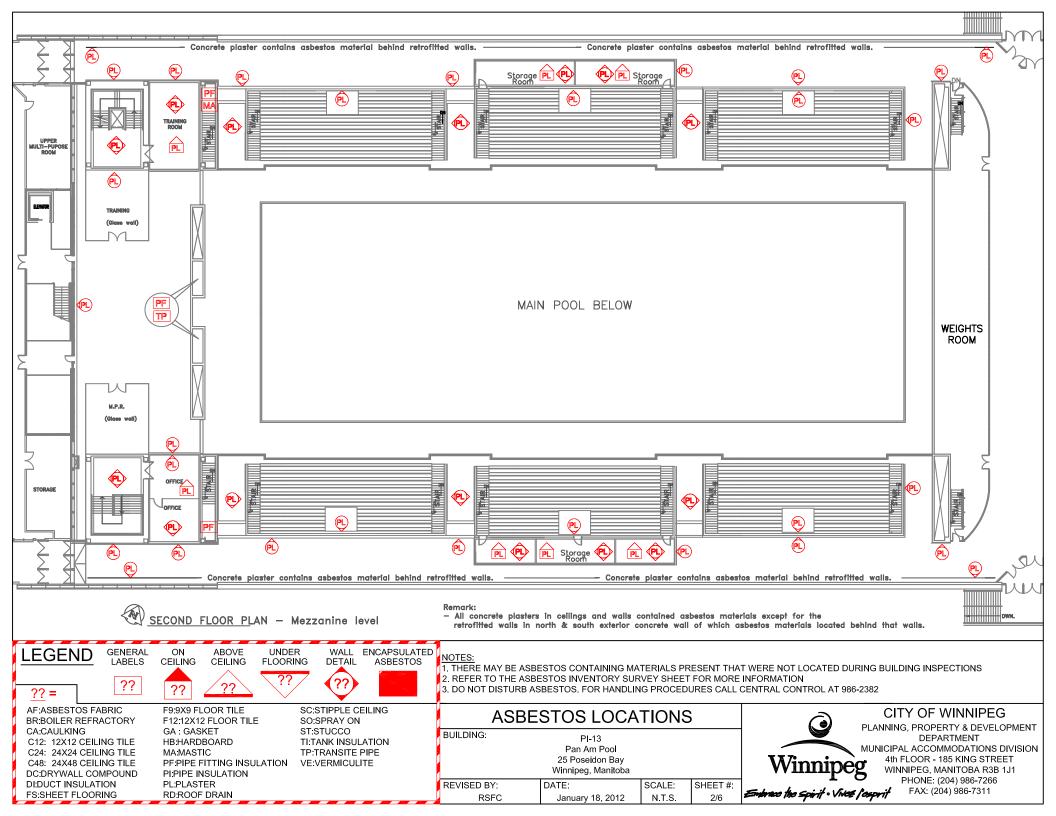

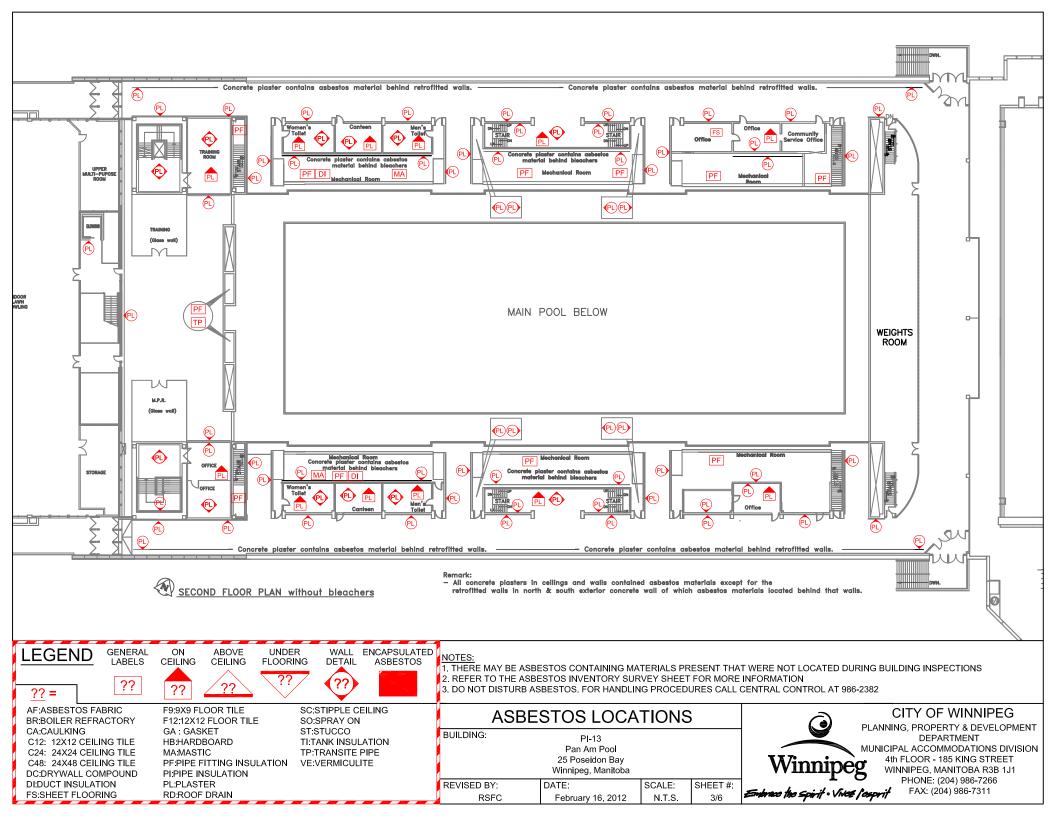

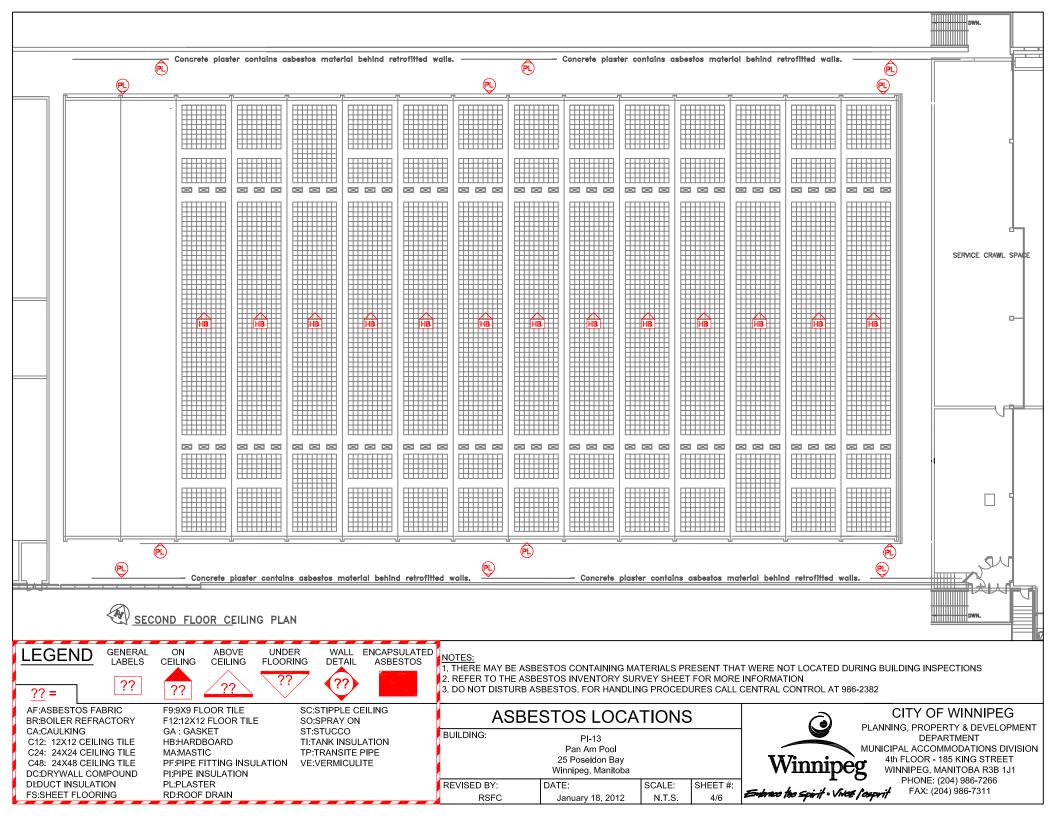

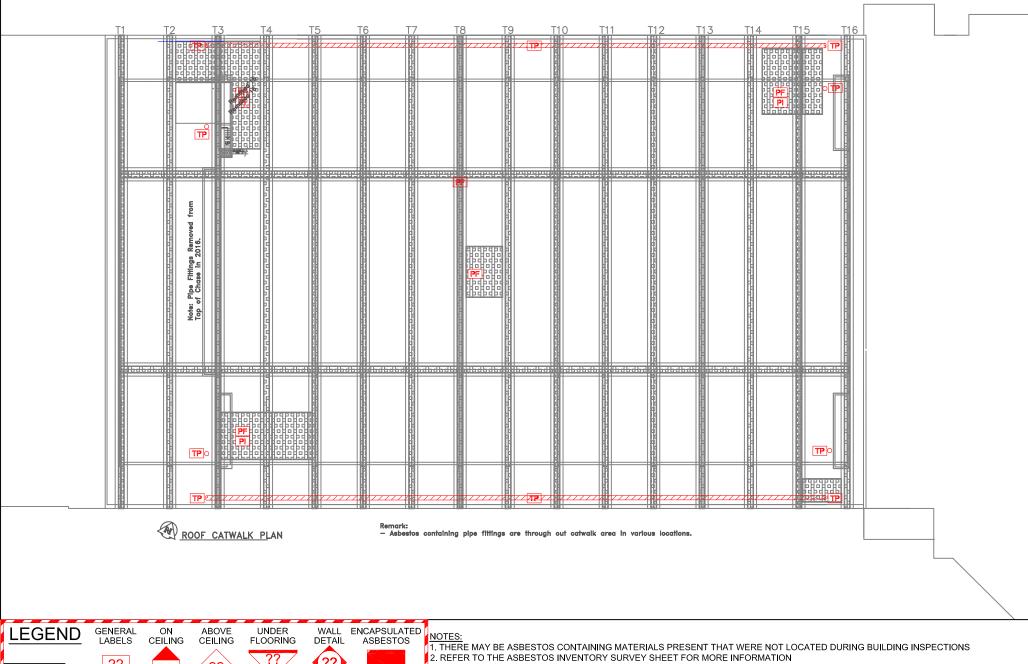



**GENERAL** LABELS

??

ON CEILING

**ABOVE** CEILING

UNDER **FLOORING**  WALL ENCAPSULATED

DETAIL **ASBESTOS** 

3. DO NOT DISTURB ASBESTOS. FOR HANDLING PROCEDURES CALL CENTRAL CONTROL AT 986-2382

AF:ASBESTOS FABRIC BR:BOILER REFRACTORY

CA:CAULKING C12: 12X12 CEILING TILE C24: 24X24 CEILING TILE C48: 24X48 CEILING TILE DC:DRYWALL COMPOUND DI:DUCT INSULATION **FS:SHEET FLOORING** 

F9:9X9 FLOOR TILE F12:12X12 FLOOR TILE GA: GASKET HB:HARDBOARD MA:MASTIC PF:PIPE FITTING INSULATION VE:VERMICULITE PI:PIPE INSULATION PL:PLASTER RD:ROOF DRAIN

SC:STIPPLE CEILING SO:SPRAY ON ST:STUCCO TI:TANK INSULATION TP:TRANSITE PIPE

## **ASBESTOS LOCATIONS**

BUILDING: PI-13 Pan Am Pool 25 Poseidon Bay

Winnipeg, Manitoba REVISED BY: SHEET #: DATE: SCALE: REM December 7, 2016 N.T.S.



## CITY OF WINNIPEG

PLANNING, PROPERTY & DEVELOPMENT DEPARTMENT MUNICIPAL ACCOMMODATIONS DIVISION 4th FLOOR - 185 KING STREET

WINNIPEG, MANITOBA R3B 1J1 PHONE: (204) 986-7266 FAX: (204) 986-7311

