


Owner
City of Winnipeg

Rev. No.	Date	Revision Notes
1.	2017.11.28	Issued for Construction
2.	2018.01.30	Issued for Addendum 3

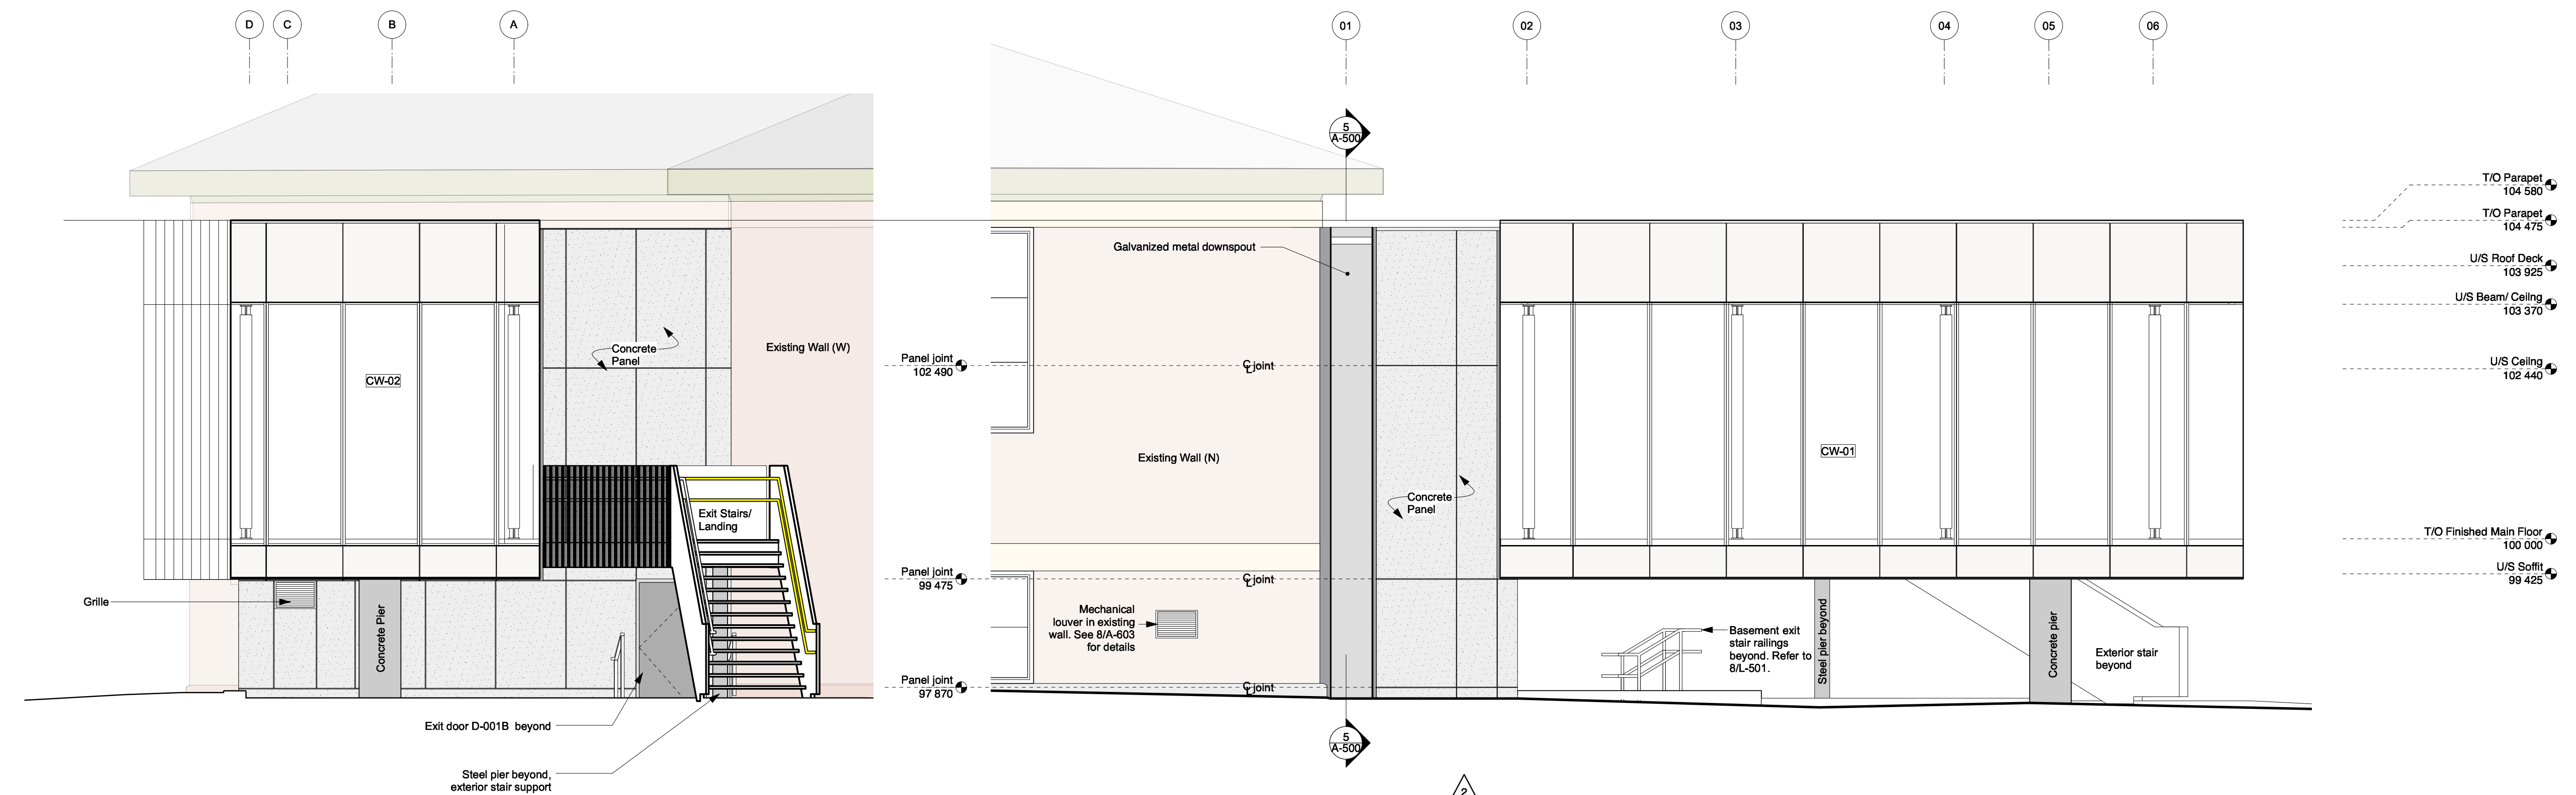


2 West Exterior Elevation
Scale: 1:50
A-400

1 North Exterior Elevation
Scale: 1:50
A-400




5 East Exterior Elevation
Scale: 1:50
A-400

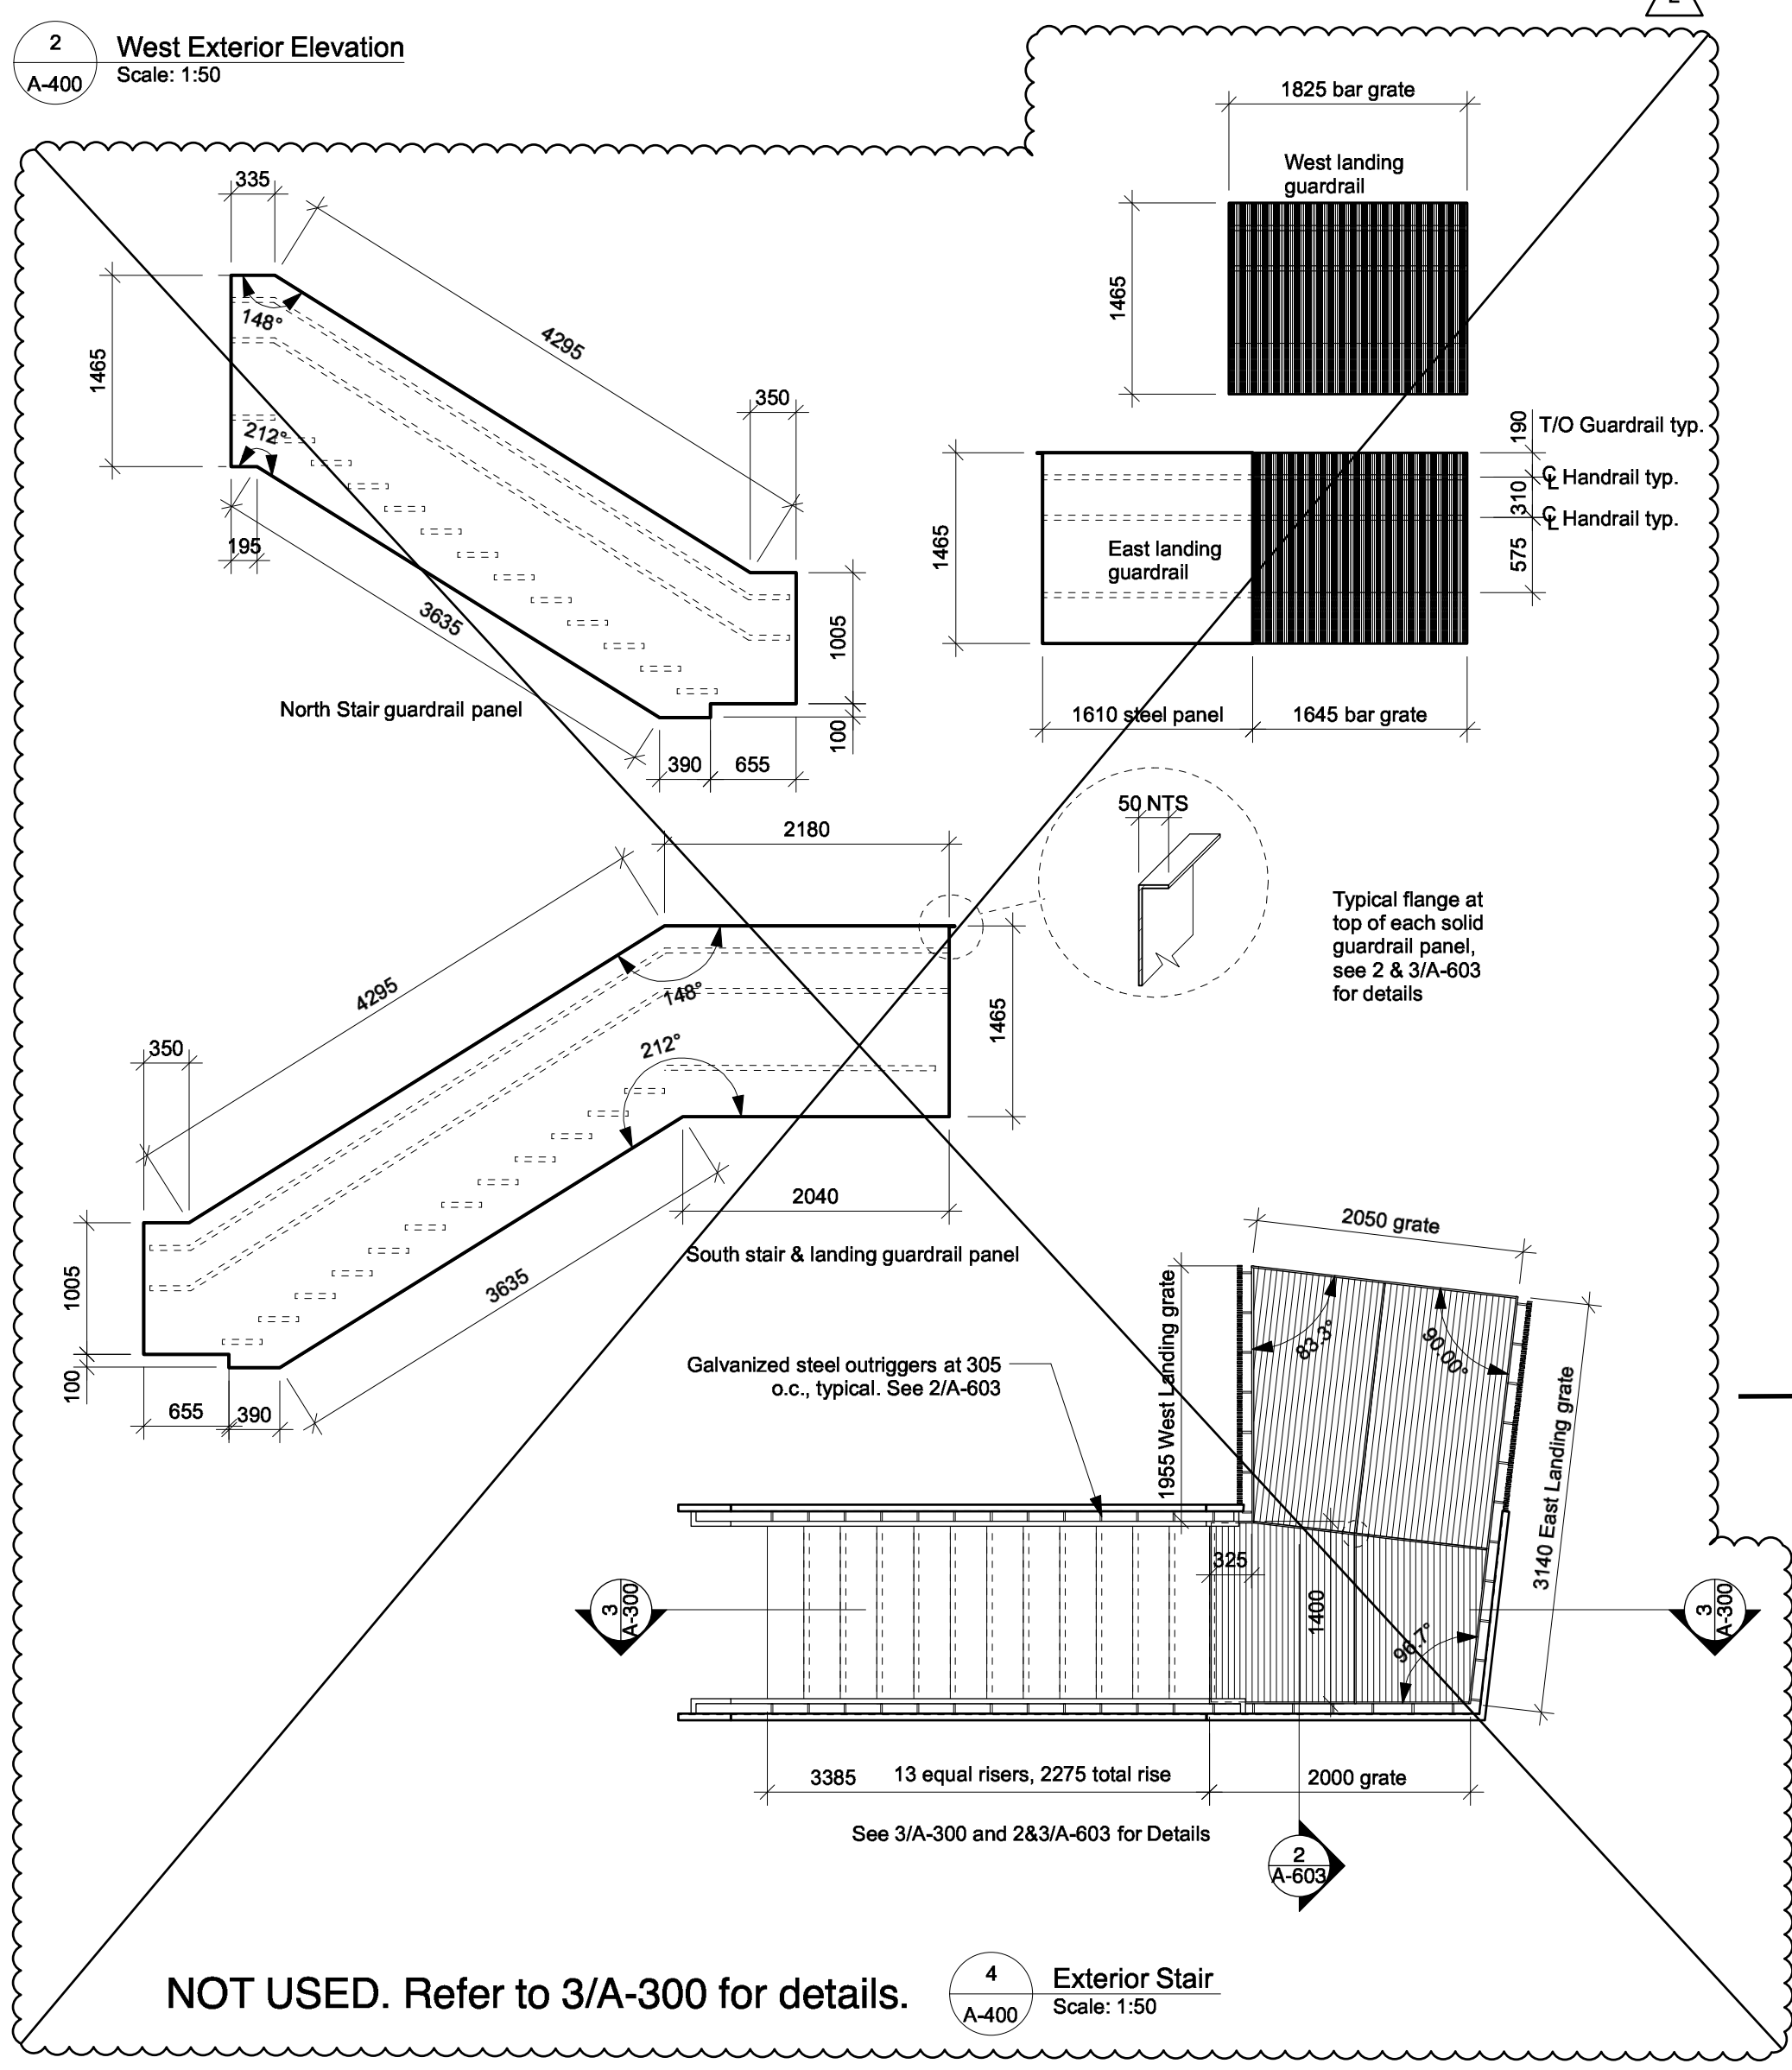


4 Exterior Stair
Scale: 1:50
A-400

NOT USED. Refer to 3/A-300 for details.

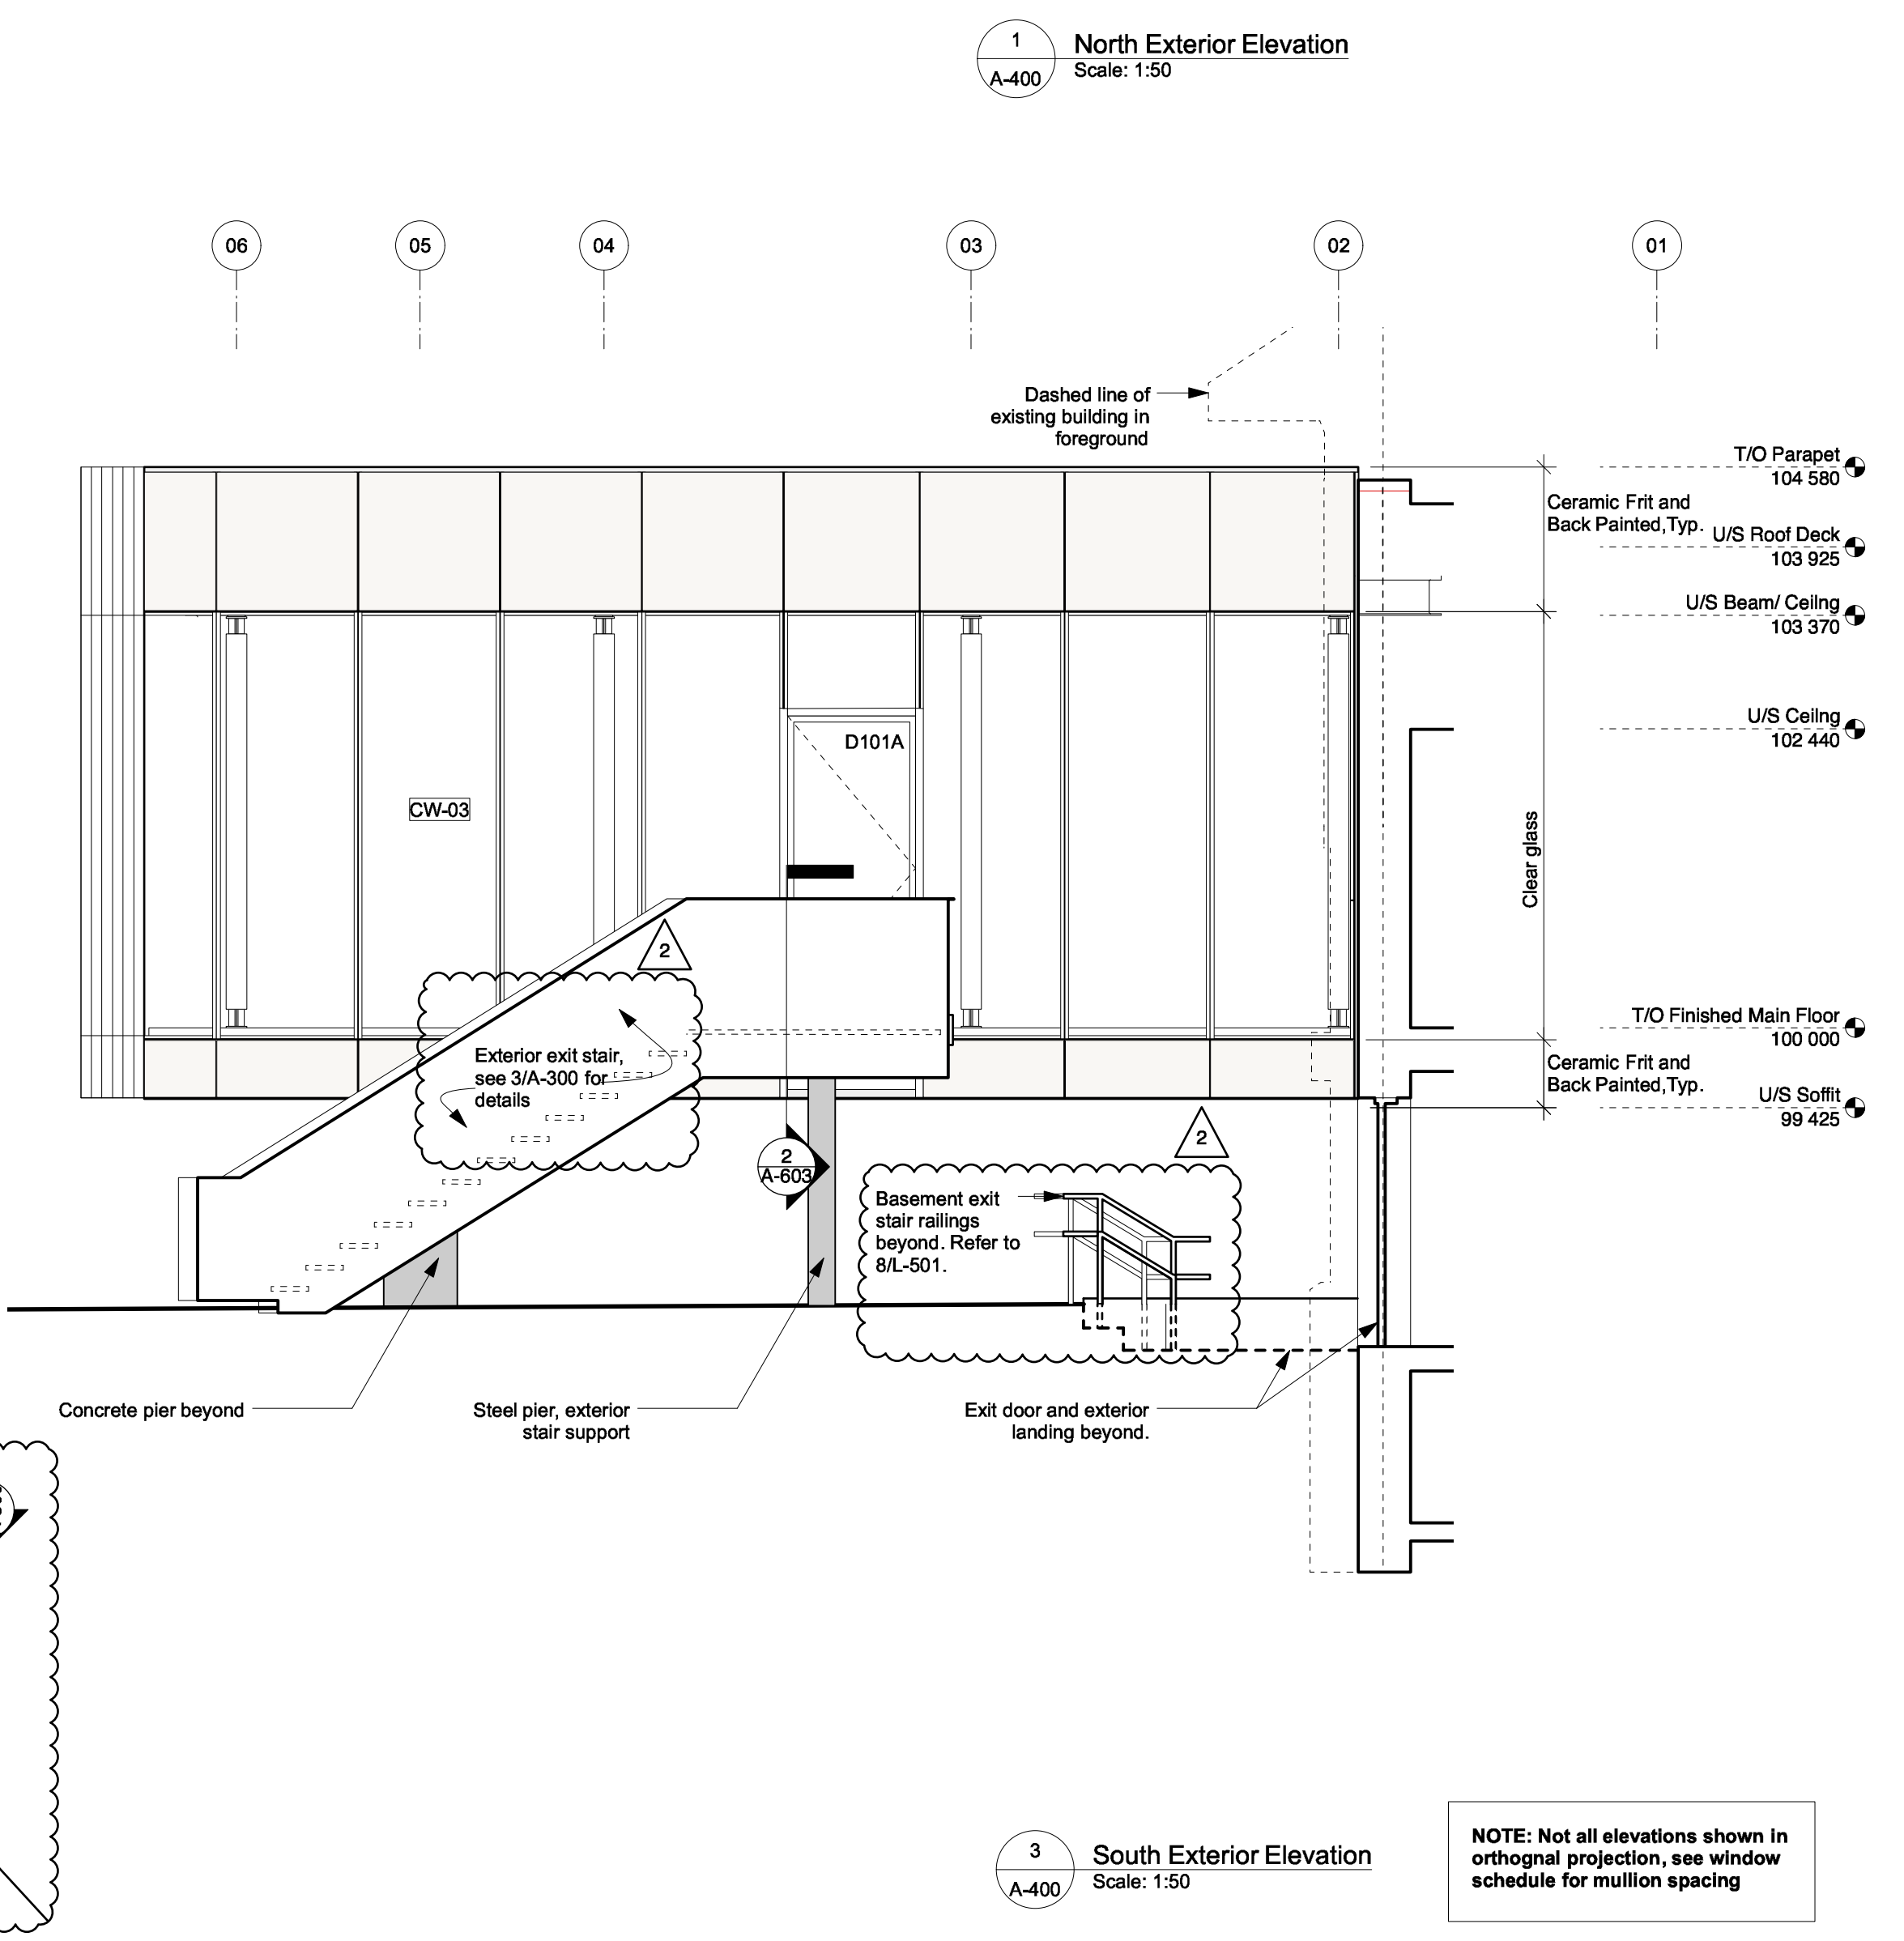

3 South Exterior Elevation
Scale: 1:50
A-400

NOTE: Not all elevations shown in orthogral projection, see window schedule for mullion spacing

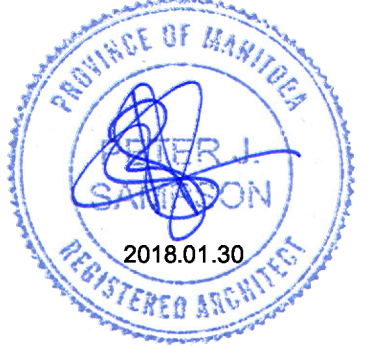

This drawing must not be scaled. The contractor shall verify all dimensions and other data on site prior to commencement of work. Discrepancies, errors, and omissions are to be reported to Public City Architecture Inc. prior to proceeding with the Work.

Drawings and specifications as instruments of service are the property of Public City Architecture Inc. and when made, must bear their name. All prints to be returned to Public City Architecture Inc. upon request.

Project
Cornish Library Renovation

Drawing
Exterior Elevations

Drawn By
DB
Scale
As Noted

Reviewed By
PS
Drawing No.
A-400

Date
2016.07.18

Project No.
1503a