ASBESTOS INVENTORY CONTROL



Planning, Property and Development Department Municipal Accommodations Division 4th Floor - 185 King Street • Winnipeg, MB • R3B 1J1

Building Name:	St James Civic Centre (Also see PI-05 & AR-03)	Inspection Date:	April 29, 2015
Building Code:	RC-22	Inspected By:	Ryan Matthews & James Neufeld
Building Address:	2055 Ness Avenue	Construction Date:	1965

		Drawing	Material	
Material Location	Material Description	Label	Condition	
Main Floor				
Reception Area	9x9 Floor Tile	F9	Removed	
Reception Storage Rm	9x9 Floor Tile	F9	Good	
Concession	Pipe Fitting Insulation - Above Ceiling	PF	Good	
	9x9 Floor Tile	F9	Removed	
Staff Lunchroom Hallway	12x12 Floor Tile	F12	Good	
Staff Lunchroom	12x12 Floor Tile	F12	Good	
Staff Hallway	9x9 Floor Tile	F9	Good	
Cloak room	9x9 Floor Tile	F9	Good	
Auditorium	9x9 Floor Tile (Mastic)	F9	Good	
Additionalli	Spray On Insulation	SO	Good	
Mens washroom	9x9 Floor Tile	F9	Good	
Women's washroom	9x9 Floor Tile	F9	Good	
Kitchen	9x9 Floor Tile	F9	Good	
Storage hallway	12x12 Floor Tile			
Custodian room	12x12 Floor Tile			
Storage rooms x 3	9x9 Floor Tile	F9	Needs Repair	
North & South stage stairs	9x9 Floor Tile	F9	Good	
South Stage wall	Stucco - Walls	ST	Good	
Storage washrooms x 2	9x9 Floor Tile	F9	Good	
East stairwall up to second fir	9x9 Floor Tile	F9	Good	
East stairwell up to second flr	Pipe Fitting Insulation	PF	Good	
Second Floor				
East stairwell landing	9x9 Floor Tile	F9	Good	
	Stair Tread/ Nosing			
Office hallway	9x9 Floor Tile	F9	Good	
Office #1	9x9 Floor Tile	F9	Good	


Testing	Date	Test	Est.	
Status	M/Y	%	%	
TESTED	Apr'15	0%		
TESTED	May'14	5		
			-	
TESTED	Dec/'10	2-5		
TESTED	Dec/'10	0		
TESTED	Mar'14	0		
TESTED	Dec/'11	0		
IESIED	Dec/ 11	U		
TESTED	Dec/'10	Trace		
TESTED	Apr/'15	0%		
		0,0		

		Drawing	Material	Testing	Date	Test	Est.
Material Location	Material Description	Label	Condition	Status	M/Y	%	%
Office #2	9x9 Floor Tile	F9	Good				
Mezzanine area	9x9 Floor Tile	F9	Good				
Open office	9x9 Floor Tile - Under Carpet	F9	Good				
Conference room	9x9 Floor Tile - Under Carpet	F9	Good				
Men's washroom	12x12 Floor Tile	F12	Good				
Janitor's room	9x9 Floor Tile	F9	Good				
West stairwell landing	9x9 Floor Tile	F9	Needs Repair				
Women's washroom	12x12 Floor Tile	F12	Good				
Basement							
East stairwell	9x9 Floor Tile	F9	Good				
	Pipe Fitting Insulation	PF	Good				
	Pipe Insulation	PI	Good				
Meeting room	Pipe Fitting Insulation - Above Ceiling	PF	Good				
	12x12 Floor Tile - new						
	Pipe Insulation - Above Ceiling	PI	Good				
Storage room 1	no asbestos located						
Storage room 2	no asbestos located						
Storage room 3	no asbestos located						

NOTES:

- 1. Asbestos inspections and inventory updates are conducted annually.
- 2. There may be asbestos containing materials present that were not located during asbestos inspections.
- 3. Floor tile and sheet flooring installed before 1990 may contain asbestos and must be treated as an asbestos containing material.
- 4. Vermiculite insulation may contain pockets of asbestos. All vermiculite insulation must be treated as an asbestos containing material.
- 5. For asbestos related inquiries, call Central Control at 204-986-2382

RC-22

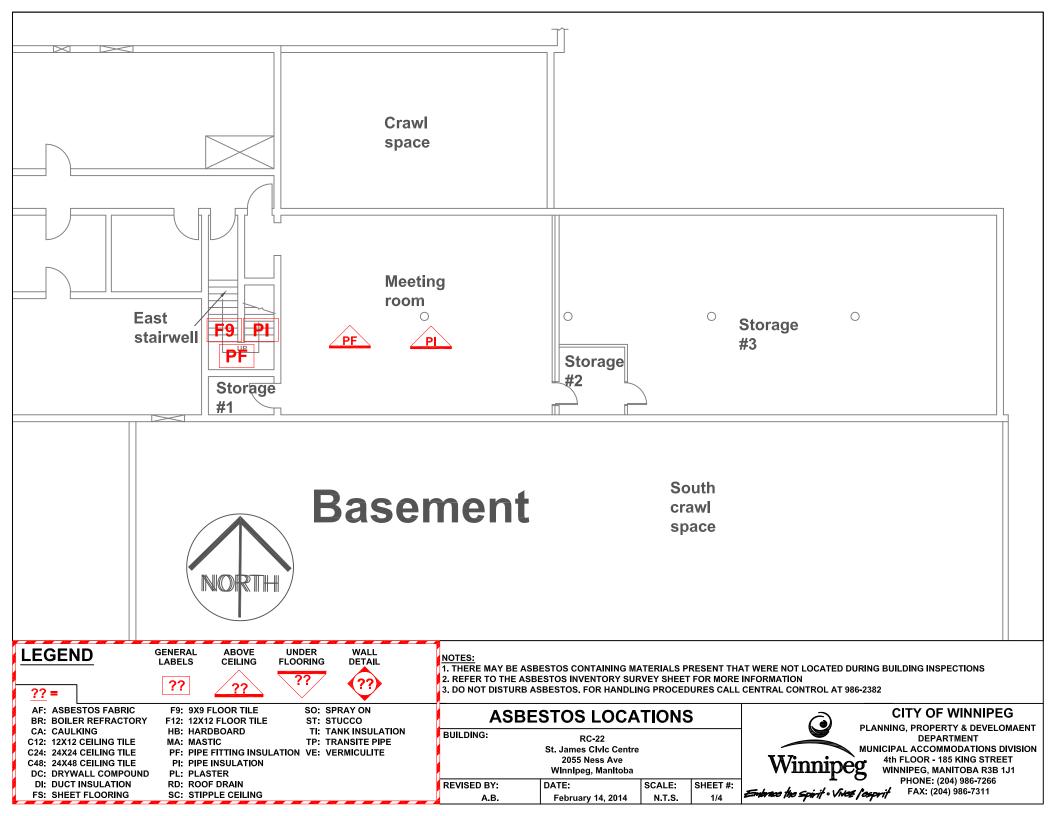





Mezzanine

LEGEND

GENERAL LABELS

ABOVE CEILING

UNDER **FLOORING**

WALL DETAIL

??









TI: TANK INSULATION

TP: TRANSITE PIPE

SO: SPRAY ON

ST: STUCCO

1. THERE MAY BE ASBESTOS CONTAINING MATERIALS PRESENT THAT WERE NOT LOCATED DURING BUILDING INSPECTIONS 2. REFER TO THE ASBESTOS INVENTORY SURVEY SHEET FOR MORE INFORMATION

3. DO NOT DISTURB ASBESTOS. FOR HANDLING PROCEDURES CALL CENTRAL CONTROL AT 986-2382

ASBESTOS LOCATIONS

RC-22 St. James Clvlc Centre 2055 Ness Ave Winnipeg, Manitoba

Embrace the Spirit · VIVE l'esprit

CITY OF WINNIPEG

PLANNING, PROPERTY & DEVELOPMENT DEPARTMENT MUNICIPAL ACCOMMODATIONS DIVISION 4th FLOOR - 185 KING STREET

WINNIPEG, MANITOBA R3B 1J1 PHONE: (204) 986-7266 FAX: (204) 986-7311

RD: ROOF DRAIN SC: STIPPLE CEILING BUILDING:

REVISED BY: SHEET #: DATE: SCALE: REM Aprll 29, 2015 N.T.S.

C48: 24X48 CEILING TILE DC: DRYWALL COMPOUND DI: DUCT INSULATION **FS: SHEET FLOORING**

AF: ASBESTOS FABRIC

C12: 12X12 CEILING TILE

C24: 24X24 CEILING TILE

CA: CAULKING

BR: BOILER REFRACTORY

PF: PIPE FITTING INSULATION VE: VERMICULITE PI: PIPE INSULATION PL: PLASTER

F9: 9X9 FLOOR TILE

F12: 12X12 FLOOR TILE

HB: HARDBOARD

MA: MASTIC

