

LAST SAVE: 2019/01/25 - 8:47am
PATH: M:\657381\ENGS\7ELE\DD - General DWG\1-0179F-E0015-001.dwg


1-0179F-E0014	MOTOR STARTER SCHEMATIC MS-F01 FLOOD PUMP
1-0179F-E0003	ELECTRICAL SINGLE LINE DIAGRAM
DRAWING NUMBER	REFERENCE DRAWINGS



NO.	REVISIONS	DATE	DESIGN	CHECK
01	ADDED LOCAL SWITCHES, ISSUED FOR CONSTRUCTION	2019/01/24	KS	BC
00	ISSUED FOR TENDER AND CONSTRUCTION	2018/12/14	KS	BC

SNC-LAVALIN INC.
148 Nature Park Way
Winnipeg, MB, Canada R3P 0X7
204-786-8080

DESIGNED BY: K. SAPIAK
CHECKED BY: B. CLEVEN
DRAWN BY: K. SAPIAK
APPROVED BY: B. CLEVEN
SCALE: NTS
ISSUED FOR CONSTRUCTION BY: K. ZUREK
DATE: 2018/08/17
DATE: 2019/01/24

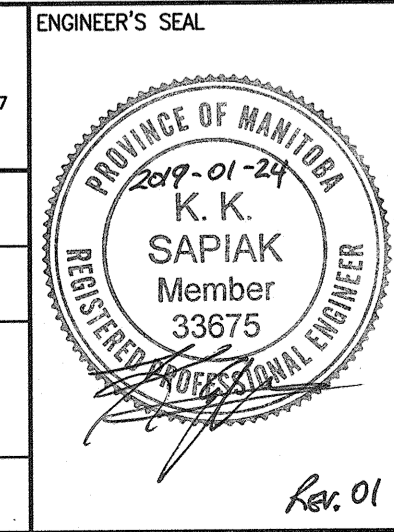

THE CITY OF WINNIPEG
WATER AND WASTE DEPARTMENT

ROLAND FLOOD PUMPING STATION
2019 UPGRADES
CONNECTION DIAGRAM
MS-F01
FLOOD PUMP

CITY DRAWING NUMBER: 1-0179F-E0015
SHEET: 001
REV: 01
SIZE: A1