


LAST SAVE: 2019/01/25 - 8:50am
 PATH: M:\657381\ENGIN\47ELE\DD - General DWG\1-0179F-E0017-001.dwg

| | |
|----------------|---|
| 1-0179F-E0016 | MOTOR STARTER SCHEMATIC MS-F02 FLOOD PUMP |
| 1-0179F-E0003 | ELECTRICAL SINGLE LINE DIAGRAM |
| DRAWING NUMBER | REFERENCE DRAWINGS |



| | | | |
|---|---|-------------------------|--------------|
| SNC-LAVALIN INC. 148 Nature Park Way Winnipeg, MB, Canada R3P 0X7 204-786-8080 | | | |
| DESIGNED BY: | K. SAPIAK | CHECKED BY: | B. CLEVEN |
| DRAWN BY: | K. SAPIAK | APPROVED BY: | B. CLEVEN |
| SCALE: | NTS | ISSUED FOR CONSTRUCTION | BY: K. ZUREK |
| DATE: | 2018/08/20 | DATE: | 2019/01/24 |
| CONSULTANT NO.: | | | |
| NO. | REVISIONS | DATE | DESIGN CHECK |
| 01 | ADDED LOCAL SWITCHES, ISSUED FOR CONSTRUCTION | 2019/01/24 | KS BC |
| 00 | ISSUED FOR TENDER AND CONSTRUCTION | 2018/12/14 | KS BC |

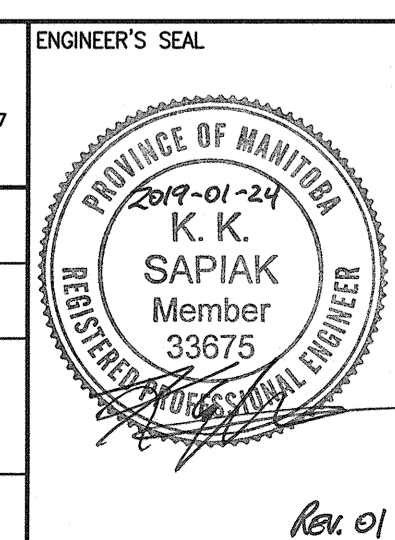

| | | | |
|---|-------|------|------|
| THE CITY OF WINNIPEG WATER AND WASTE DEPARTMENT | | | |
| ROLAND FLOOD PUMPING STATION 2019 UPGRADES CONNECTION DIAGRAM MS-F02 FLOOD PUMP | | | |
| CITY DRAWING NUMBER | SHEET | REV. | SIZE |
| 1-0179F-E0017 | 001 | 01 | A1 |