
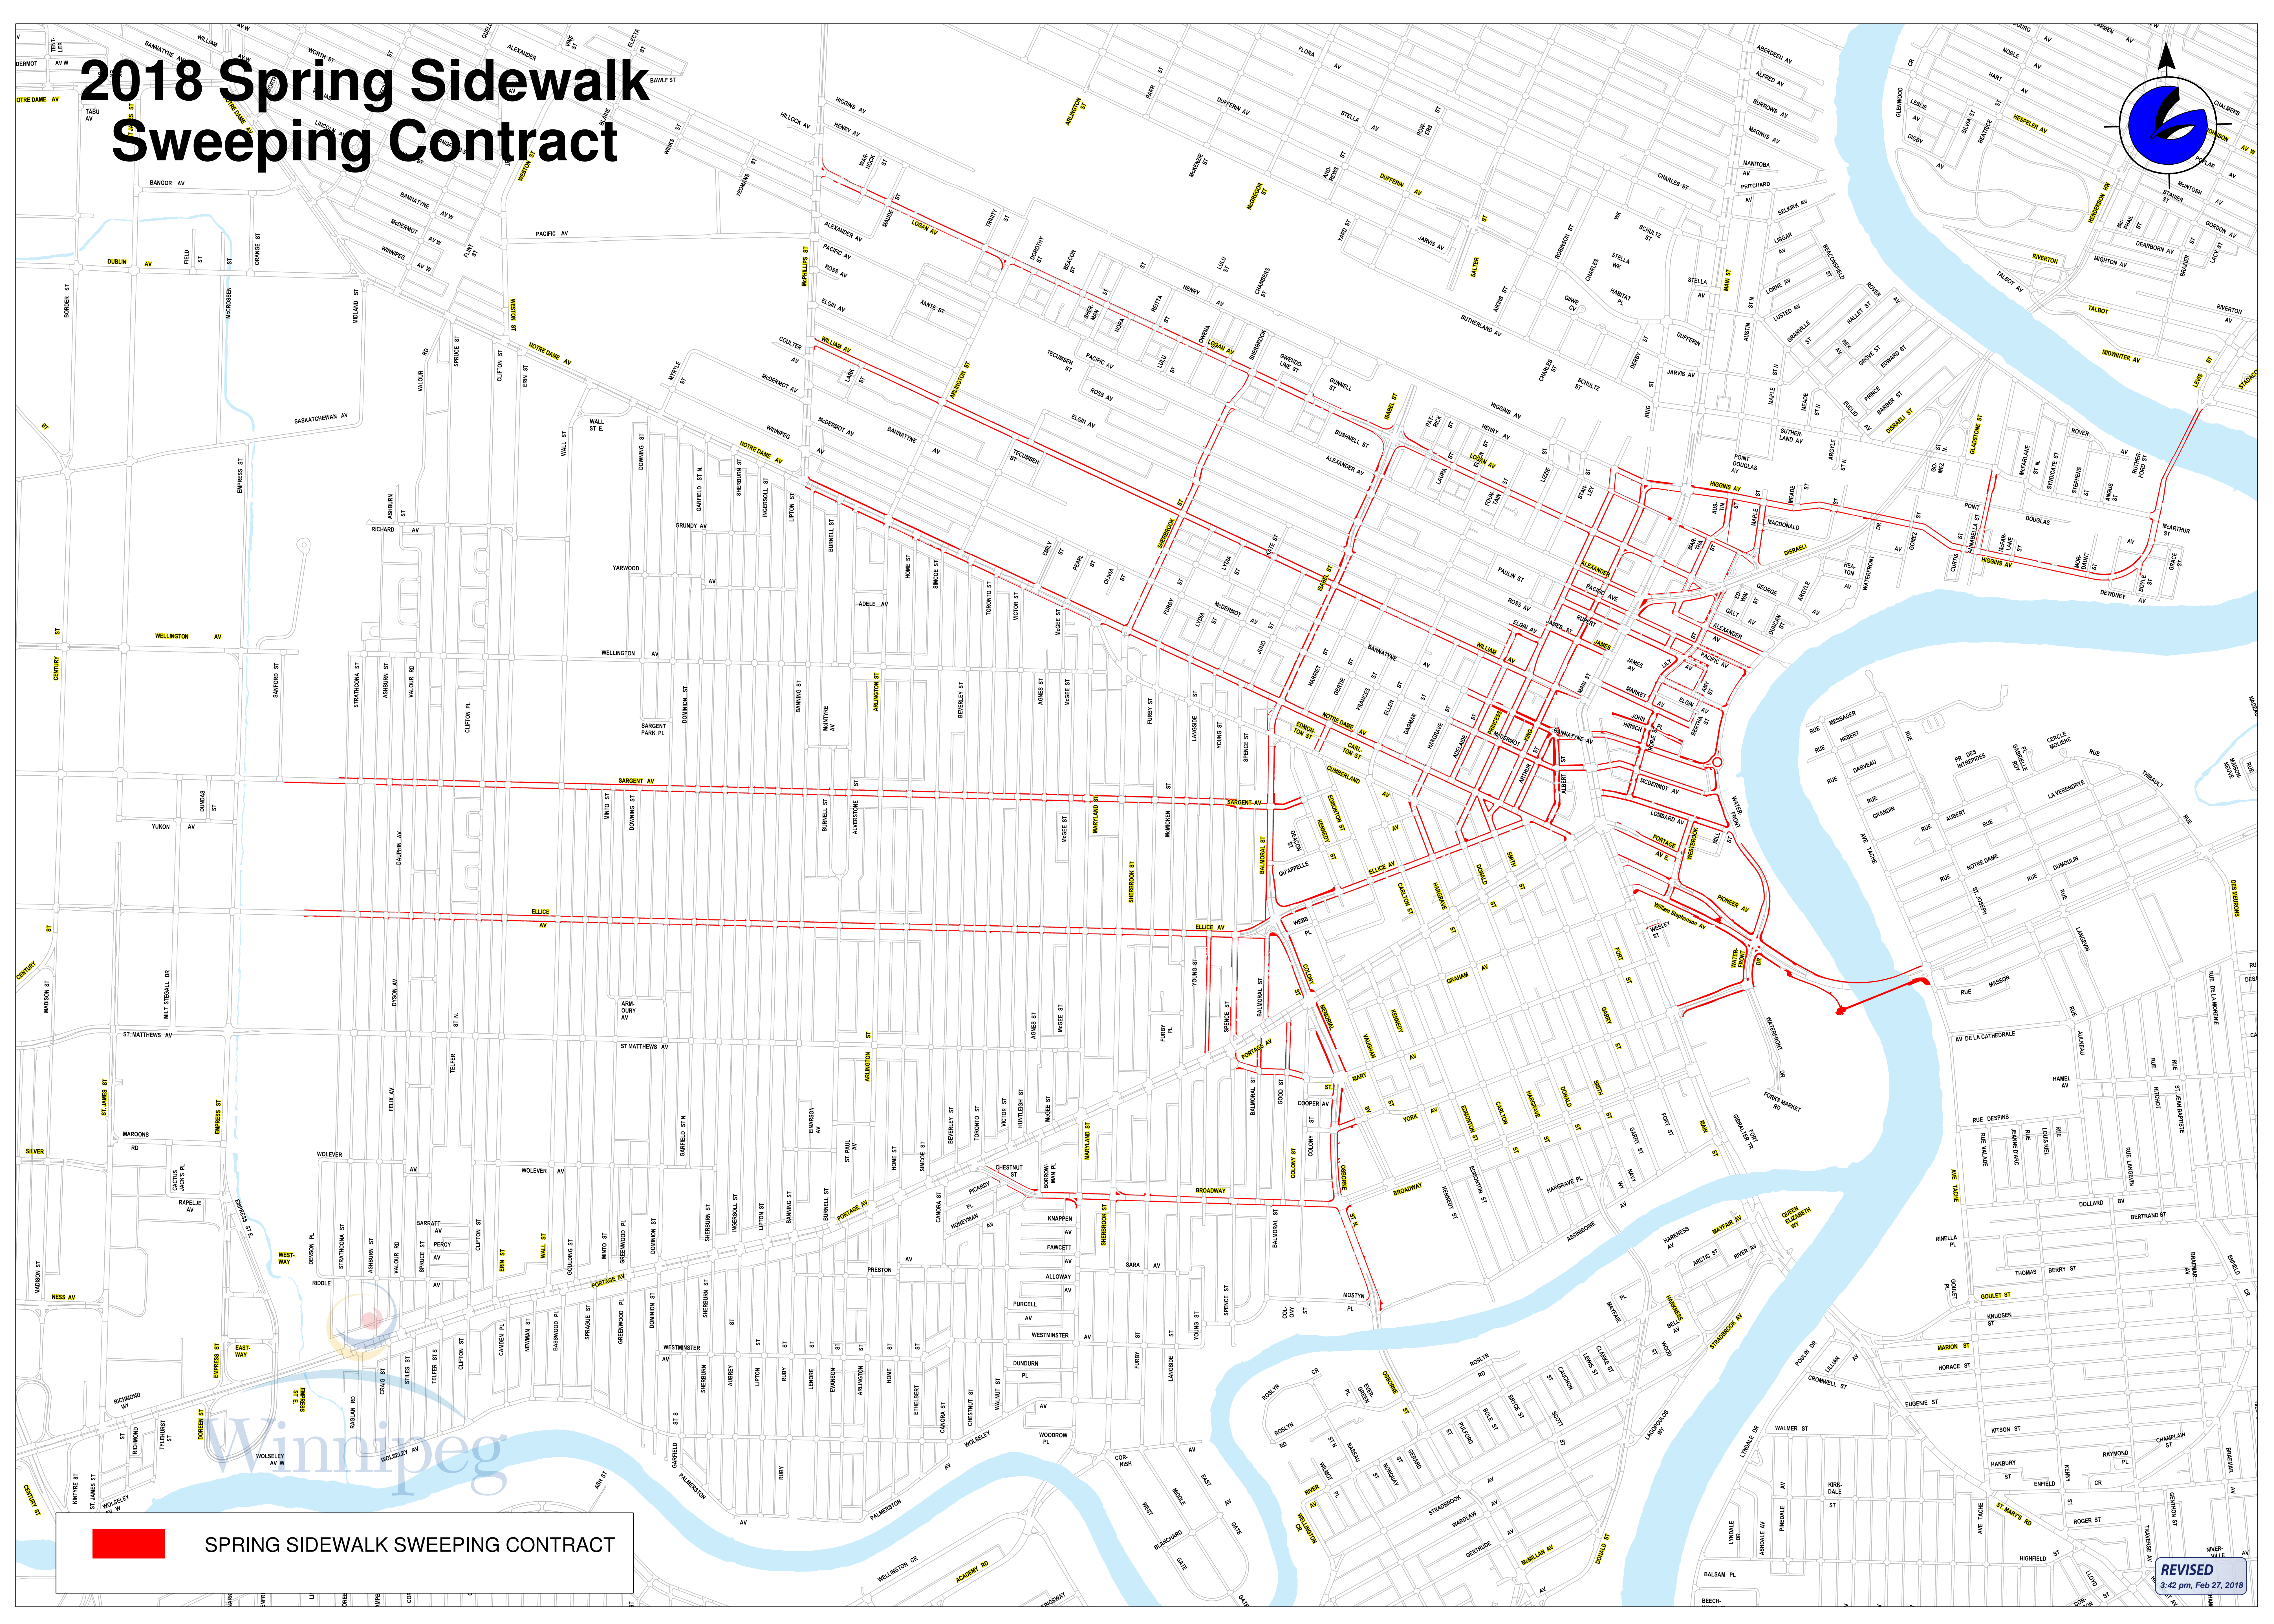


# 2018 Spring Sidewalk Sweeping Contract

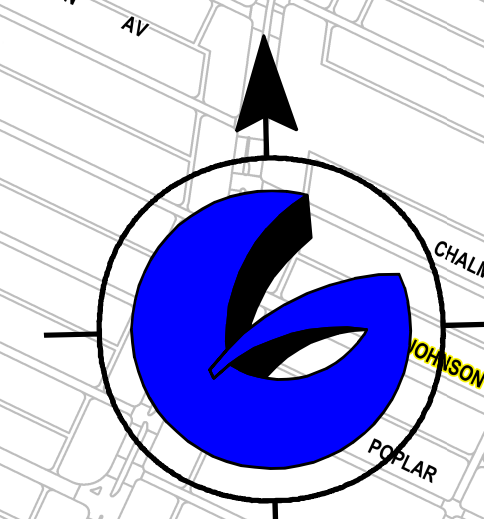

 **SPRING SIDEWALK SWEEPING CONTRACT**

**REVISED**  
3:42 pm, Feb 27, 2018