


bridgmancollaborative
ARCHITECTURE

678 Main Street
Winnipeg, MB
R3B 1E4
204-488-3857

www.bridgmancollaborative.ca

Project:
**715 MAIN STREET
PUBLIC TOILET**

715 Main Street, Winnipeg, MB
Project Number: 2022
Bid Opportunity Number: 54-2021

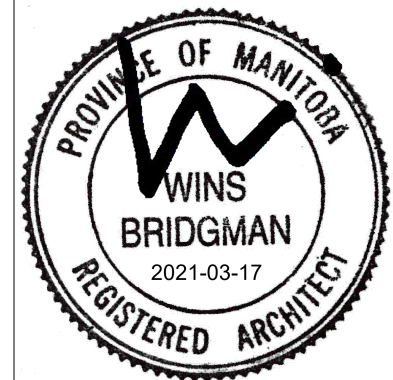

#	Issue/Revision	Date
1	ISSUED FOR CONSTRUCTION	MAR. 3, 2021
2	ADDENDUM #1	MAR. 15, 2021

Drawing Title:
BUILDING SECTION

Sheet No:
A303

This drawing is property of the Architect and cannot be reproduced or used without the consent of the Architect. The contractor is responsible for checking and verifying all levels and dimensions and shall report all discrepancies to the Architect and obtain clarification prior to commencing work.

1 BUILDING SECTION 3
1 : 48