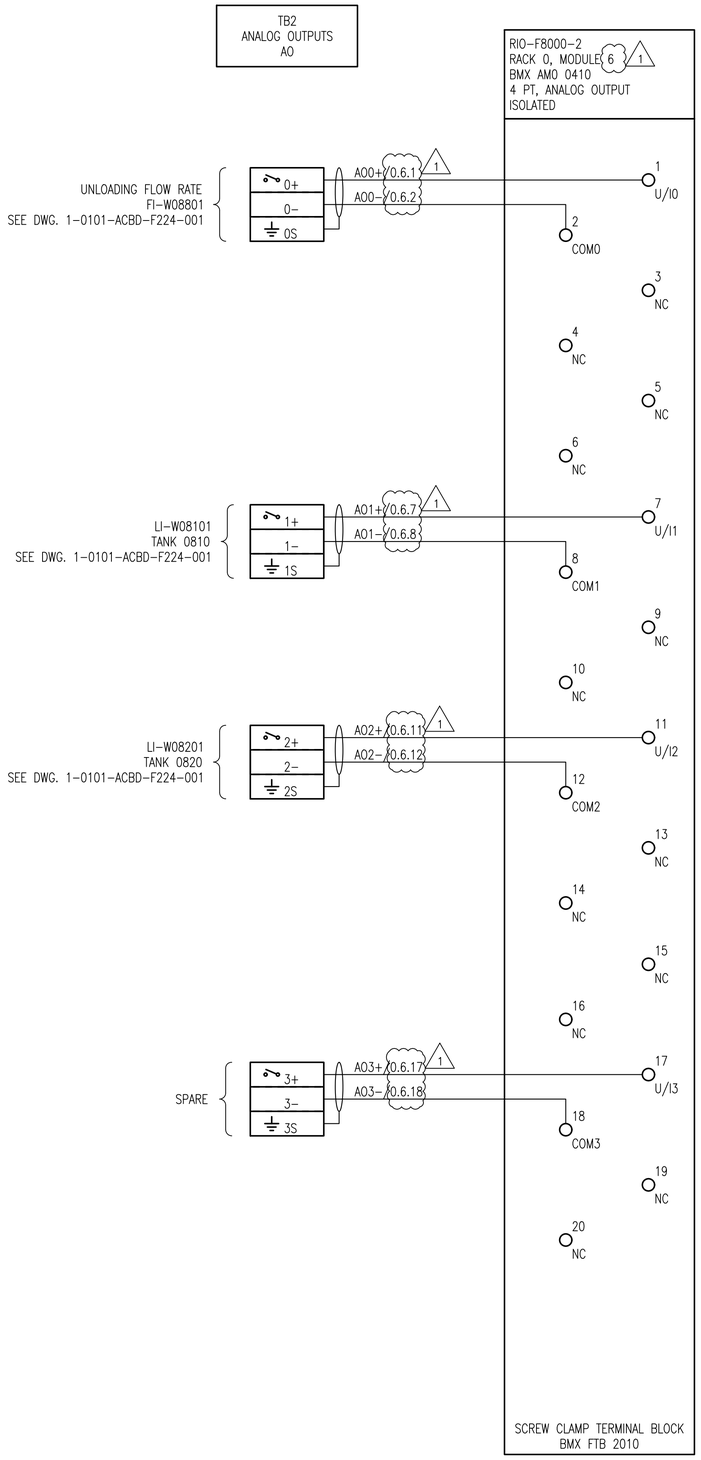

GENERAL NOTES:

-

NO.	DRAWING NUMBER	REFERENCE DRAWING TITLE
10	–	–
9	–	–
8	–	–
7	–	–
6	–	–
5	–	–
4	–	–
3	–	–
2	–	–
1	–	–

REFERENCE DRAWINGS

ENGINEERS GEOSCIENTISTS MANITOBA
Certificate of Authorization
KGS Group
No. 245

B.M.
ELEV.

CONSTRUCTION COMPLETION DATE: YYYY MM DD

NO.	REVISIONS	DATE	BY
1	RE-ISSUED FOR CONSTRUCTION	2022 07 05	JAB
0	ISSUED FOR CONSTRUCTION	2022 05 18	JAB

KGS GROUP

DESIGNED BY	DG	CHECKED BY	JAB
DRAWN BY	RG	APPROVED BY	JAB
SCALE:	NTS	RELEASED FOR CONSTRUCTION	
DATE	2022 04 04	DATE	

PLOT DATE: 2022 07 12

ENGINEER'S SEAL
PROVINCE OF MANITOBA
BOUCHARD
Member
20560
2022-07-14
REGISTERED PROFESSIONAL ENGINEER

CONSULTANT DRAWING NUMBER
21-0107-015-A5.207

BID OPPORTUNITY: 197-2022
CONTRACT NUMBER:

Winnipeg

THE CITY OF WINNIPEG
WATER AND WASTE DEPARTMENT
ENGINEERING DIVISION

NORTH END SEWAGE TREATMENT PLANT (NEWPCC)
INTERIM PHOSPHOROUS REMOVAL
AUTOMATION

BUILDING 102
RIO-F8000-2 WIRING DIAGRAM – ANALOG OUTPUT

CITY DRAWING NUMBER 1-0101-ACBD-F222-001

SHEET 8 OF 9

1

FILE PATH: \\192.168.0.226\r-data\Projects\2021\21-0107-015\Dwg\Elec\ADDENDUM\
FILE NAME: 1-0101-ACBD-F222-001.dwg