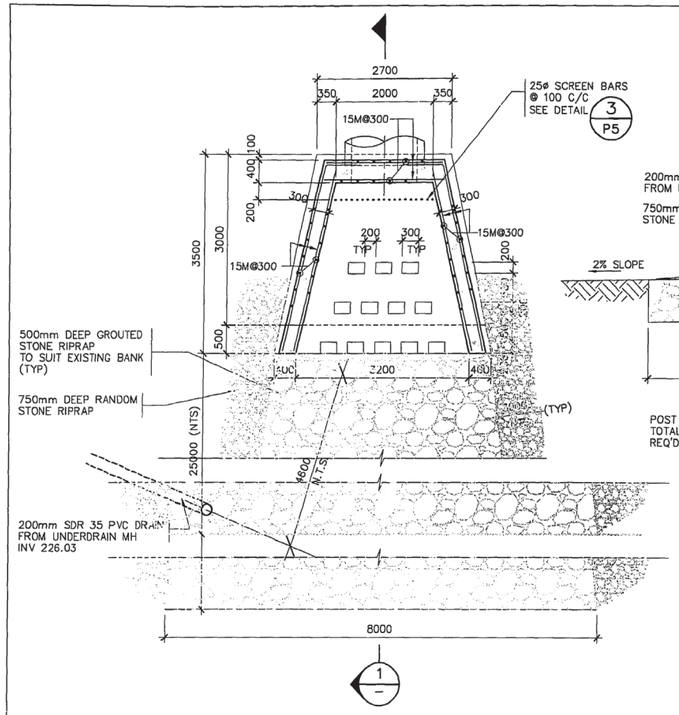

OUTFALL PLAN
SCALE 1:50

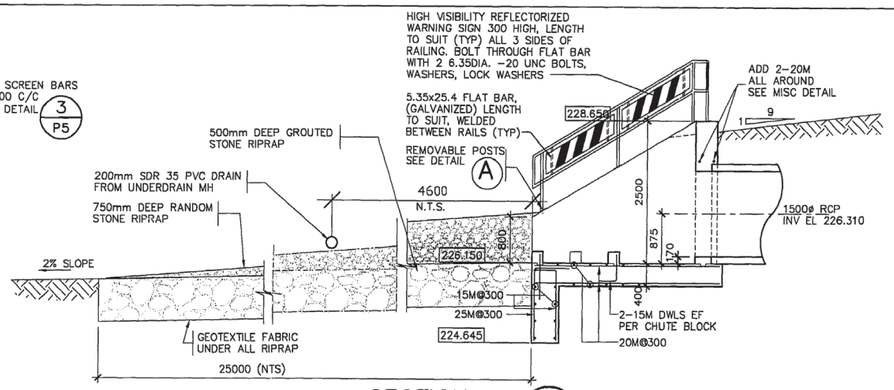

SECTION 1
SCALE 1:50

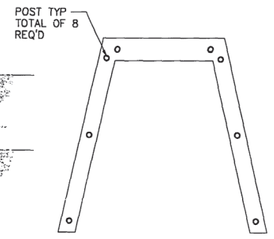

TOP VIEW
SCALE 1:50

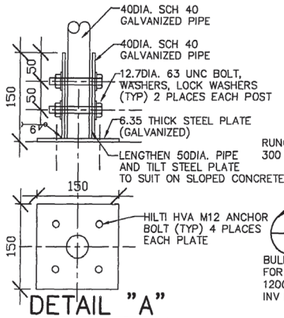

DETAIL "A"

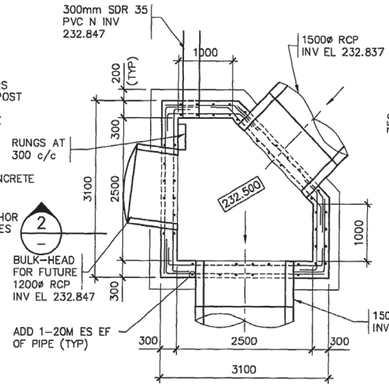

BASE PLAN
SCALE 1:50

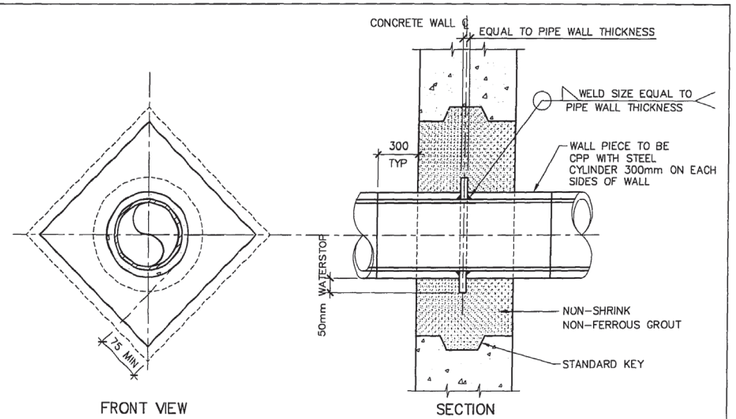

DETAIL OF WATER STOP FOR PIPE
SCALE NTS

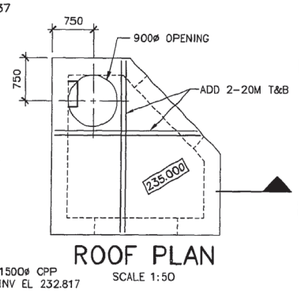

ROOF PLAN
SCALE 1:50

ALL REINFORCING 15M@300 UNLESS NOTED OTHERWISE

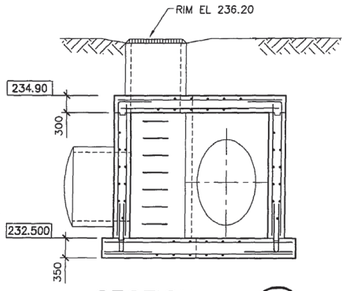

SECTION 2
SCALE 1:50

MANHOLE No 1

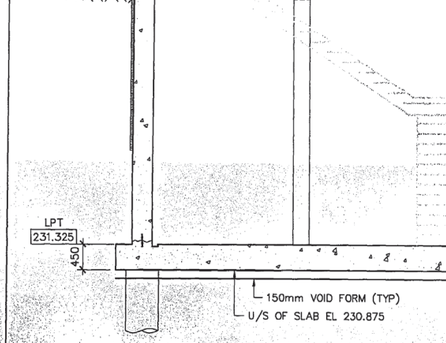

SECTION 3
SCALE 1:50 — S1

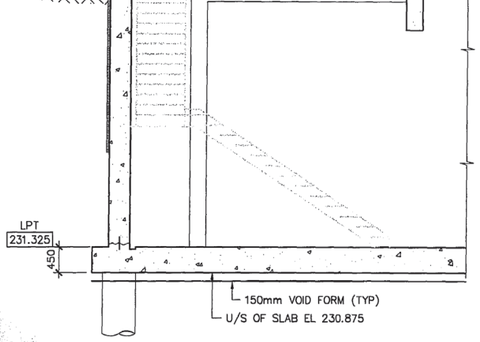

SECTION 4
SCALE 1:50 — S1

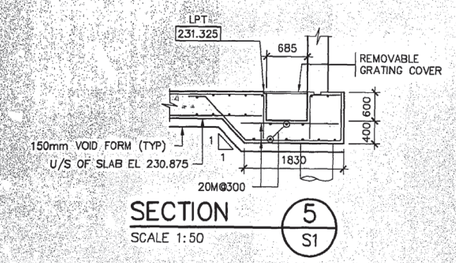

SECTION 5
SCALE 1:50 — S1

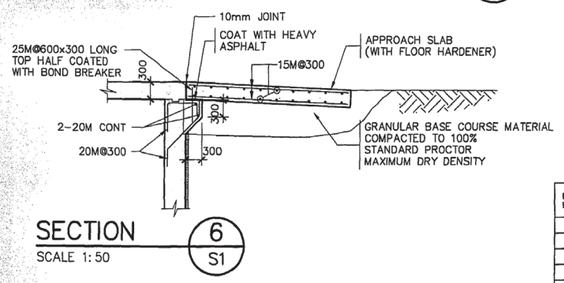

SECTION 6
SCALE 1:50 — S1

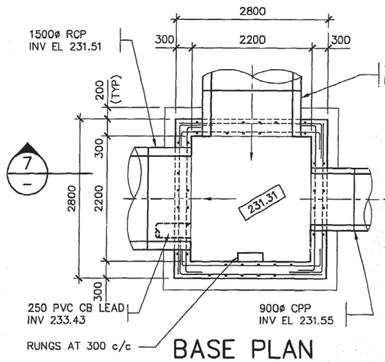

BASE PLAN
SCALE 1:50

ALL REINFORCING 15M@300 UNLESS NOTED OTHERWISE

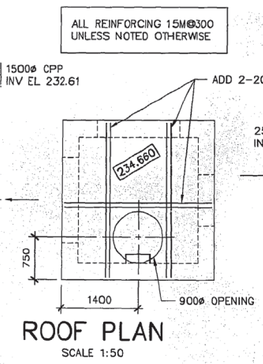

ROOF PLAN
SCALE 1:50

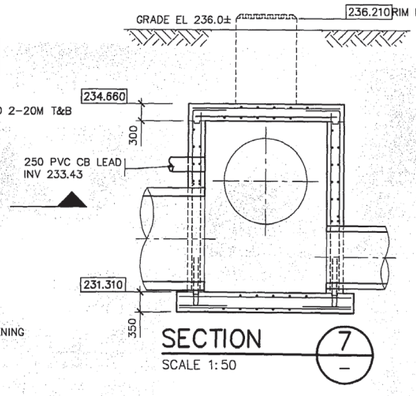

SECTION 7
SCALE 1:50

MANHOLE No 2

RECORD DRAWING

FOR ABBREVIATIONS SEE DWG A1

NO.	REVISIONS	DATE	BY
R2	RECORD DRAWING	99.04.27	DHG
R1	RECORD DRAWING	98.05.29	DHG

B.M. ELEV.

These record documents have been prepared based on information provided by others. The design professional has not verified the accuracy and/or the completeness of this information and shall not be responsible for any errors or omissions which may be incorporated herein as a result.

CH2M GORE & STORRIE LIMITED

DESIGNED BY	YTC	CHECKED BY	ARP, RPP
DRAWN BY	MKG	APPROVED BY	
HOR. SCALE	AS NOTED	RELEASED FOR CONSTRUCTION	
VERTICAL	AS NOTED		
DATE	1996.08.12	DATE	

ENGINEER'S SEAL

ORIGINAL TENDER DRAWING SEALED

CONSULTANT DRAWING NO. 60010-53-A1-15508

THE CITY OF WINNIPEG
WORKS AND OPERATIONS DIVISION
WATER AND WASTE DEPARTMENT

SHOAL LAKE AQUEDUCT
MILE 12.86 DRAIN CHAMBER AND OUTFALL
OUTFALL STRUCTURE
PLANS AND SECTIONS

CITY DRAWING NUMBER D-4355
SHEET 8 OF 23
S2 REV. R2

AutoCAD Version:14