




SEWER JUNCTION INFORMATION FROM SEWER VIDEO INSPECTION		
SEWER ID S-MA20009553		
DISTANCE FROM S-MH20008741		
DISTANCE	DIAMETER	CLOCK
2.9	300	3:00
4.6	150	10:00
7.3	151	2:00
17.6	152	10:00
20.0	200	10:00
20.7	150	3:00
27.0	151	10:00
27.6	152	2:00
29.9	300	9:00
36.8	150	10:00
37.5	150	2:00
40.1	250	9:00
46.8	150	11:00
47.5	150	1:00
52.2	250	9:00
56.9	150	11:00
57.6	150	2:00

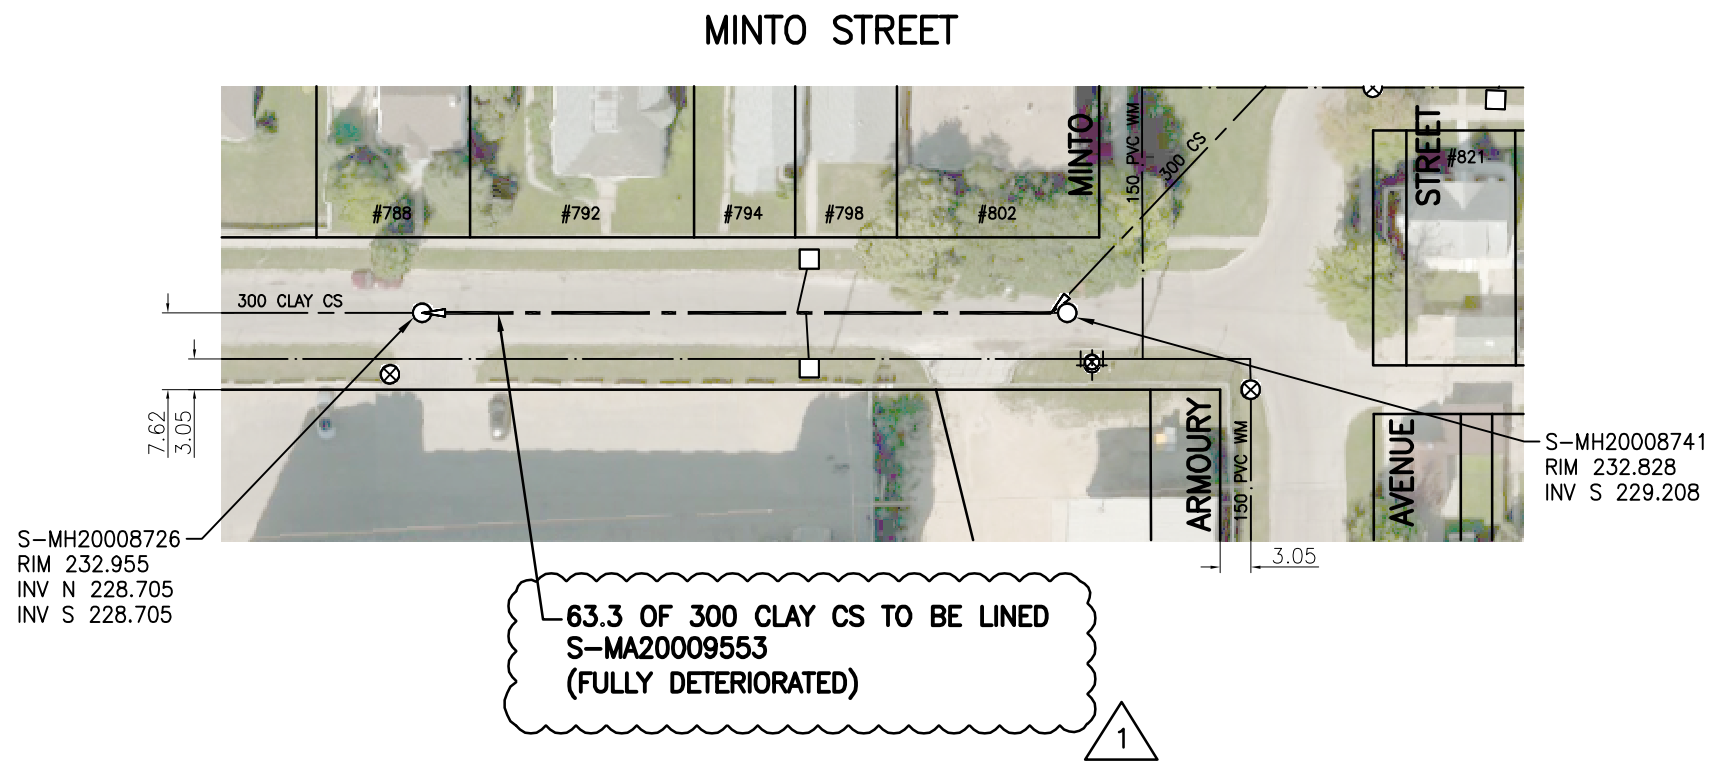

S-MH20008726
RIM 232.955
INV N 228.705
INV S 228.705

S-MH20008741
RIM 232.828
INV S 229.208

63.3 OF 300 CLAY CS TO BE LINED
S-MA20009553
(FULLY DETERIORATED)

1

WARNING

IF POWER EQUIPMENT OR EXPLOSIVES ARE TO BE USED FOR EXCAVATION ON THIS PROJECT THE CONTRACTOR MUST:

- 1) NOTIFY THE GAS COMPANY OF THE PROPOSED LOCATION OF EXCAVATION.
- 2) TAKE PRECAUTION TO AVOID DAMAGE TO GAS COMPANY INSTALLATIONS.

SEE PROVINCIAL REGULATION 140/92 FOR DETAILS

**ENGINEERS
GEOSCIENTISTS
MANITOBA**
Certificate of Authorization
Stantec Consulting Ltd.
No. 1301

FOR INDEX SEE
13264

METRIC
WHOLE NUMBERS INDICATE MILLIMETRES
DECIMALIZED NUMBERS INDICATE METRES



TENDER NO. 308-2023

V:\112\active\11220786\0300_drawing\0302_sheet_files\02_civil\20786c-131_140.dwg

LOCATION APPROVED UNDERGROUND STRUCTURES SUPV. U/G STRUCTURES COMMITTEE _____ DATE _____ NOTE: LOCATION OF UNDERGROUND STRUCTURES AS SHOWN ARE BASED ON THE BEST INFORMATION AVAILABLE BUT NO GUARANTEE IS GIVEN THAT ALL EXISTING UTILITIES ARE SHOWN OR THAT THE GIVEN LOCATIONS ARE EXACT. CONFIRMATION OF EXISTENCE AND EXACT LOCATION OF ALL SERVICES MUST BE OBTAINED FROM THE INDIVIDUAL UTILITIES BEFORE PROCEEDING WITH CONSTRUCTION.	B.M. ELEV.			ENGINEER'S SEAL ORIGINAL SEALED BY R.M. SHERLOCK P. ENG. 2023/05/02	THE CITY OF WINNIPEG WATER AND WASTE DEPARTMENT
		DESIGNED BY: RS CHECKED BY: RS DRAWN BY: SC APPROVED BY: RS HOR. SCALE: 1:750 VERTICAL:	RELEASED FOR CONSTRUCTION: <i>Rolucky</i> CONSULTANT DRAWING NO. C-135		
NO. REVISIONS 01 ISSUED FOR ADDENDUM 1 00 ISSUED FOR TENDER	DATE BY 23.05.11 RS 23.05.02 RS	DATE BY 23.03.02	DATE 23.05.01	DATE 23.05.01	DATE 23.05.01