



TYPICAL LONGITUDINAL SECTION

No direct connection between water supply & pool or equipment
 Concoatic shielded cable not acceptable

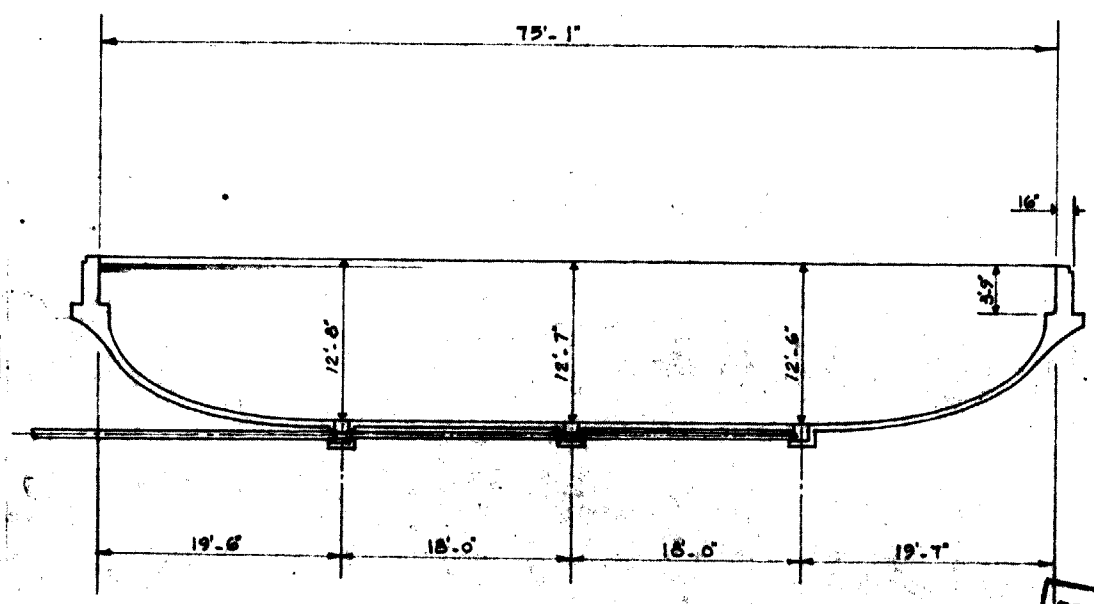

SECTION "A-A"

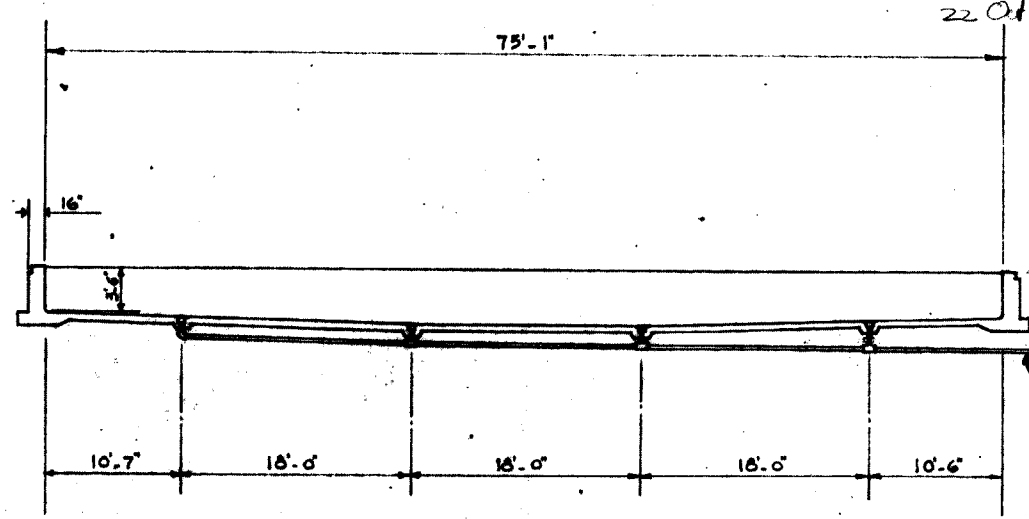


SECTION "B-B"

*Establish Allow to be submitted as per
 Allow 6' or refer
 No connection allowed between
 the portable water supply & pool or
 equipment*

13 19/65


Elev. 760.0
 Elev. 744.0
 3" polyethylene pipe

APPLICATION APPROVAL						
DEPT.	APPLIED FOR	DATE	TIME	DATE	TIME	APPROVED
EDUC.				12/16/65	12:15	[Signature]
PLANN.						
S. & IR						
W. & M.						
MANC.						
PROV.						

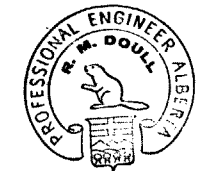


JOB	swimming pool		
DRAWN	pool profile & sections		
FOR	KILDONAN PARK-WINDIPIC		
TH. CANADA GLENITE CO. LTD.			
HALIFAX MONTREAL BURLINGTON WINNIPEG CALGARY			
DATE	SCALE	FIG. NO.	SHEET NO.
APR 22/66	1/8" = 1'-0"	221	2-1


Main ST.

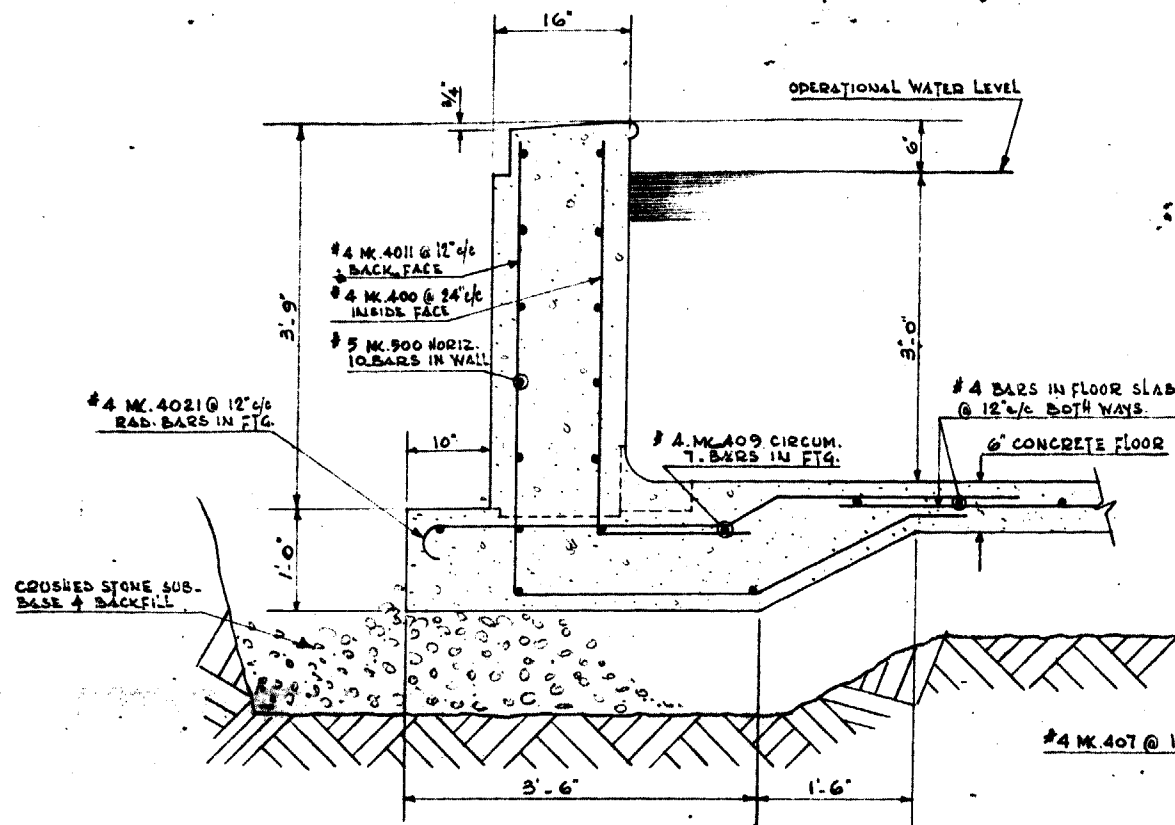



SHALLOW-END WALL SECTION

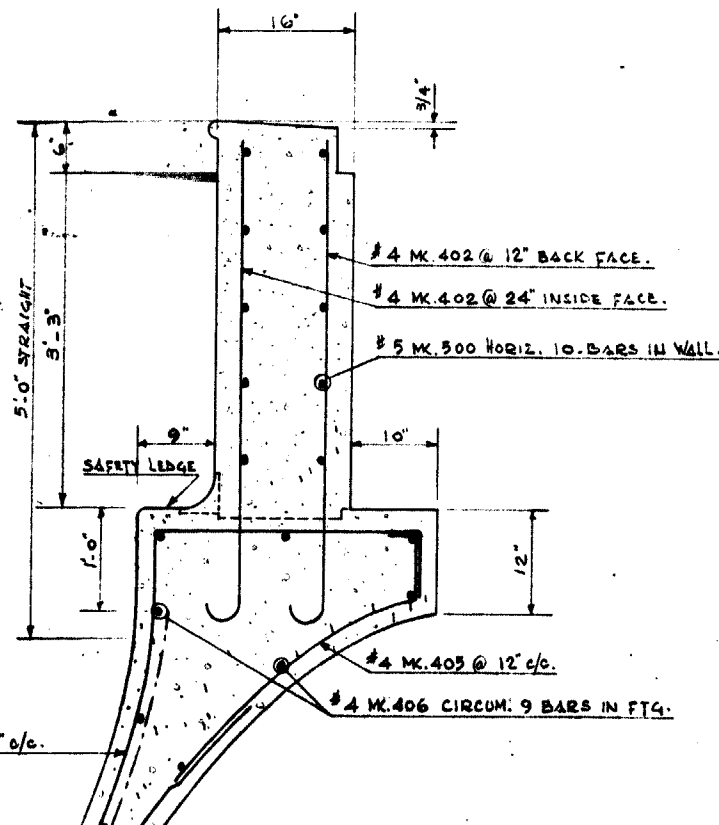


TRANSITION-LINE WALL SECTION

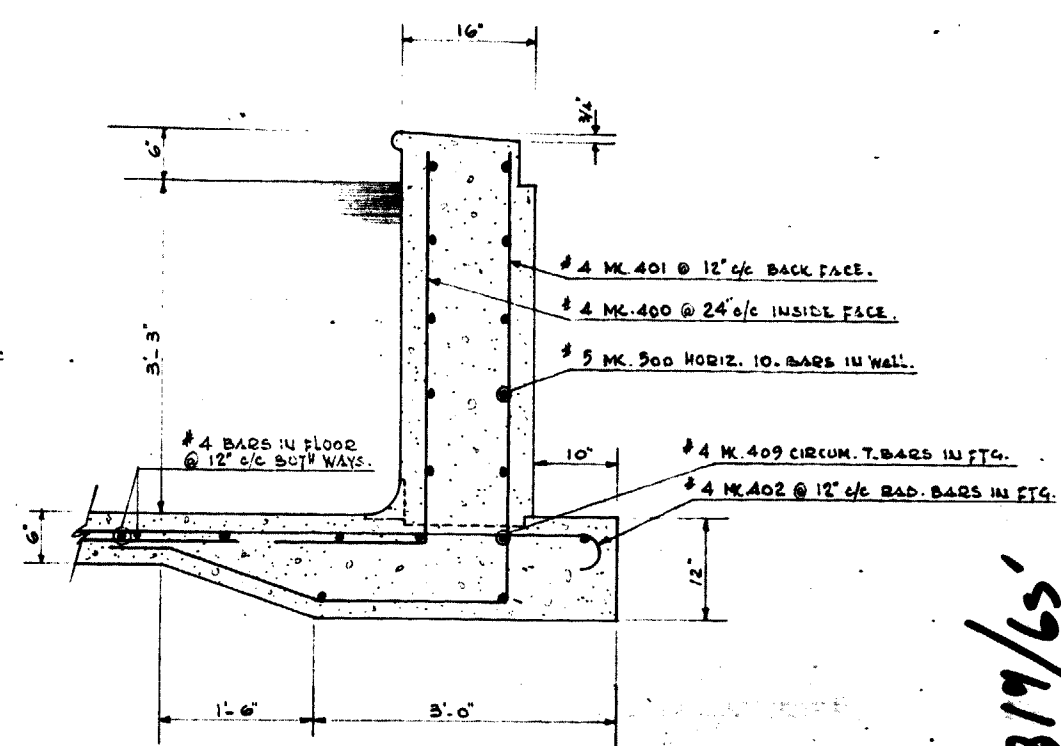


CORNER DETAIL

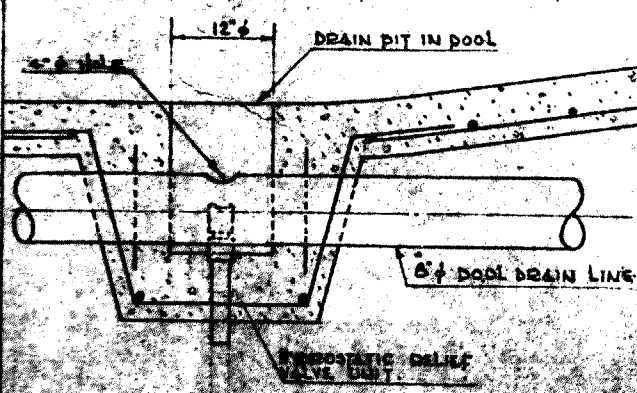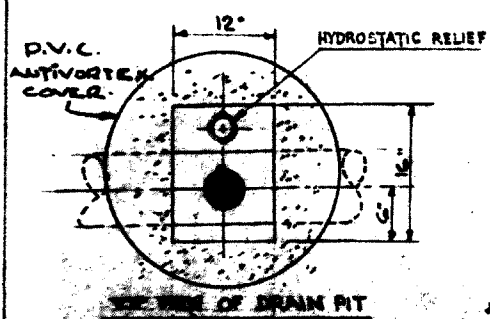


4' x 4' # 8/8 WIRE MESH
4'-0" DEEP

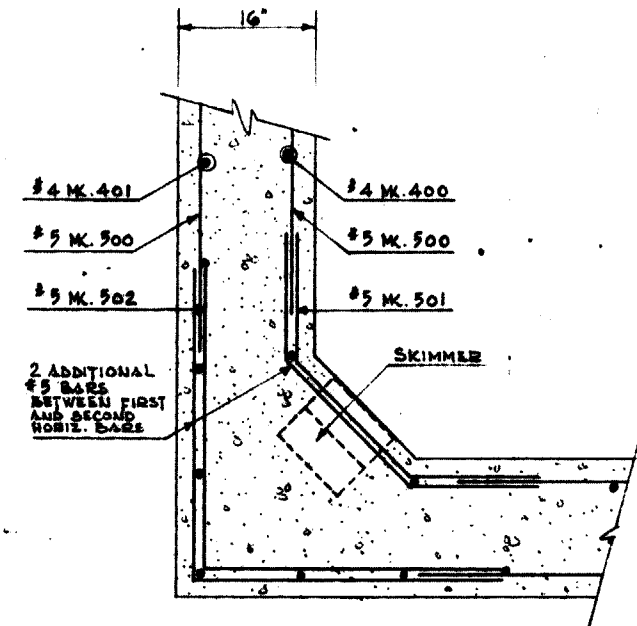

DEEP-END WALL SECTION


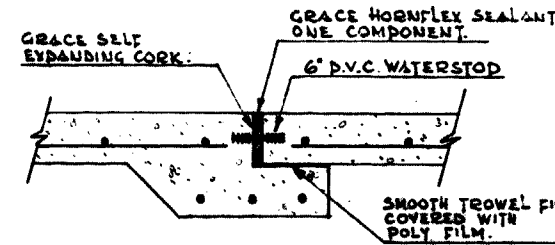


FLOOR EXP. JOINT DETAIL

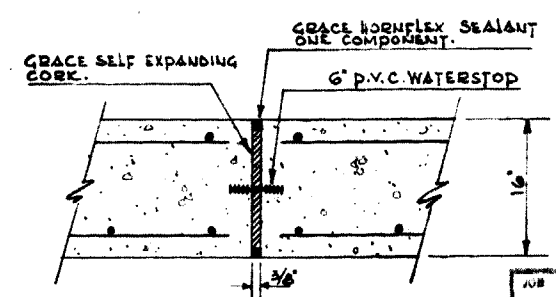


WALL EXP. JOINT DETAIL

1819/65

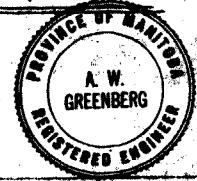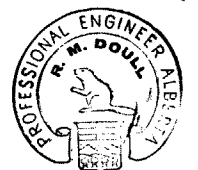


JOB				SWIMMING POOL			
DWG.				STRUCTURAL SECTIONS			
FOR				KILDONAN PARK WINNIPEG			
BY				THE CANADA GUNITE CO. LTD.			
DATE				HALIFAX MONTREAL BURLINGTON WINNIPEG CALGARY			
REV.	DATE	BY	NO.	SCALE	NO.	DATE	NO.
RP				1" = 1'-0"	221		5-2
AUG. 31/65							

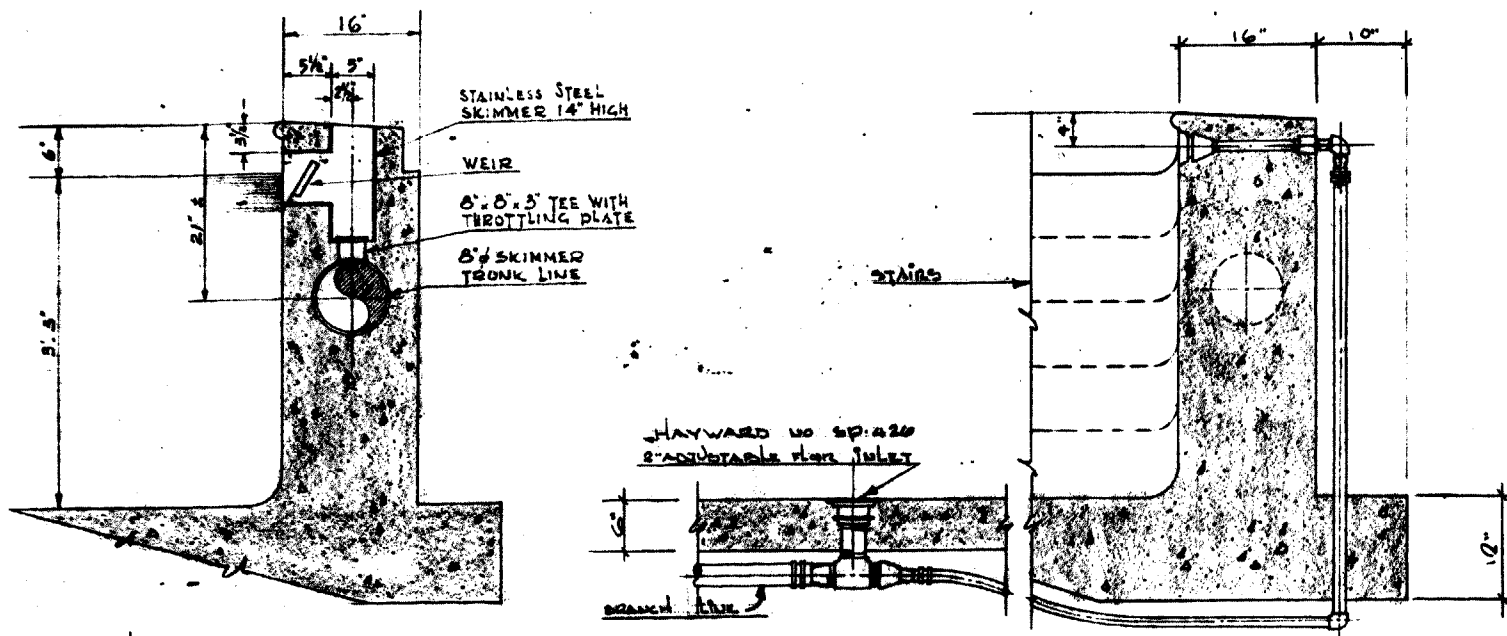


SCALE: 1" = 1'-0"

SCALE: 1" = 1'-0"

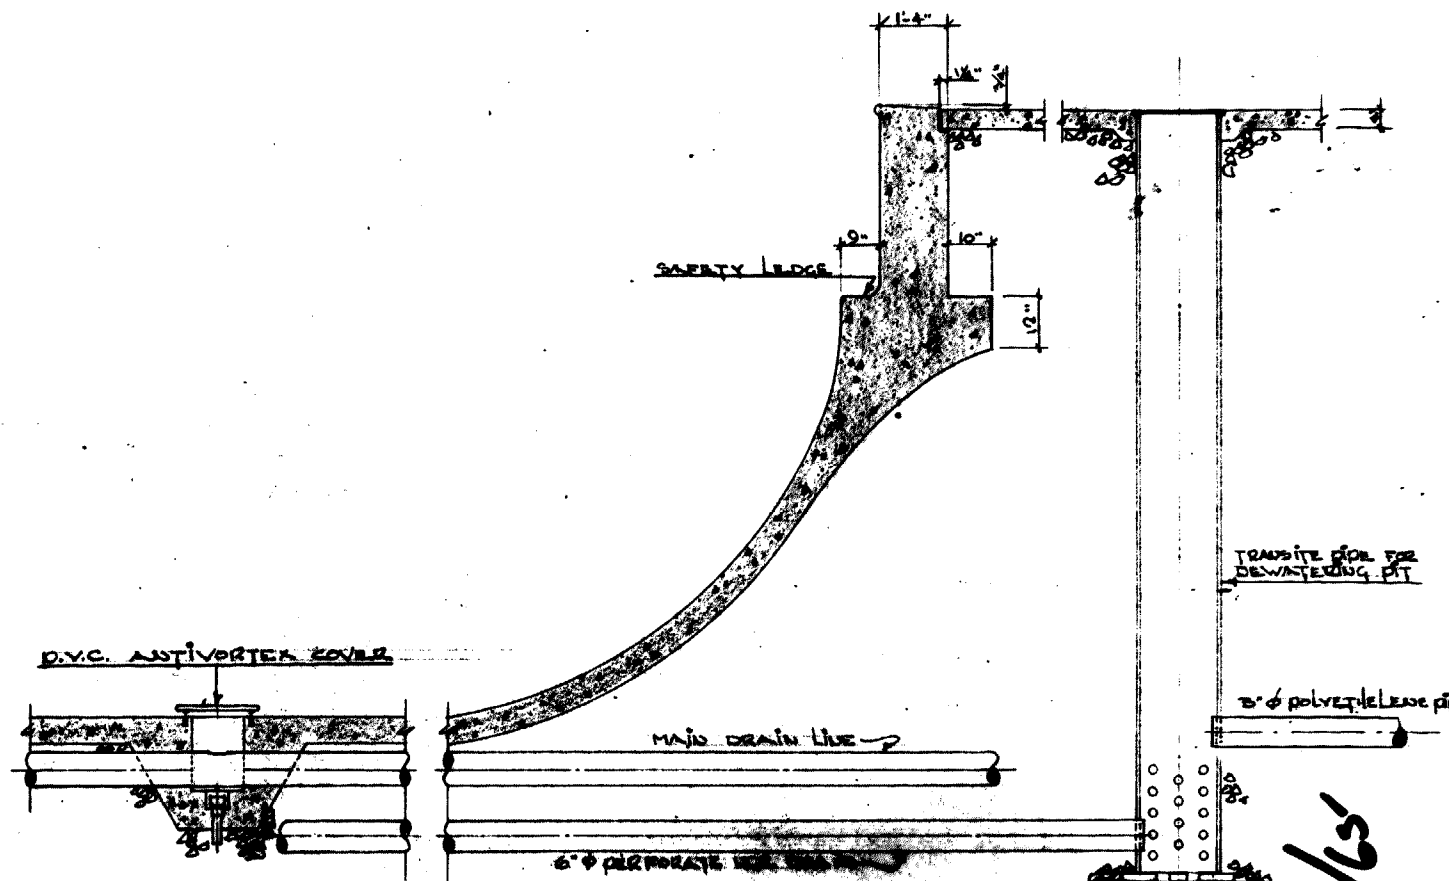


SCALE: 1/2" = 1'-0"


7319/65

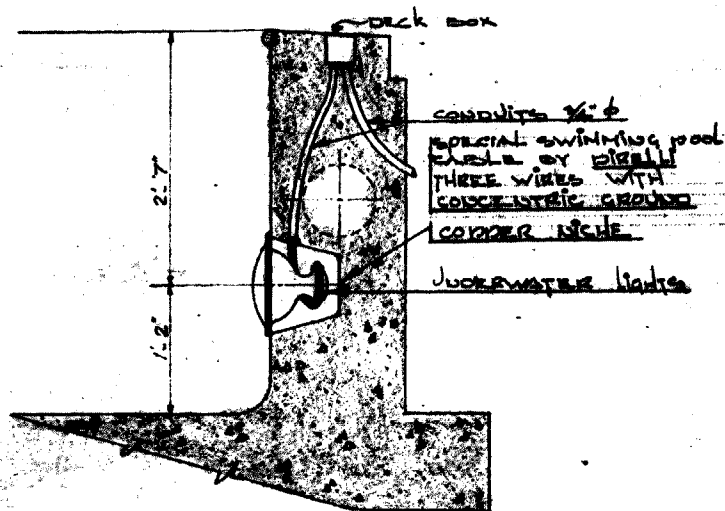


SCALE: 1" = 1'-0"

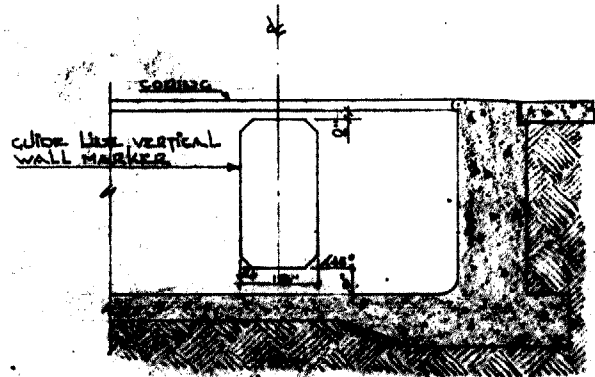


SCALE: 1" = 1'-0"

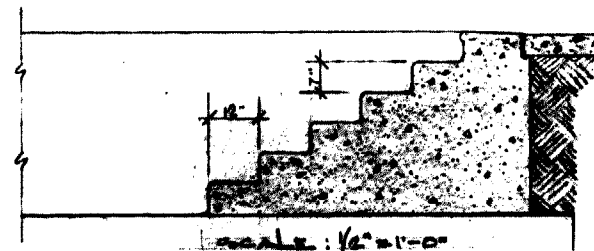


SCALE: 1/2" = 1'-0"

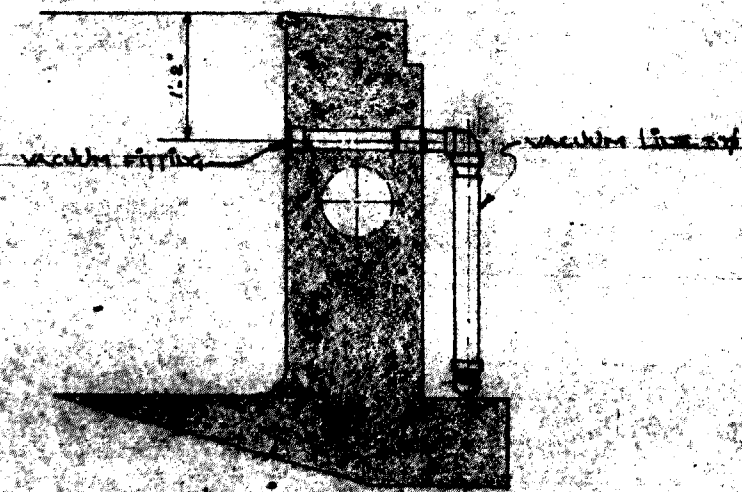


SCALE: 1" = 1'-0"

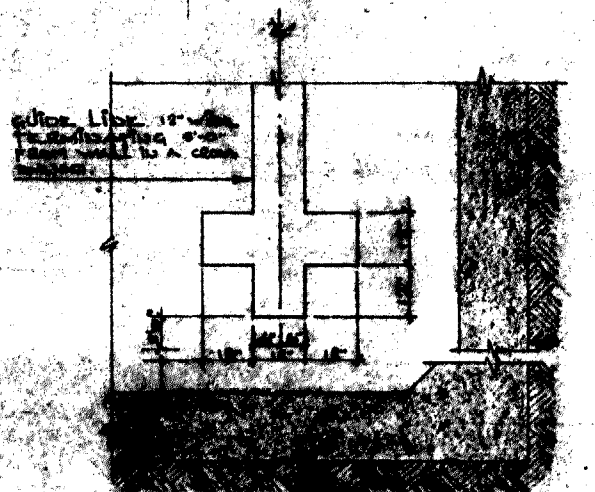


SCALE: 1" = 1'-0"

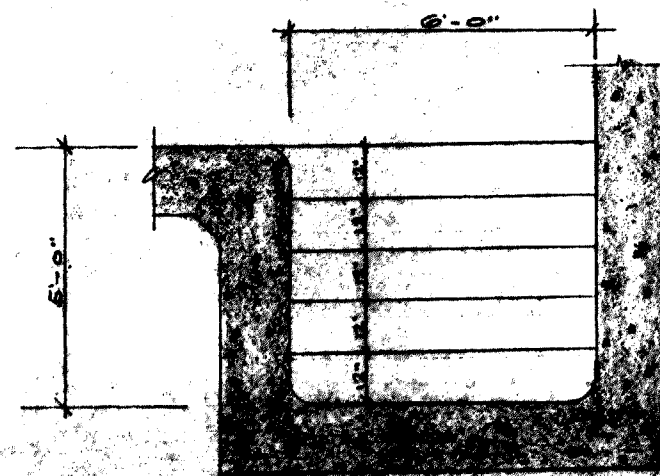

SCALE: 1/2" = 1'-0"

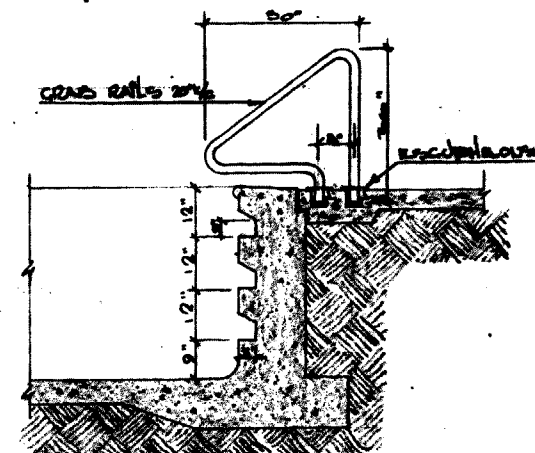

SCALE: 1/2" = 1'-0"

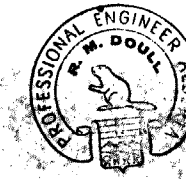

SWIMMING POOL	
CONSTRUCTION DETAILS	
KILBOURN PARK SWIMMING POOL	
THE CANADA GUNITE CO. LTD.	
HALFAN MONTANA BURLINGTON WINNIPEG CALGARY	
221	5-5