A1 SIZE - 594mm x 841mm

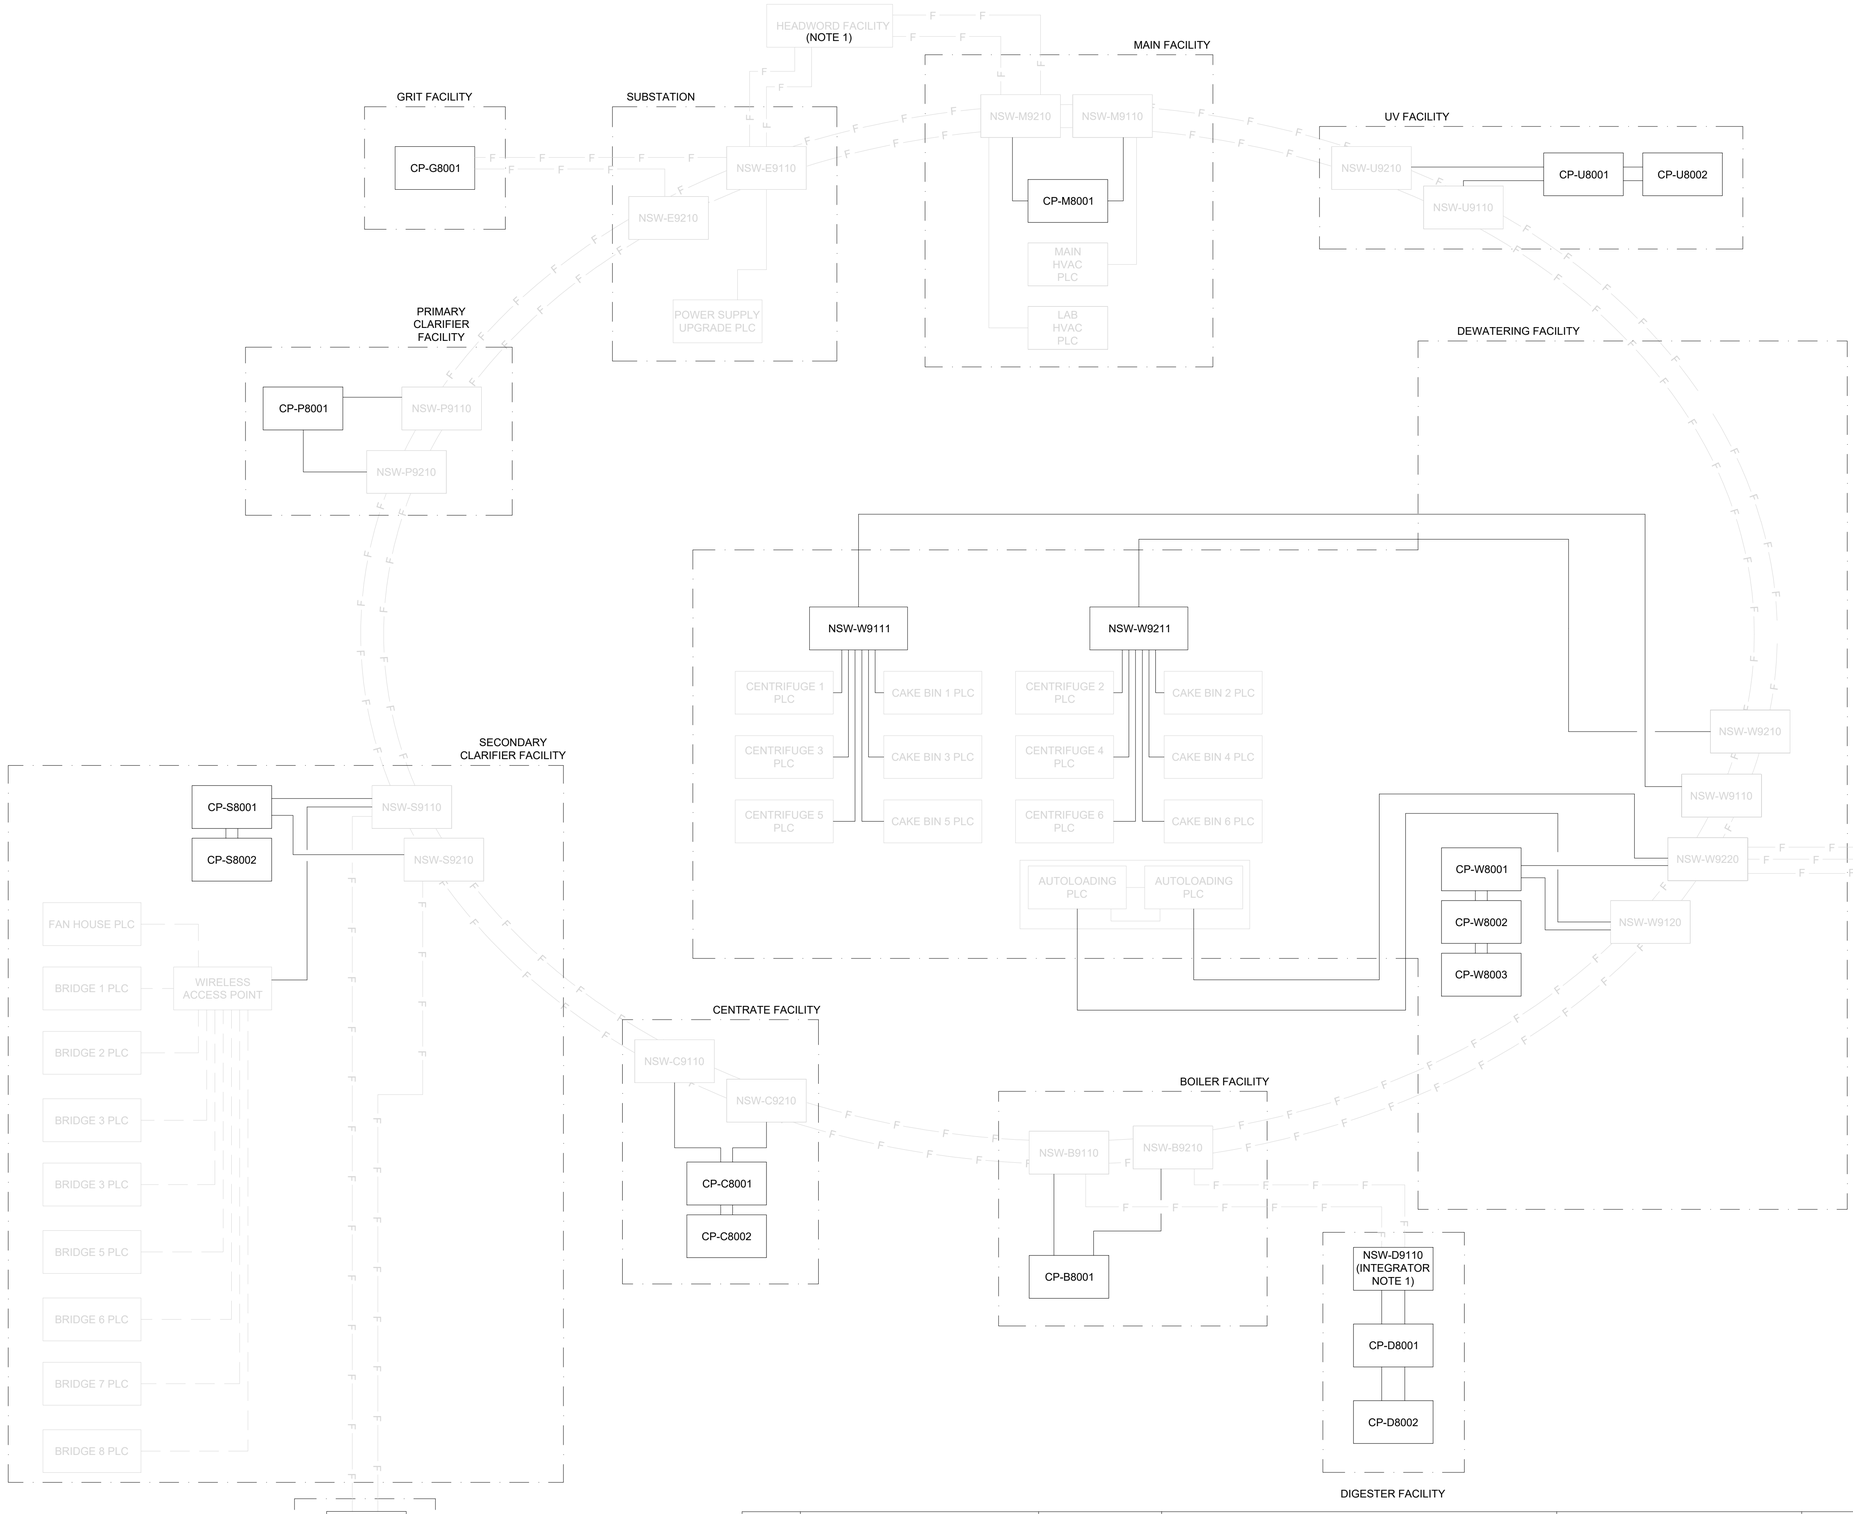

LEGEND

F — F — OM3 FIBRE (2)

ETHERNET

WIRELESS CONNECTION (IEEE 802.11)

NOTES:

1. HEADWORKS FIBRE INSTALLATION BY OTHERS. INTEGRATOR SCOPE IS TO INTEGRATE THE HEADWORKS AREA INTO THE MAIN PCS PROJECT.
2. GREYED OUT ITEMS INDICATE EXISTING EQUIPMENT OR DEVICES
3. NSW-D9110 TO BE SUPPLIED BY THE INTEGRATOR.

CONTRACTOR NOTES:

1. CONTRACTOR SCOPE IS LIMITED TO PROVIDING SHOWN NEW FIELD NETWORK CABLES.
2. SEE 1-0101-ANET-A007 FOR DETAILED SCOPE. (2)

INTEGRATOR NOTES:

1. PROVIDE NETWORK SWITCH NSW-D9110.

ENGINEERS GEOSCIENTISTS MANITOBA
Certificate of Authorization
AECOM Canada Ltd.
No. 4671 Date: 2023/12/08

REF. NO.	DRAWING TITLE	DRAWING NUMBER

REFERENCE DRAWING

NO.	REVISIONS	DATE	DESIGN	CHECK
2	ISSUED FOR ADDENDUM 1	2024-01-25	KG	SDS
1	ISSUED FOR GC TENDER	2024-01-08	KG	SDS
0	ISSUED FOR TENDER	2023-03-17	KG	SDS

AECOM

DESIGNED BY: KG	CHECKED BY: SDS
DRAWN BY: KG	APPROVED BY: SB
SCALE: NTS	RELEASED FOR CONSTRUCTION BY:
DATE: 2024-01-25	DATE:
CONSULTANT NO.:	

ENGINEER'S SEAL

PROVINCE OF MANITOBA 01/25/2024 S.D. SYMONS Member 43183 REGISTERED PROFESSIONAL ENGINEER

Winnipeg

THE CITY OF WINNIPEG
WATER AND WASTE DEPARTMENT

NORTH END SEWAGE TREATMENT PLANT
DCS MIGRATION
NETWORK DIAGRAM
PLANT CONTROL NETWORK LOOP DIAGRAM

CITY DRAWING NUMBER	SHEET	REV.	SIZE
1-0101-ANET-A003	001	2	A1

LAST SAVE: 2024/01/25 11:30 AM
PATH: C:\Users\Katherine.Gledson\DC\ACCDocs\AECOM\City of Winnipeg - NEWPCC Upgrades-20210\Project Files\900 Design Collaboration\60643525 DCS Migration\02- Main Package\1-0101-ANET-A003.dwg