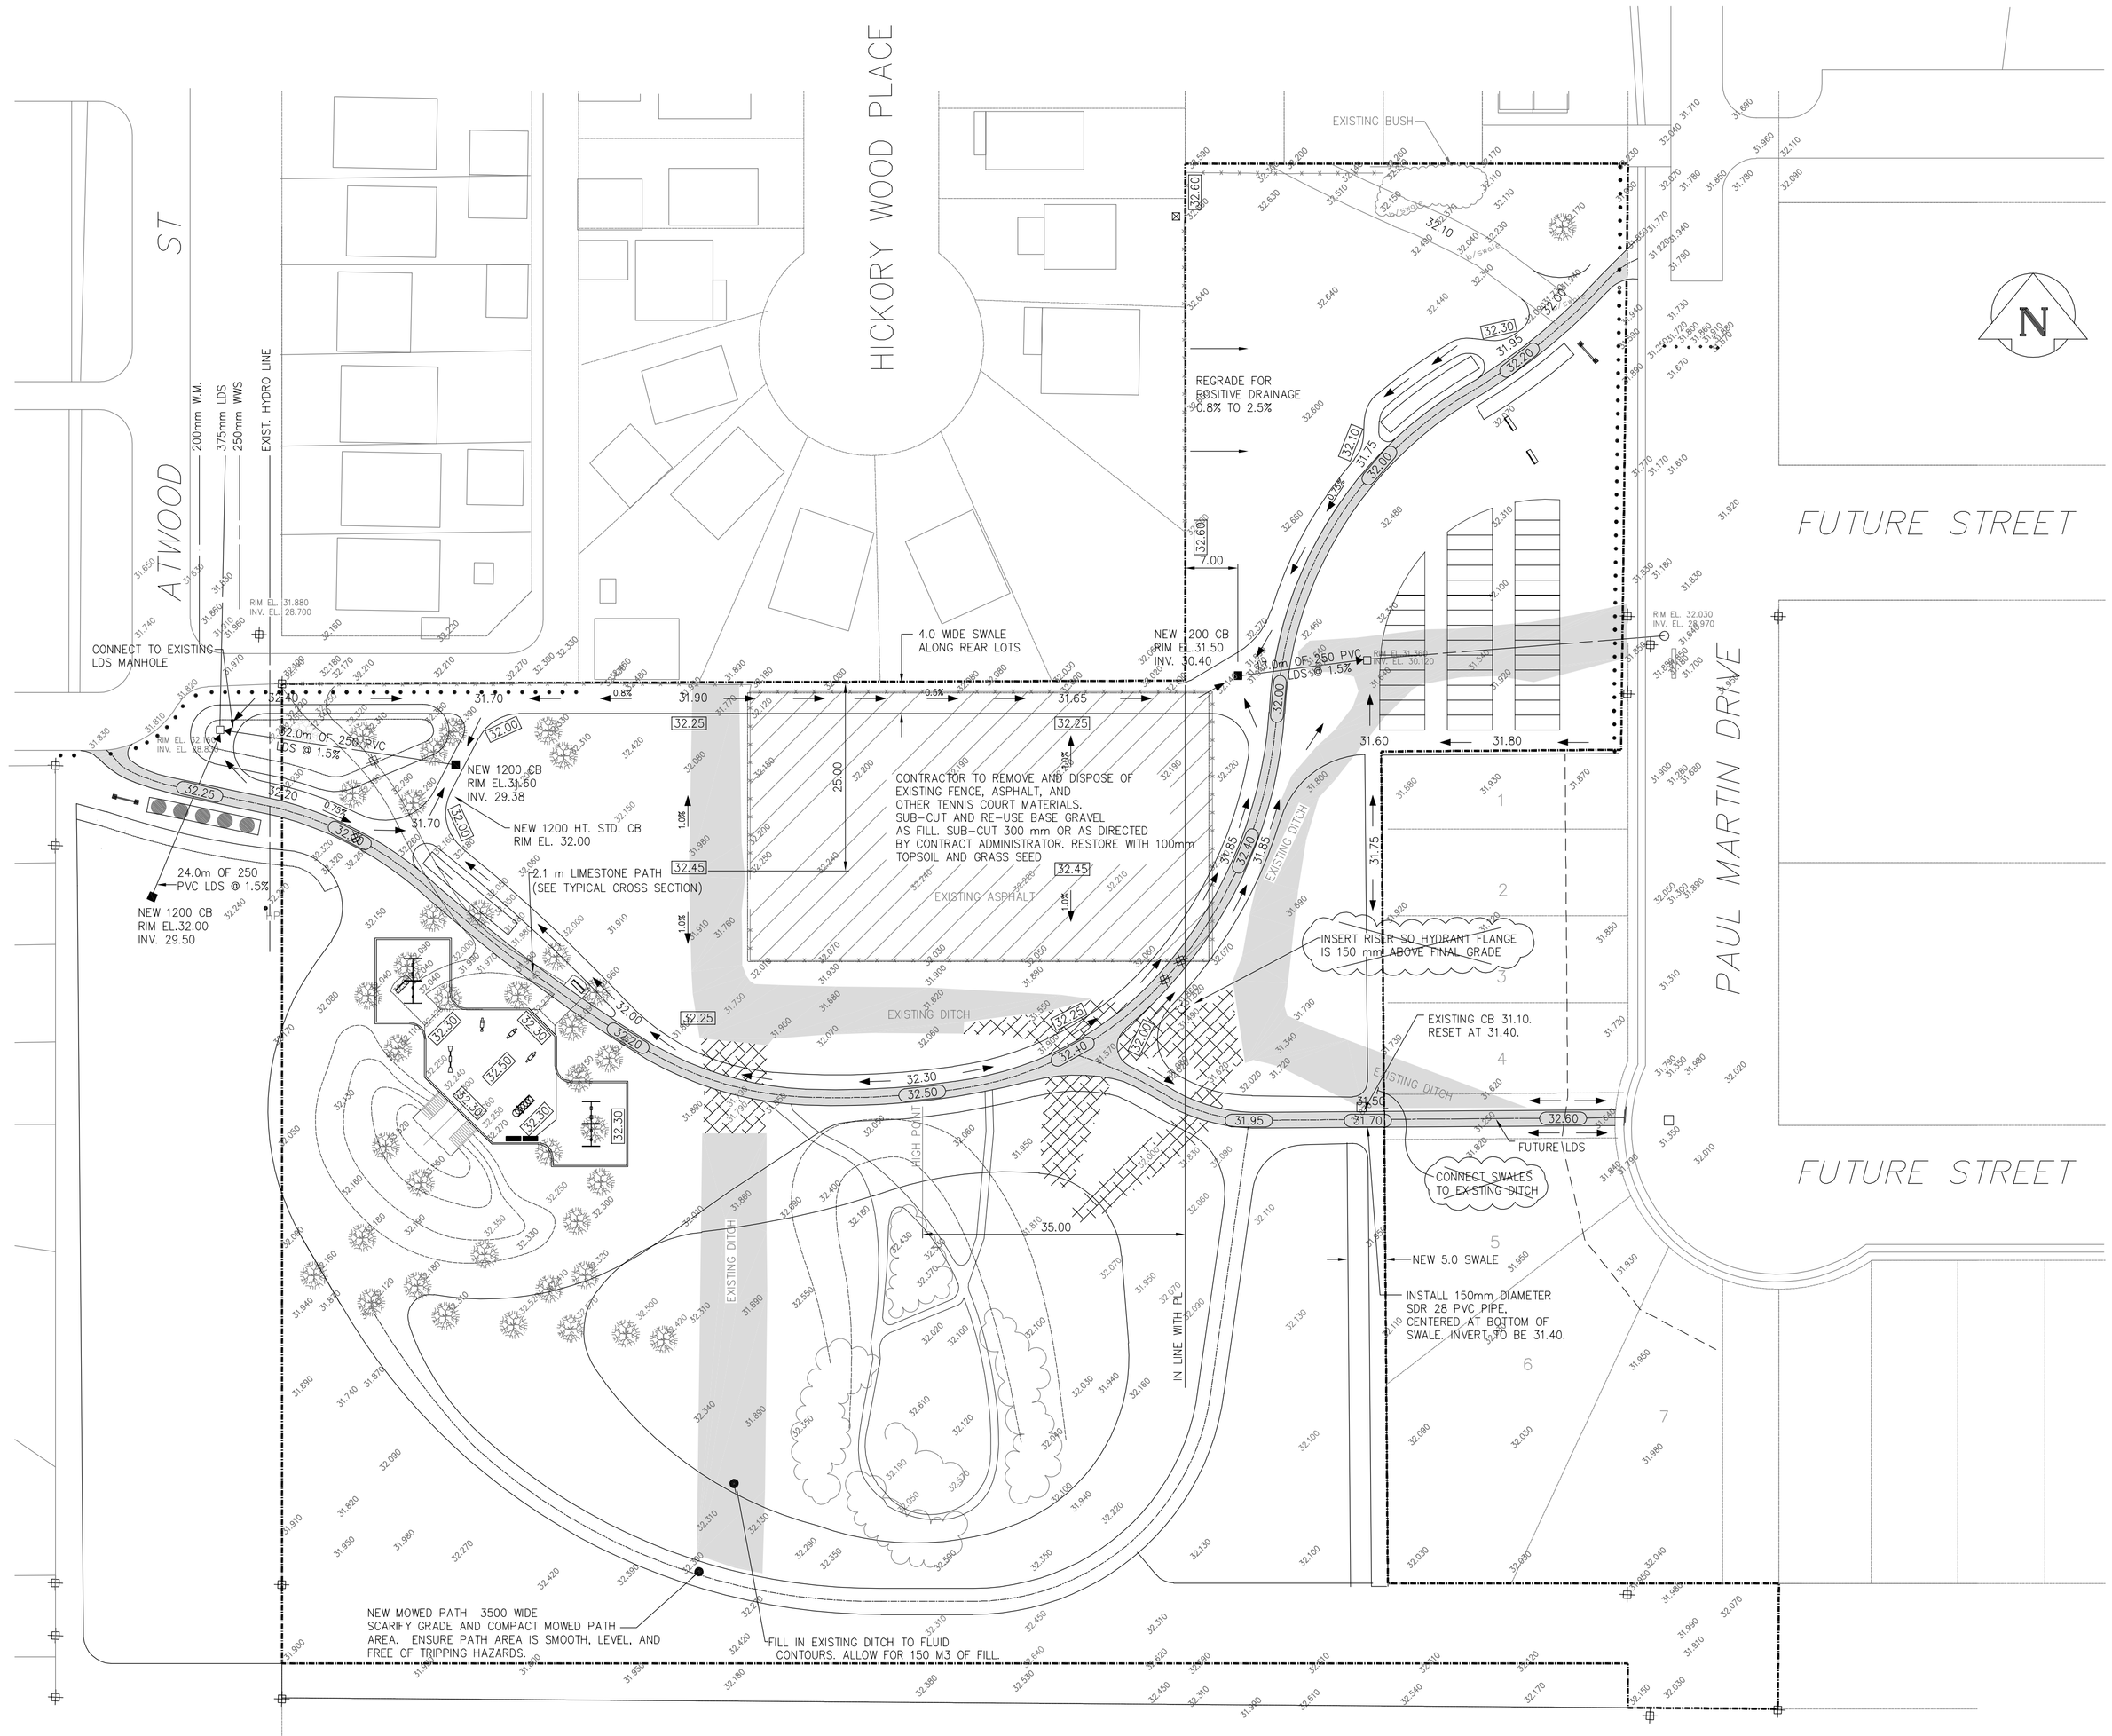

GRADING / DRAINAGE LAYOUT

1:500

LEGEND		
EXISTING		PROPOSED
	TREE	
	HYDRANT	
	FLOW DIRECTION	▲
	CATCHBASIN	■
	WATER VALVE	
	MANHOLE	
	WOOD POST	
	PROPERTY BAR	
31.600	℄ OF PATH ELEVATION	32.00
	BOULEVARD ELEVATION	32.00
	BOTTOM OF SWALE ELEVATION	32.00
	GRADE	1.0%
	DITCH FLOW	
	LIMESTONE PATH	
	FILL IN EXISTING DITCH	
	RE-CONTOURED DITCH	

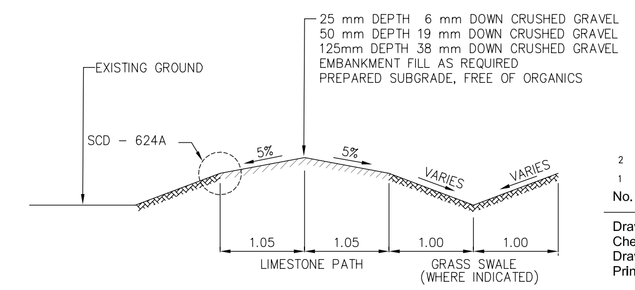

TYPICAL CROSS SECTION

NTS

(VERTICAL EXAGGERATION)

No.	Revision	Date	By
2	SUBDIVISION PATH GRADING	04.07.06	VM
1	GENERAL GRADING	04.04.06	RMB

Drawn By:
Checked By:
Drawing Date:
Printing Date:

The Contractor shall verify all dimensions, datums and levels prior to commencement of work. All errors and omissions to be reported to the Landscape Architect before proceeding.

This drawing must not be scaled.

This drawing is the property of the Landscape Architect; the copyright in same being reserved to her. It is not to be reproduced without her permission.

Any unauthorized alteration of the electronic data which constitute this document will void all responsibility for the altered document by the Landscape Architect.

This drawing is not to be used for building purposes until countersigned by:

Seal

PROVINCE OF MANITOBA
K.S. VAN CAMP
Member
10351
REGISTERED PROFESSIONAL ENGINEER

CYNTHIA COHLMEYER
LANDSCAPE ARCHITECT

359 McDermot Avenue
Winnipeg MB R3A 0A6
TEL (204) 943-1394
FAX 942-4426

cynthia@cohlarch.ca

ROBSON ATWOOD PARK
Winnipeg, Manitoba
June, 2004

Sheet Title: GRADING/DRAINAGE LAYOUT

Project No. C0322

Sheet No. L-2R

NDLEA Engineers & Planners Inc.
Suite 111-93 Lombard Avenue Winnipeg, Manitoba R3B 3B1
Phone (204) 943-3178 Facsimile (204) 943-4948

NOTE:
These design documents are prepared solely for the use by the party with whom the design professional has entered into a contract and there are no representations of any kind made by the design professional to any party with whom the design professional has not entered into a contract.