


SHEET: TBLOCK-FIG-A1 (11/2004)

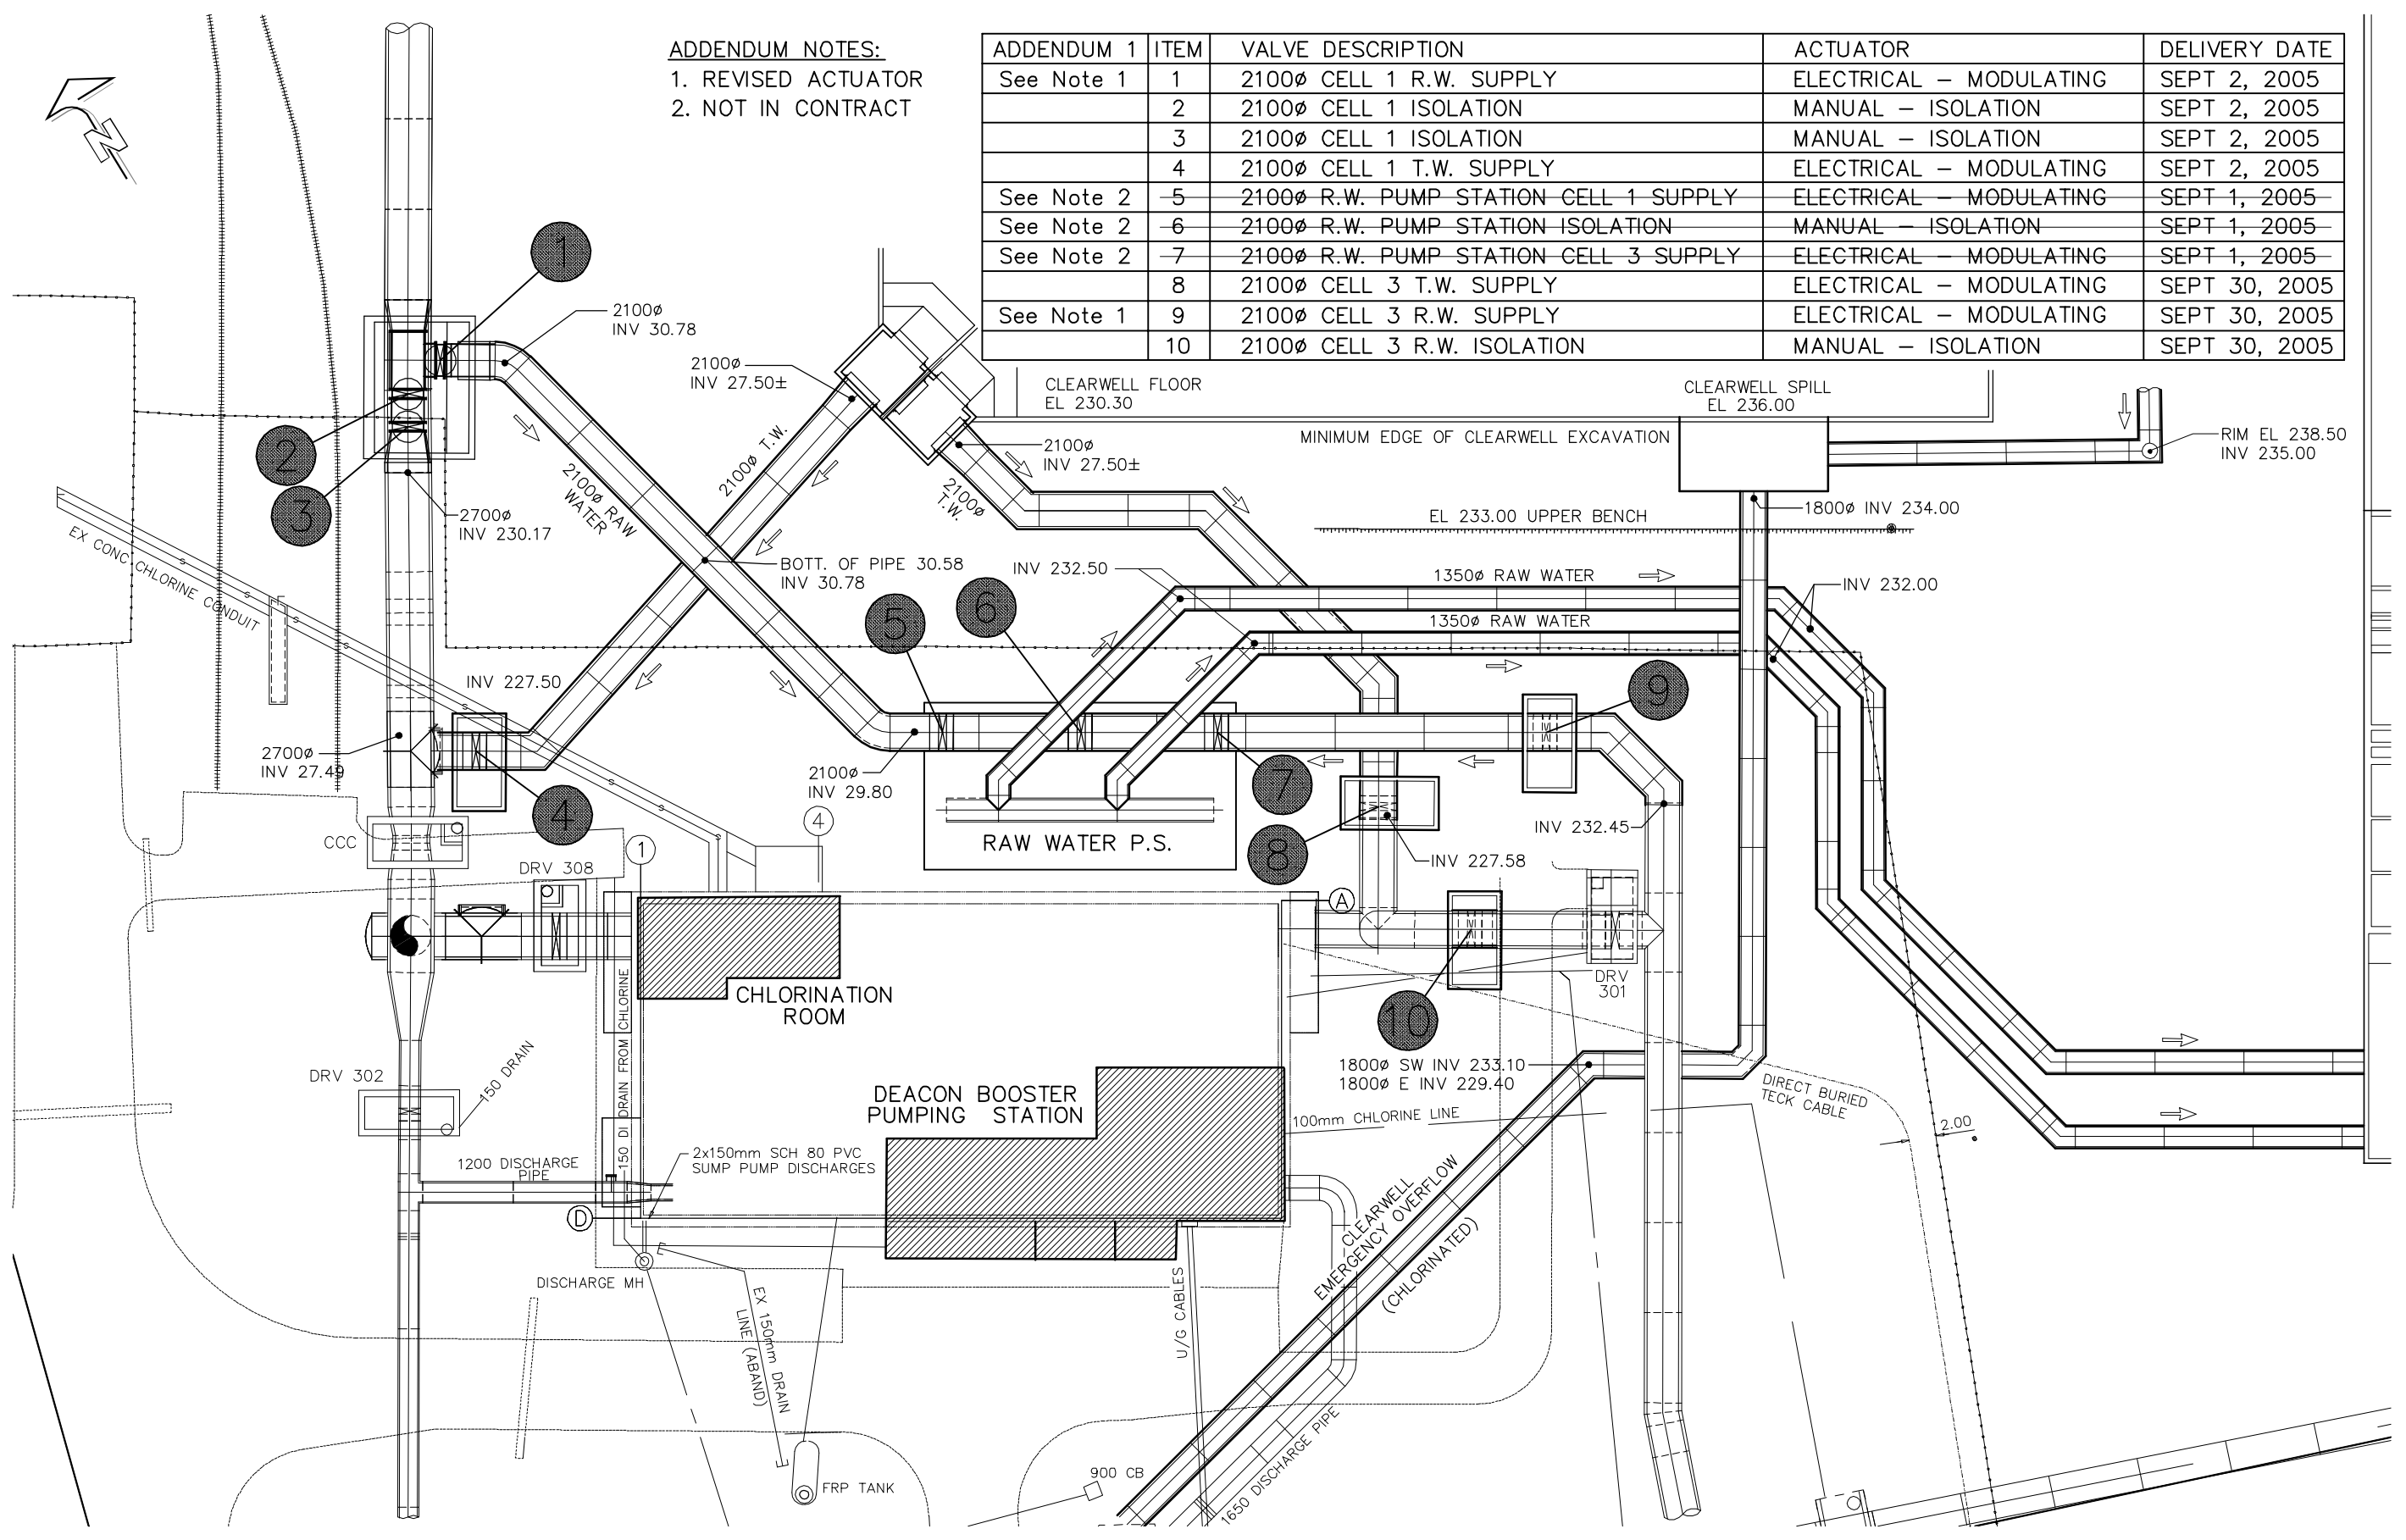

**ADDENDUM NOTES:**  
 1. REVISED ACTUATOR  
 2. NOT IN CONTRACT

ADDENDUM 1	ITEM	VALVE DESCRIPTION	ACTUATOR	DELIVERY DATE
See Note 1	1	2100ø CELL 1 R.W. SUPPLY	ELECTRICAL - MODULATING	SEPT 2, 2005
	2	2100ø CELL 1 ISOLATION	MANUAL - ISOLATION	SEPT 2, 2005
	3	2100ø CELL 1 ISOLATION	MANUAL - ISOLATION	SEPT 2, 2005
	4	2100ø CELL 1 T.W. SUPPLY	ELECTRICAL - MODULATING	SEPT 2, 2005
See Note 2	-5	2100ø R.W. PUMP STATION CELL 1 SUPPLY	ELECTRICAL - MODULATING	SEPT 1, 2005
See Note 2	-6	2100ø R.W. PUMP STATION ISOLATION	MANUAL - ISOLATION	SEPT 1, 2005
See Note 2	-7	2100ø R.W. PUMP STATION CELL 3 SUPPLY	ELECTRICAL - MODULATING	SEPT 1, 2005
	8	2100ø CELL 3 T.W. SUPPLY	ELECTRICAL - MODULATING	SEPT 30, 2005
See Note 1	9	2100ø CELL 3 R.W. SUPPLY	ELECTRICAL - MODULATING	SEPT 30, 2005
	10	2100ø CELL 3 R.W. ISOLATION	MANUAL - ISOLATION	SEPT 30, 2005



02/03/05 08:19am wdenoude P:\3398\055-00\AutoCAD\C-01 Working Drawings\W-02-C0003.dwg LayoutLayout1



THE CITY OF WINNIPEG WATER TREATMENT PLANT  
 CONCEPTUAL YARD PIPING  
 VALVE LOCATION PLAN  
 SK-01- REVISED ADDENDUM 2