



ROOF CONSTRUCTION (TYP)
 2-PLY MOD-BIT MEMBRANE RFG
 (2) LAYERS RECOVERY BOARD
 125mm RIGID TYPE 4 INSULATION
 TORCH-ON MEMBRANE AVB
 13mm EXTERIOR DRYWALL
 38mm METAL ROOF DECKING
 METAL ROOF JOISTS

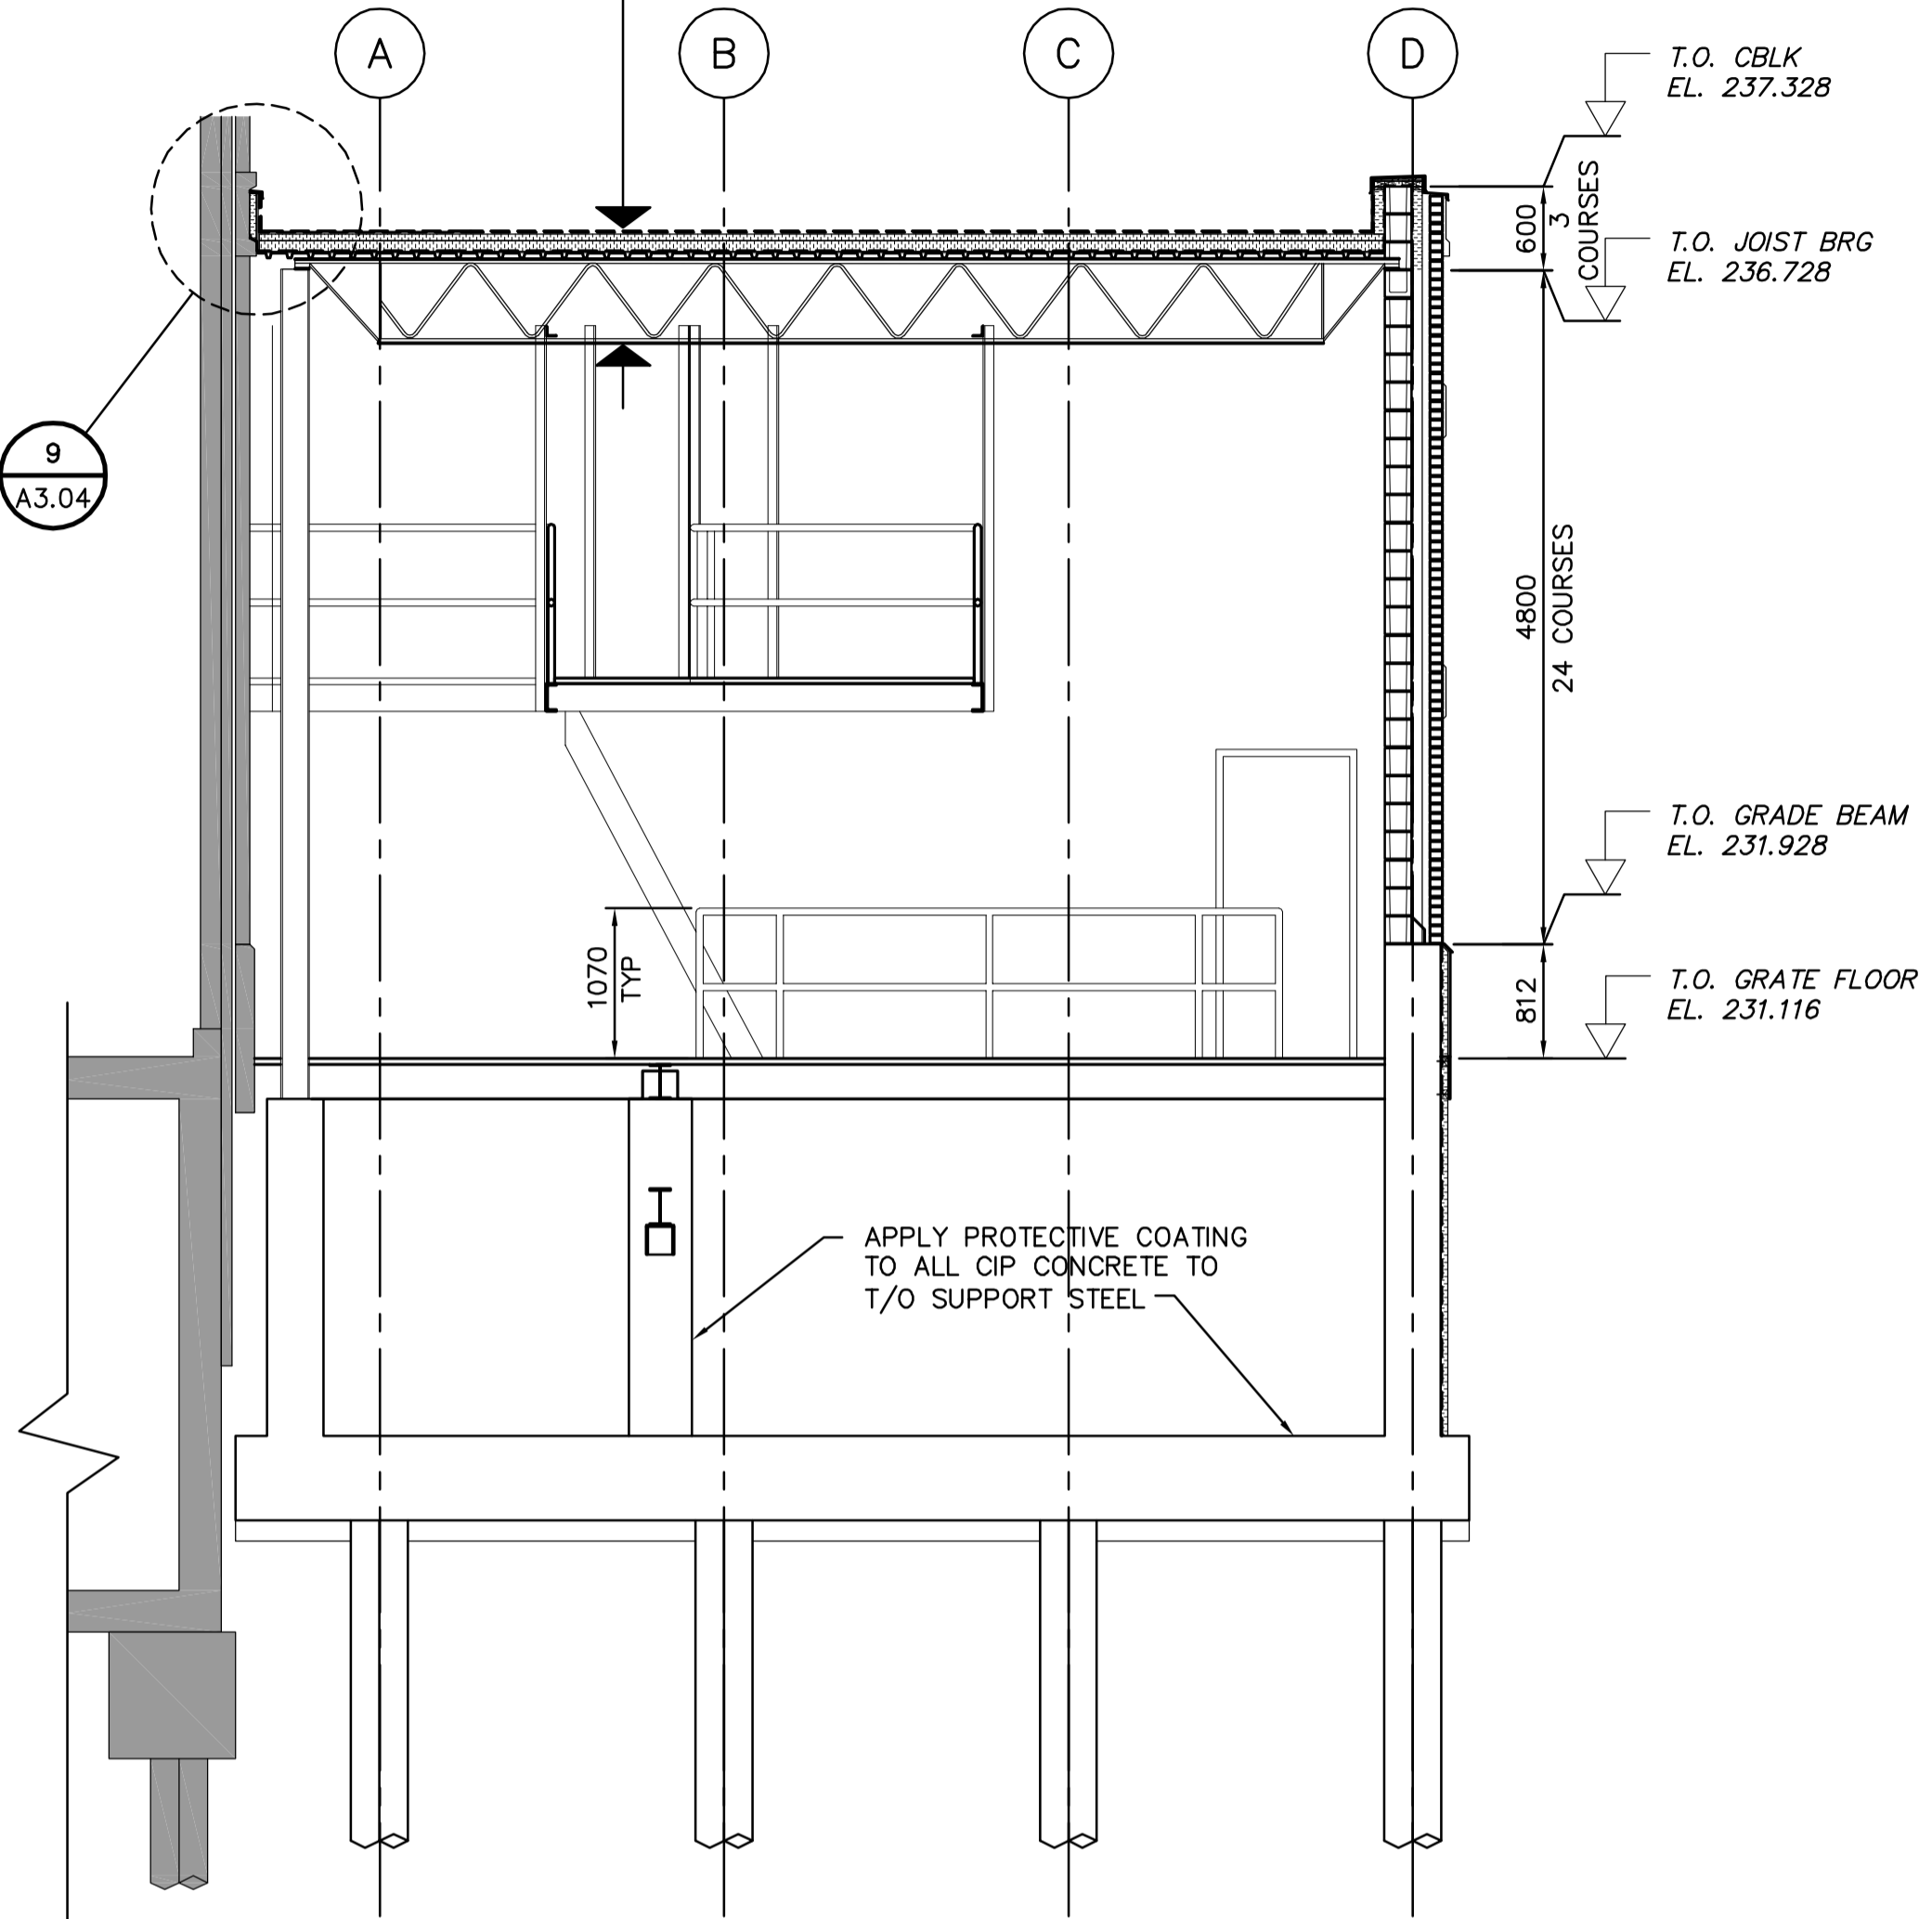


1 BUILDING SECTION
 SCALE 1:50

WALL CONSTRUCTION (TYP)
 90mm FACE BRICK
 55mm AIR SPACE
 75mm RIGID INSULATION
 SA MEMBRANE AVB
 190mm CONCRETE BLOCK

FDN WALL CONST (TYP)
 20 GA GI SKIRTING 300 DEEP,
 START @ BASE OF LEDGER
 ANGLE
 50mm RIGID INSULATION TO
 BOTTOM OF FNDN WALL C/W
 "THERMO-STUD" FLASHING
 SYS.
 MOISTURE BARRIER TO BOTTOM
 OF FOUNDATION WALL
 CONCRETE GRADE BEAM

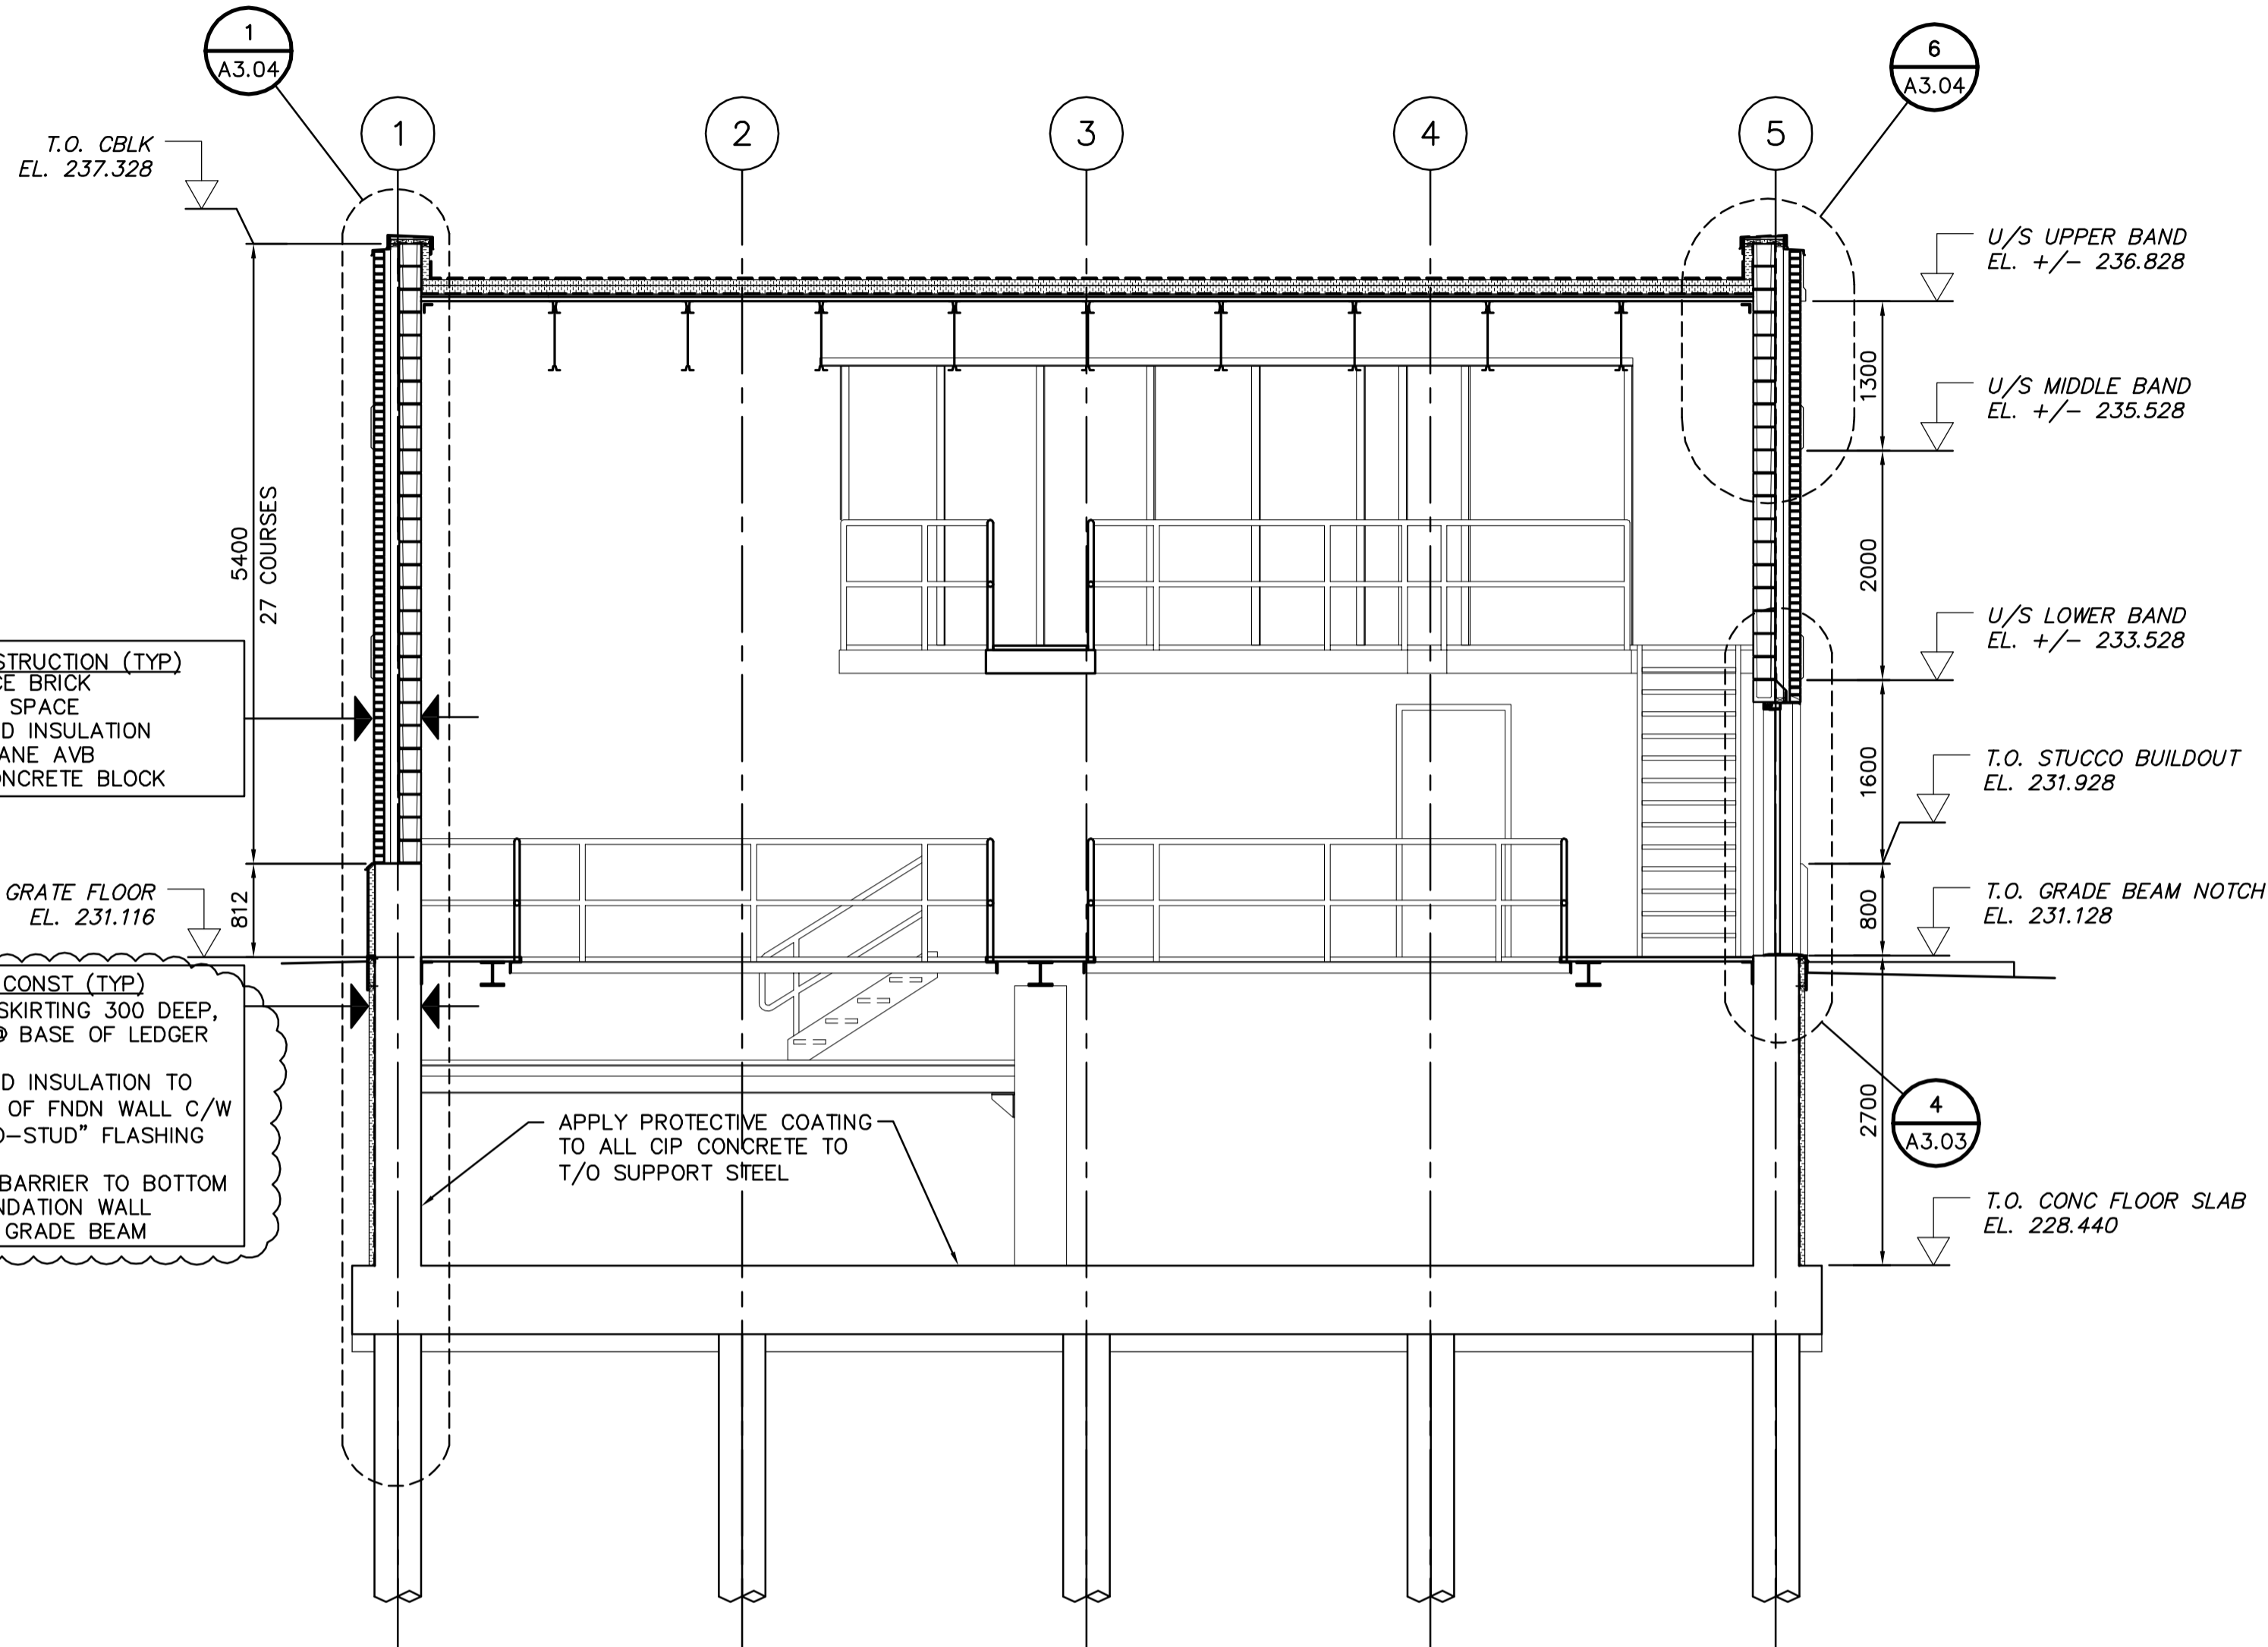


2 BUILDING SECTION
 SCALE 1:50

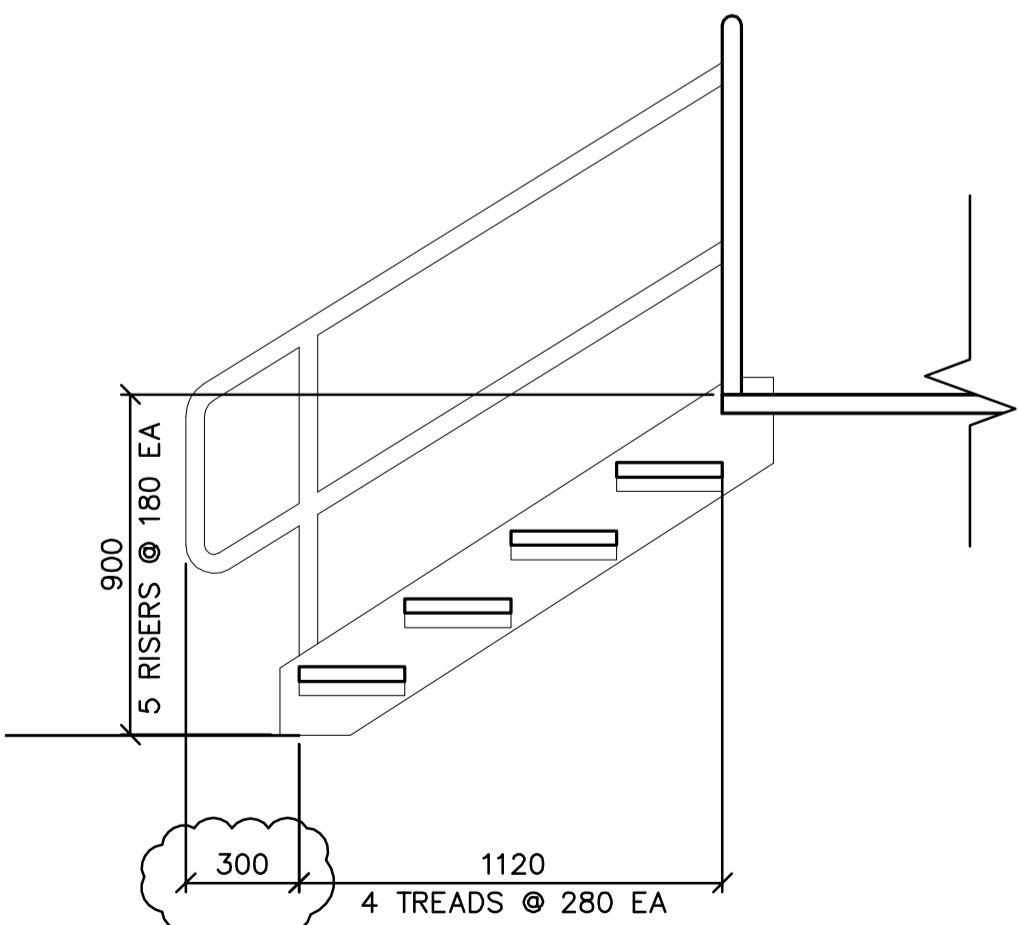

NOTE: SEE STRUCTURAL FOR STAIR DETAILS

3 STAIR DETAIL
 SCALE 1:20

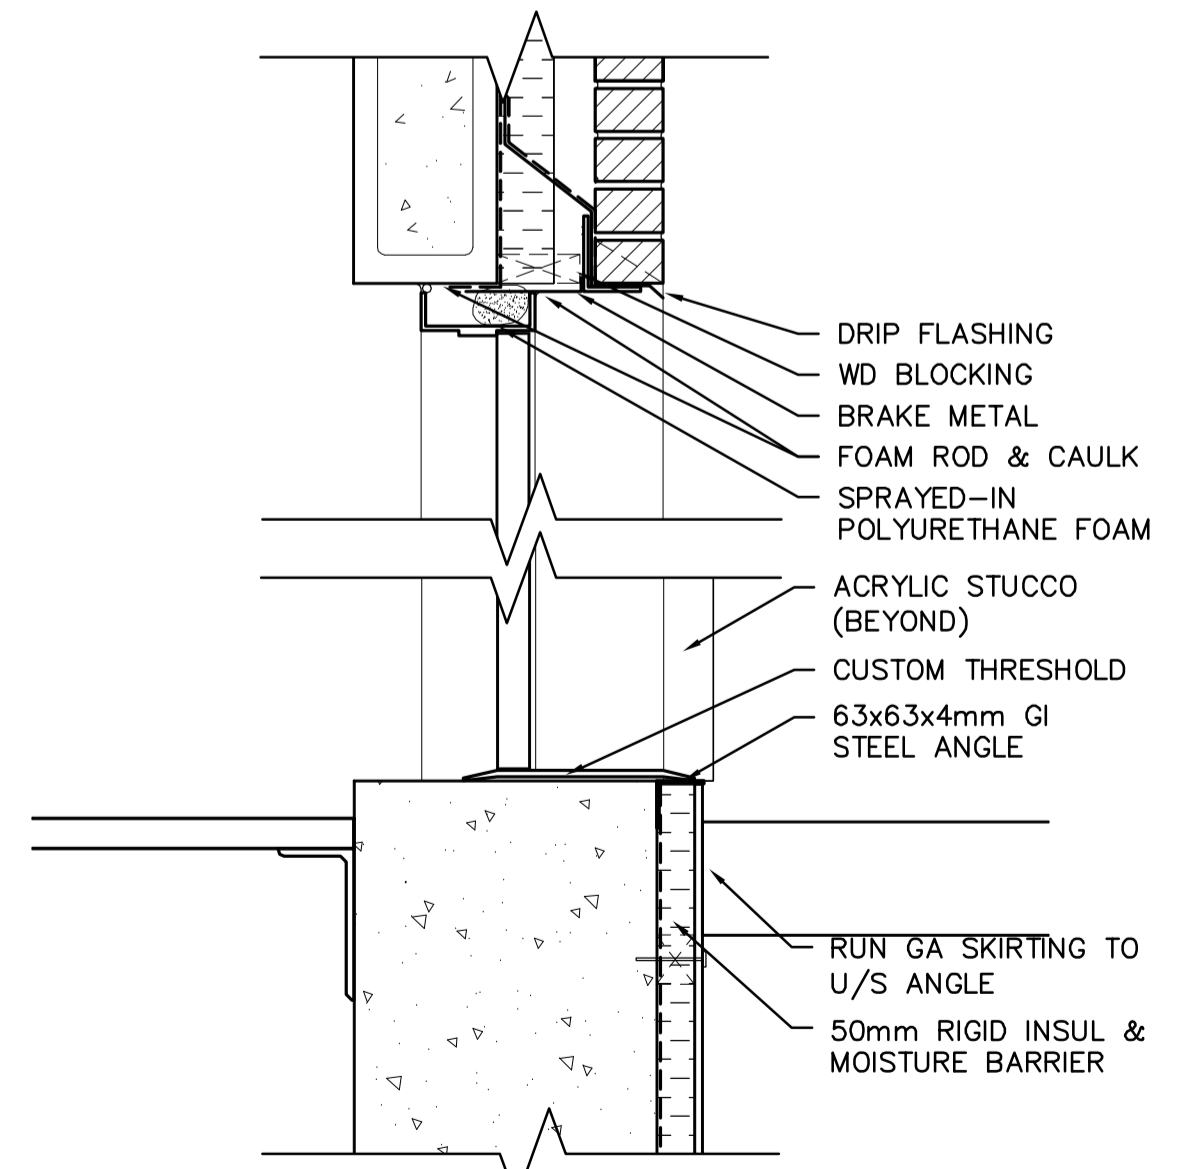

4 DOOR HEAD/SILL DETAIL
 SCALE 1:10



NO.	REVISIONS	DATE	BY
01	611-2005 ADDENDUM 1	06/01/13	LK
00	ISSUED FOR TENDER	05/12/2	LK



DESIGNED BY	NC	CHECKED BY	NC
DRAWN BY	LK	APPROVED BY	D. TANIGUCHI
SCALE:	AS SHOWN	RELEASED FOR CONSTRUCTION BY:	K. MARTENS
DATE	2005/09/28	DATE	05/12/02



THE CITY OF WINNIPEG
WATER AND WASTE DEPARTMENT
ENGINEERING DIVISION

NEWPCC CENTRATE NUTRIENT TREATMENT
 PHOSPHORUS REMOVAL FACILITY
 CONTRACT No. 1

ARCHITECTURAL
 CHEMICAL STORAGE BUILDING
 BUILDING SECTIONS

CITY FILE NUMBER
 SHEET 3 OF 4
 CITY DRAWING NUMBER
 1-001F-A-B0007-001-01-D