


A A BUILDING SECTION
S19 S22 S20 S22 1:50

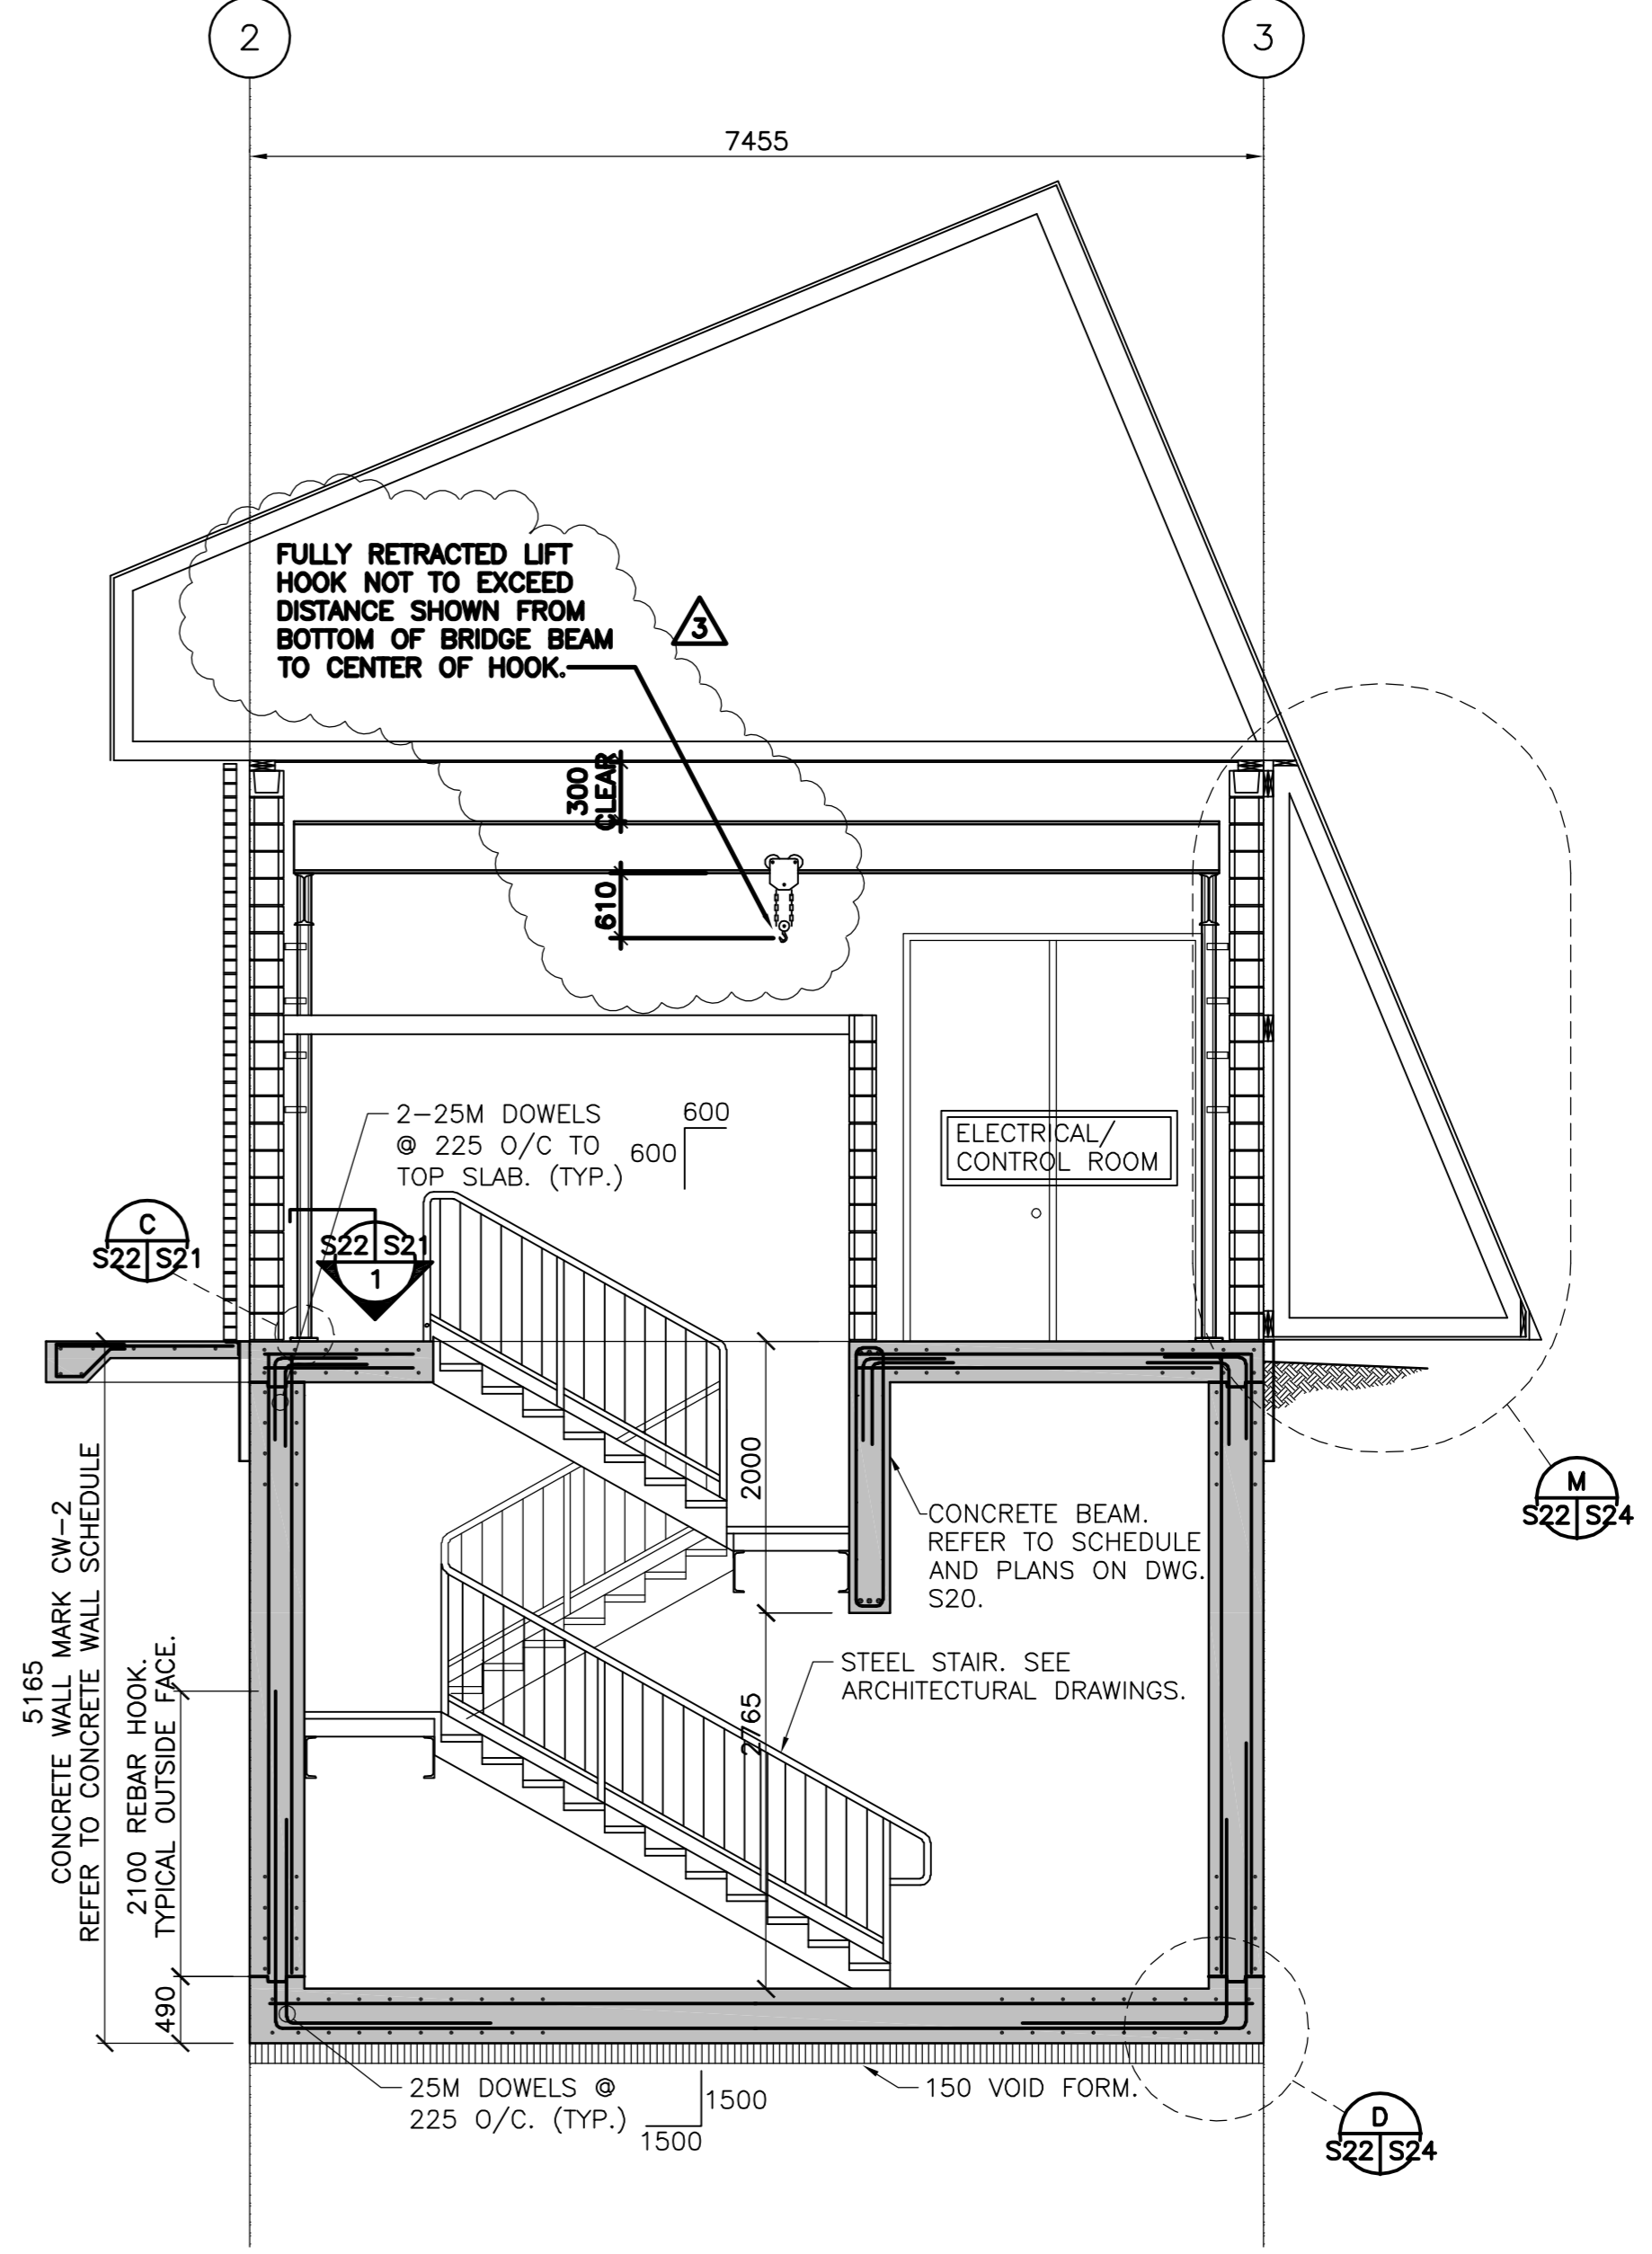

B B BUILDING SECTION
S19 S22 S20 S22 1:50

3 REVISION NUMBER

METRIC
WHOLE NUMBERS INDICATE MILLIMETRES
DECIMALIZED NUMBERS INDICATE METRES

APECM
Certificate of Authorization
Stantec Consulting Ltd.
No. 1301 Expiry: April 30, 2006

LOCATION APPROVED UNDERGROUND STRUCTURES			
SUPPLY U/O STRUCTURES COMMITTEE	DATE		
NOTE: LOCATION OF UNDERGROUND STRUCTURES AS SHOWN ARE BASED ON THE BEST INFORMATION AVAILABLE BUT NO GUARANTEE IS GIVEN THAT ALL EXISTING UTILITIES ARE SHOWN OR THAT THE GIVEN LOCATIONS ARE EXACT. CONFIRMATION OF EXISTENCE AND EXACT LOCATION OF ALL SERVICES MUST BE OBTAINED FROM THE INDIVIDUAL UTILITIES BEFORE PROCEEDING WITH CONSTRUCTION.			

B.M. ELEV.	NO.	REVISIONS	DATE	BY
	3	SAFETY RAILING	06.01.08	K.W.C.
	2	ISSUED FOR TENDER	05.12.09	K.W.C.
	1	ISSUED FOR CLIENT REVIEW	05.11.24	K.W.C.
	0	ISSUED FOR CLIENT REVIEW	05.10.14	K.W.C.

Stantec Consulting Ltd.
905 Waverley Street, Winnipeg, Manitoba
Tel 204-489-5900 Fax 204-453-9012

DESIGNED BY	P.W.	CHECKED BY	K.W.C.
DRAWN BY	V.J.F.	APPROVED BY	W.S.
HOR. SCALE:	AS SHOWN	AUTHORIZED BY:	R. FINGAS 05.12.09
VERTICAL:		R. FINGAS, P. ENG.	BRIDGE PROJECTS ENGINEER
DATE	05.09.13	CONSULTANT DRAWING NO.	I13703042-S22

ENGINEER'S SEAL
ORIGINAL SEALED BY
K.W. CHARLESON
P. ENG.
05.12.09

THE CITY OF WINNIPEG
PUBLIC WORKS DEPARTMENT
ENGINEERING DIVISION

Winnipeg

KENASTON UNDERPASS
KENASTON UNDERPASS PUMPING STATION

STRUCTURAL - BUILDING SECTIONS

SHEET 7 OF 25
CAD FILE DRAWING NUMBER 113703042-S19.dwg
CITY DRAWING NUMBER P-3258-151