


THIS DRAWING TO REPLACE DRAWING 1/A-3

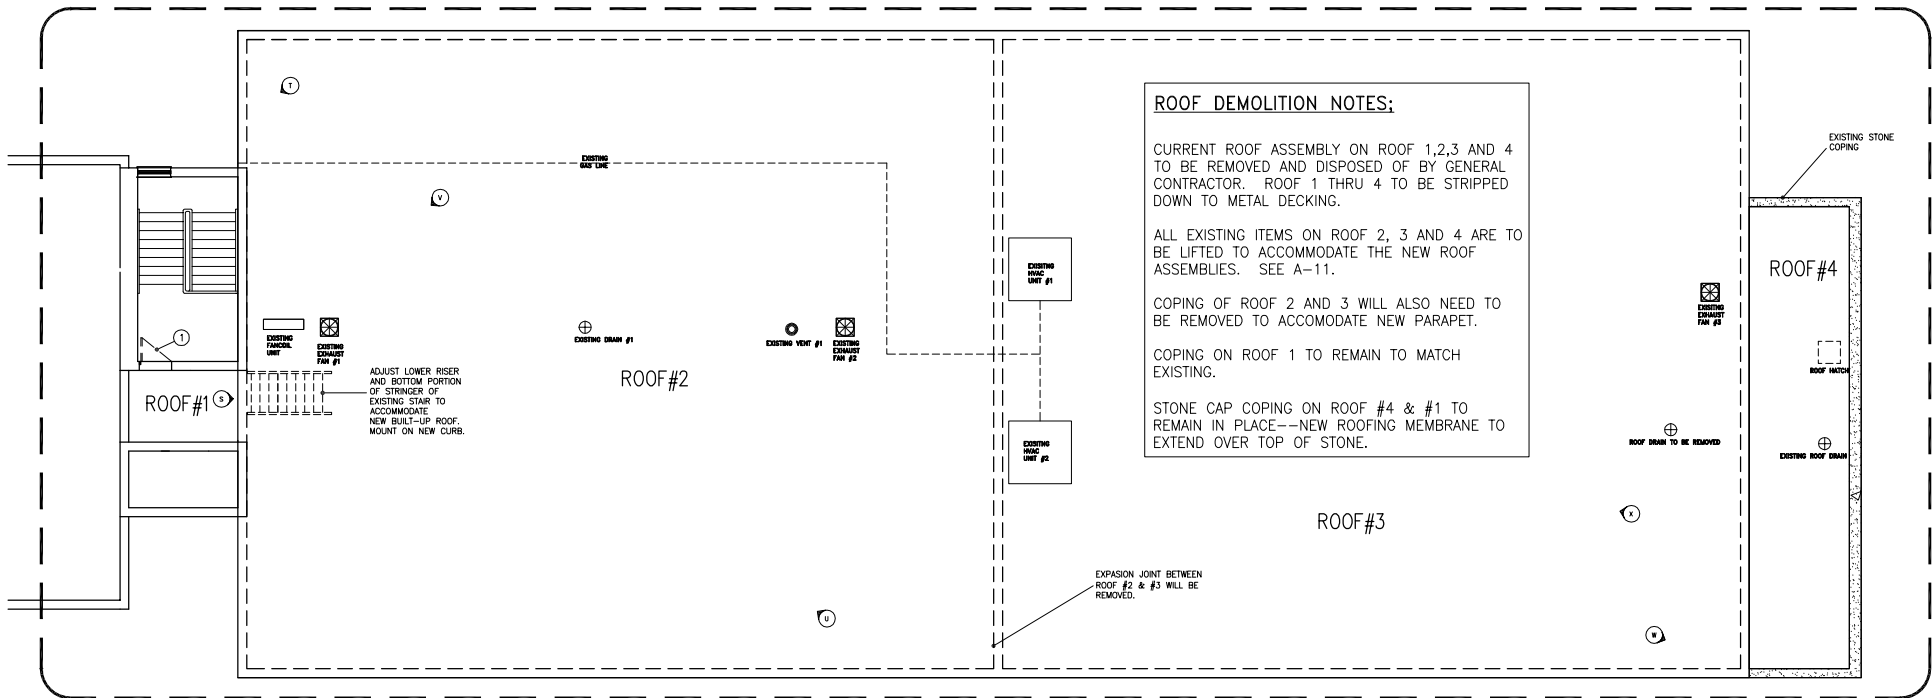

ROOF DEMOLITION NOTES:

CURRENT ROOF ASSEMBLY ON ROOF 1,2,3 AND 4 TO BE REMOVED AND DISPOSED OF BY GENERAL CONTRACTOR. ROOF 1 THRU 4 TO BE STRIPPED DOWN TO METAL DECKING.

ALL EXISTING ITEMS ON ROOF 2, 3 AND 4 ARE TO BE LIFTED TO ACCOMMODATE THE NEW ROOF ASSEMBLIES. SEE A-11.

COPING OF ROOF 2 AND 3 WILL ALSO NEED TO BE REMOVED TO ACCOMMODATE NEW PARAPET.

COPING ON ROOF 1 TO REMAIN TO MATCH EXISTING.

STONE CAP COPING ON ROOF #4 & #1 TO REMAIN IN PLACE--NEW ROOFING MEMBRANE TO EXTEND OVER TOP OF STONE.

1
RA-1

REV. ROOF DEMOLITION

SCALE = NTS

THIS DRAWING MUST NOT BE SCALED.

THE GENERAL CONTRACTOR SHALL VERIFY ALL DIMENSIONS, DATUMS, AND LEVELS PRIOR TO COMMENCEMENT OF WORK. ALL ERRORS AND OMISSIONS TO BE REPORTED TO NUMBER TEN ARCHITECTURAL GROUP BEFORE PROCEEDING.

VARIATIONS AND MODIFICATIONS TO WORK SHOWN ON THESE DRAWINGS SHALL NOT BE CARRIED OUT WITHOUT WRITTEN PERMISSION OF NUMBER TEN ARCHITECTURAL GROUP.

THIS DRAWING IS THE EXCLUSIVE PROPERTY OF NUMBER TEN ARCHITECTURAL GROUP AND THE COPYRIGHT IN THE SAME BEING RESERVED TO THEM. IT MAY BE REPRODUCED ONLY WITH THE PERMISSION OF NUMBER TEN ARCHITECTURAL GROUP, IN WHICH CASE THE REPRODUCTION MUST BEAR THEIR NAME.

project: CONSTRUCTION OF AN ALTERNATE EMERGENCY COMMUNICATIONS CTR.
sheet title: REVISIONS TO ROOF DEMOLITION

scale: AS SHOWN
drawn by: KF
checked by: KF
date: 27/03/06

project no. 04136
sheet no. RA-1

310 - 115 bannatyne ave.
winnipeg MB canada R3B 0R3
204 942.0981 f 204 947.9626
10@numberten.com

numberTEN
architectural group

112 - 826 north park dr.
victoria BC canada V8W 3B4
250 360.2106 f 250 360.2166
numberten@telus.net

