


1 **REV. ROOF PLAN** THIS DRAWING TO REPLACE DRAWING 1/A-11
 RA-2 SCALE = NTS

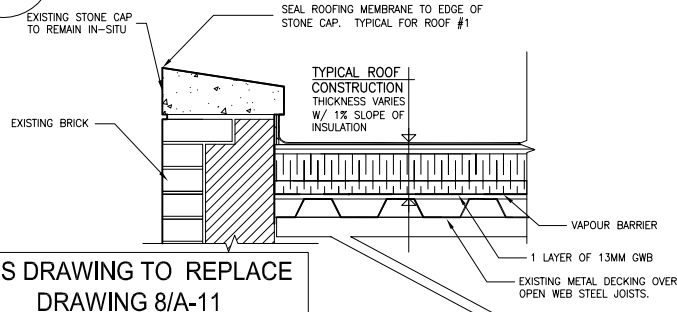

THIS DRAWING TO REPLACE DRAWING 8/A-11

2 **REV. COPING DETAIL**
 RA-2 SCALE = 1:20

ROOFING LEGEND

- ROOF AREAS TO RECEIVE NEW MEMBRANE AND MINIMUM R-20 INSULATION UPGRADE.
- AS PER ABOVE BUT WITH ADDITIONAL 1% SLOPED INSULATION.
- ROOF AREAS TO RECEIVE NEW MEMBRANES & INSULATION UPGRADE.

ROOFING NOTES

ALL EXISTING ITEMS ON ROOF # 2-4 SUCH AS VENTS AND FANCOIL UNITS ARE TO BE LIFTED AS REQUIRED TO ACCOMMODATE THE INSTALLATION OF THE UPGRADED INSULATION AND ROOF MEMBRANE. ROOF 1 TO BE UPGRADED WITH TWO LAYERS OF INSULATION BUT SHALL NOT INTERFERE WITH THE EXISTING COPING OR ACCESS DOOR. ROOF 4 TO RECEIVE NEW INSULATION AND ROOFING MEMBRANE BUT SHALL NOT INVOLVE RAISING THE STONE CAP.

THIS DRAWING MUST NOT BE SCALED.
 THE GENERAL CONTRACTOR SHALL VERIFY ALL DIMENSIONS, DATUMS, AND LEVELS PRIOR TO COMMENCEMENT OF WORK. ALL ERRORS AND OMISSIONS TO BE REPORTED TO NUMBER TEN ARCHITECTURAL GROUP BEFORE PROCEEDING.
 VARIATIONS AND MODIFICATIONS TO WORK SHOWN ON THESE DRAWINGS SHALL NOT BE CARRIED OUT WITHOUT WRITTEN PERMISSION OF NUMBER TEN ARCHITECTURAL GROUP.
 THIS DRAWING IS THE EXCLUSIVE PROPERTY OF NUMBER TEN ARCHITECTURAL GROUP AND THE COPYRIGHT IN THE SAME BEING RESERVED TO THEM. IT MAY BE REPRODUCED ONLY WITH THE PERMISSION OF NUMBER TEN ARCHITECTURAL GROUP, IN WHICH CASE THE REPRODUCTION MUST BEAR THEIR NAME.

project: CONSTRUCTION OF AN ALTERNATE EMERGENCY COMMUNICATIONS CTR.
 sheet title: REVISIONS TO ROOF DESIGN

scale: AS SHOWN
 drawn by: KF
 checked by: KF
 date: 27/03/06

project no. 04136
 sheet no. RA-2

310 - 115 bannatyne ave.
 winnipeg MB canada R3B 0R3
 204 942.0981 f 204 947.9626
 10@number10.com
numberTEN
 architectural group
 112 - 826 north park dr.
 victoria BC canada V8W 3B4
 250 360.2106 f 250 360.2166
 number10@telus.net

