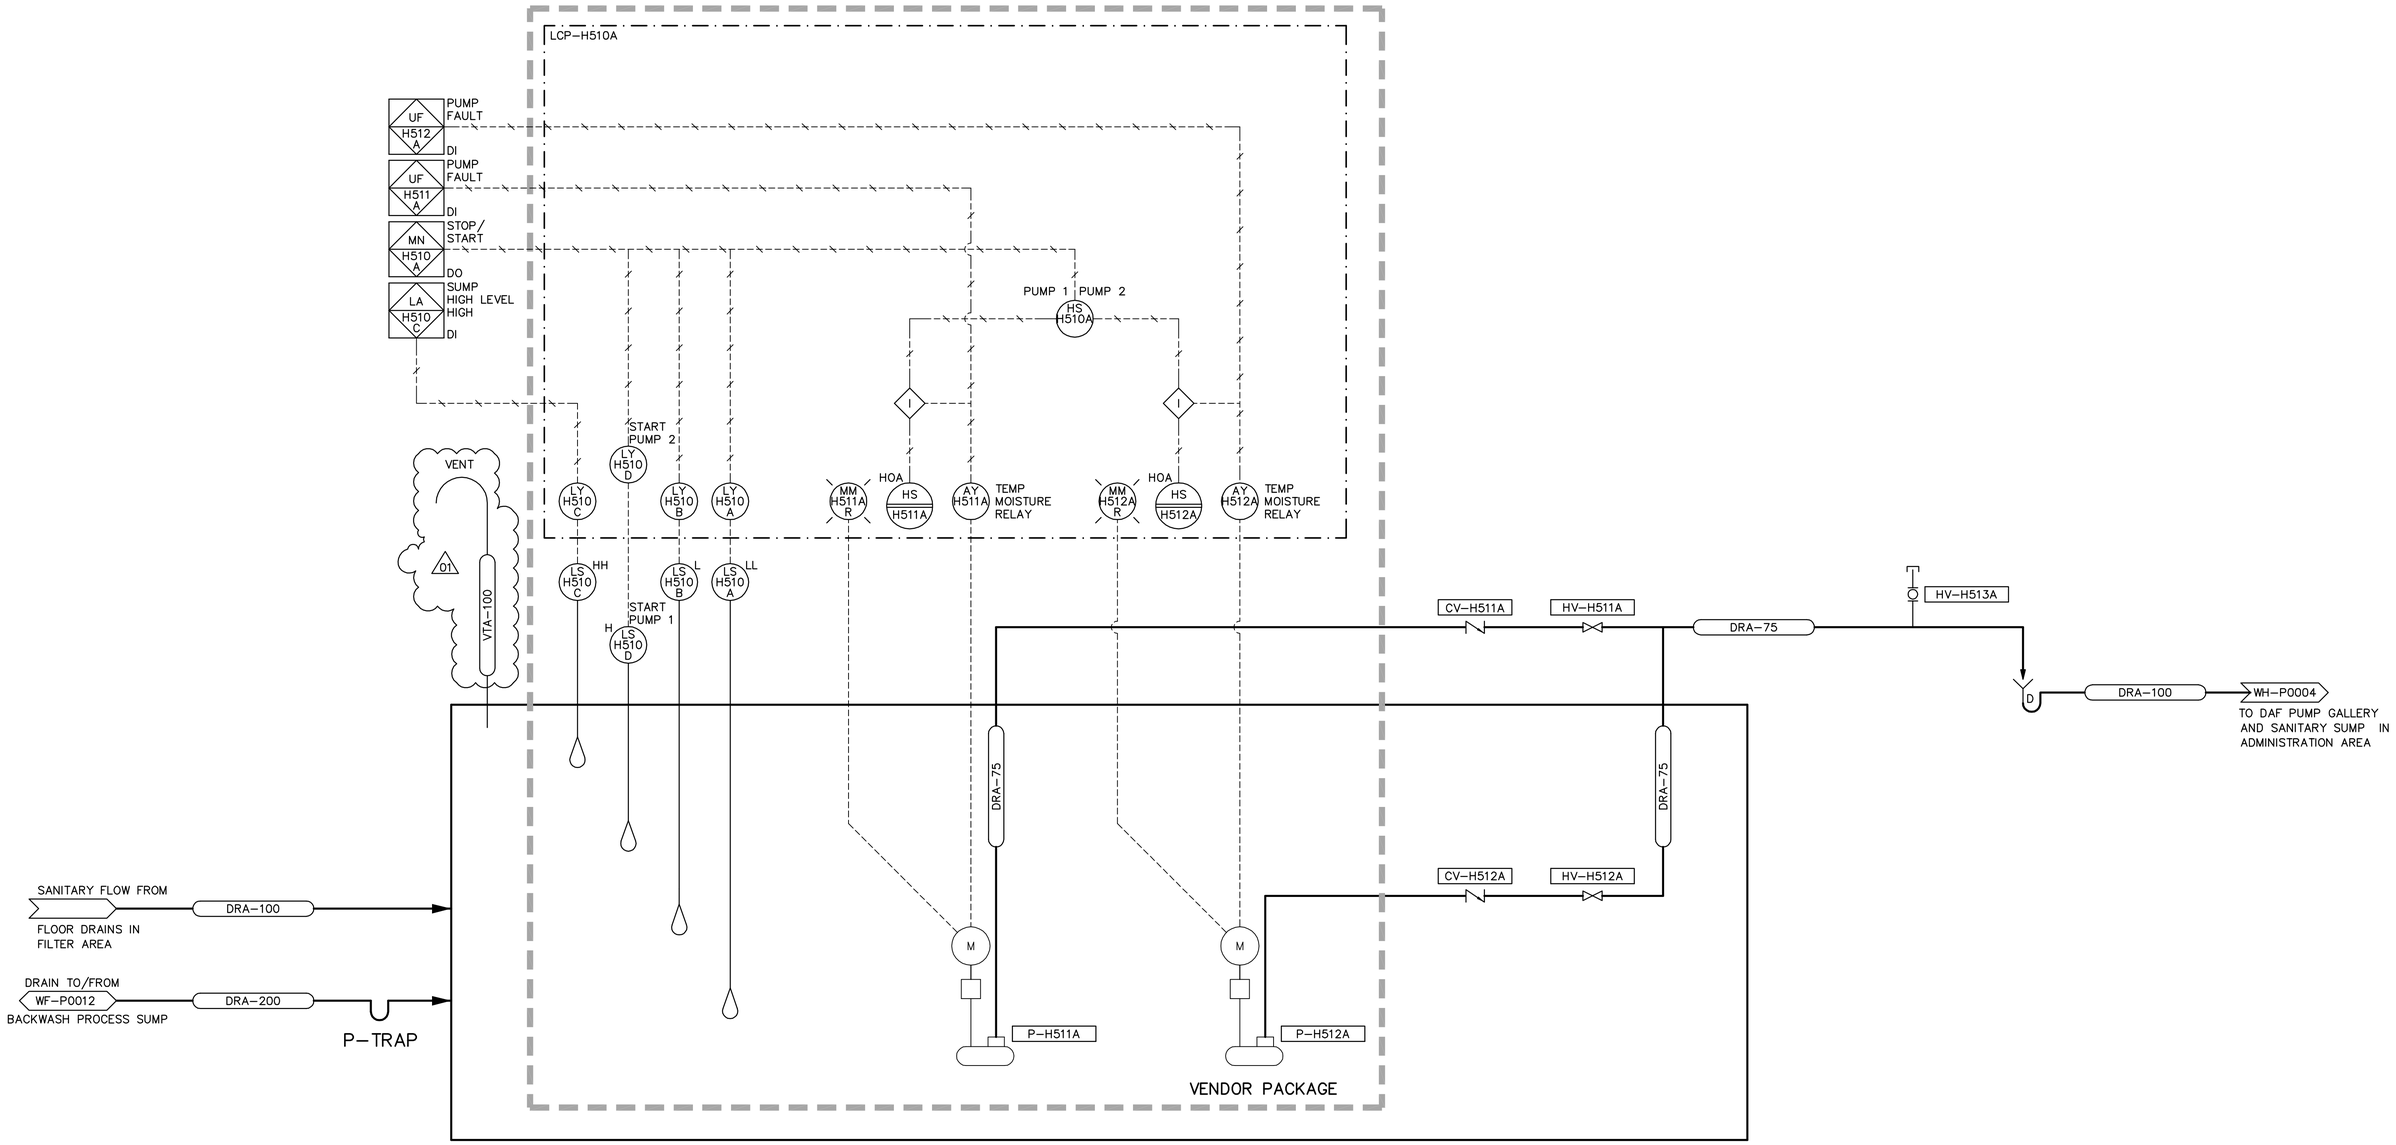

Certificate of Authorization
Earth Tech Canada Inc.
No. 730 Expiry: April 30, 2006

NO.	REVISIONS	DATE	BY
01	742-2005 ADDENDUM 2	06/04/28	GLG
00	ISSUED FOR TENDER	06/03/29	GLG

B.M. ELEV.

CH2MHILL Fredericksen Cooper ARCHITECTS — EarthTech A Tyco International Ltd. Company

DESIGNED BY	SW/JZ	CHECKED BY	DL
DRAWN BY	JMC	APPROVED BY	AHL
SCALE:	NONE	RELEASED FOR CONSTRUCTION BY:	R. SOROKOWSKI
DATE	2005/12/21	DATE	2006/03/29

ENGINEER'S SEAL
ORIGINAL SIGNED BY
D.K. CUDDINGTON AND S.W. TORMEY
2006/03/29

CONSULTANT DRAWING NO.
WH-P0002

THE CITY OF WINNIPEG
WATER AND WASTE DEPARTMENT
ENGINEERING DIVISION

WATER TREATMENT PLANT
PLANT UTILITIES
MECHANICAL AND ELECTRICAL

PROCESS
SANITARY SUMP – BACKWASH PUMP GALLERY
PROCESS AND INSTRUMENTATION DIAGRAM

CITY FILE NUMBER
SHEET OF
CITY DRAWING NUMBER
1-0601H-G-P0002-001-01D

Last Save: 2006-04-18 2:20 PM

L:\WORK\79000\79538\02A-CAD\WAT\CONTR\WTP_DETAIL DESIGN\P&IDS\SANITARY PUMPS\DN_WH-P0002_ET.DWG