



- NOTES:**
1. PROVIDE STAIRWELL SMOKE DETECTORS AS SHOWN ON FIRE PROTECTION DRAWINGS
  2. SEE DRAWING WB-E0401 FOR CABLE TRAY MOUNTING DETAILS.
  3. ALL 120V LOADS ARE FED FROM LP-H31
  4. ALL 600V LOADS ARE FED FROM DP-H31
  5. FOR CABLE TRAY TAGGING SEE DET. 3  
WB-E0455

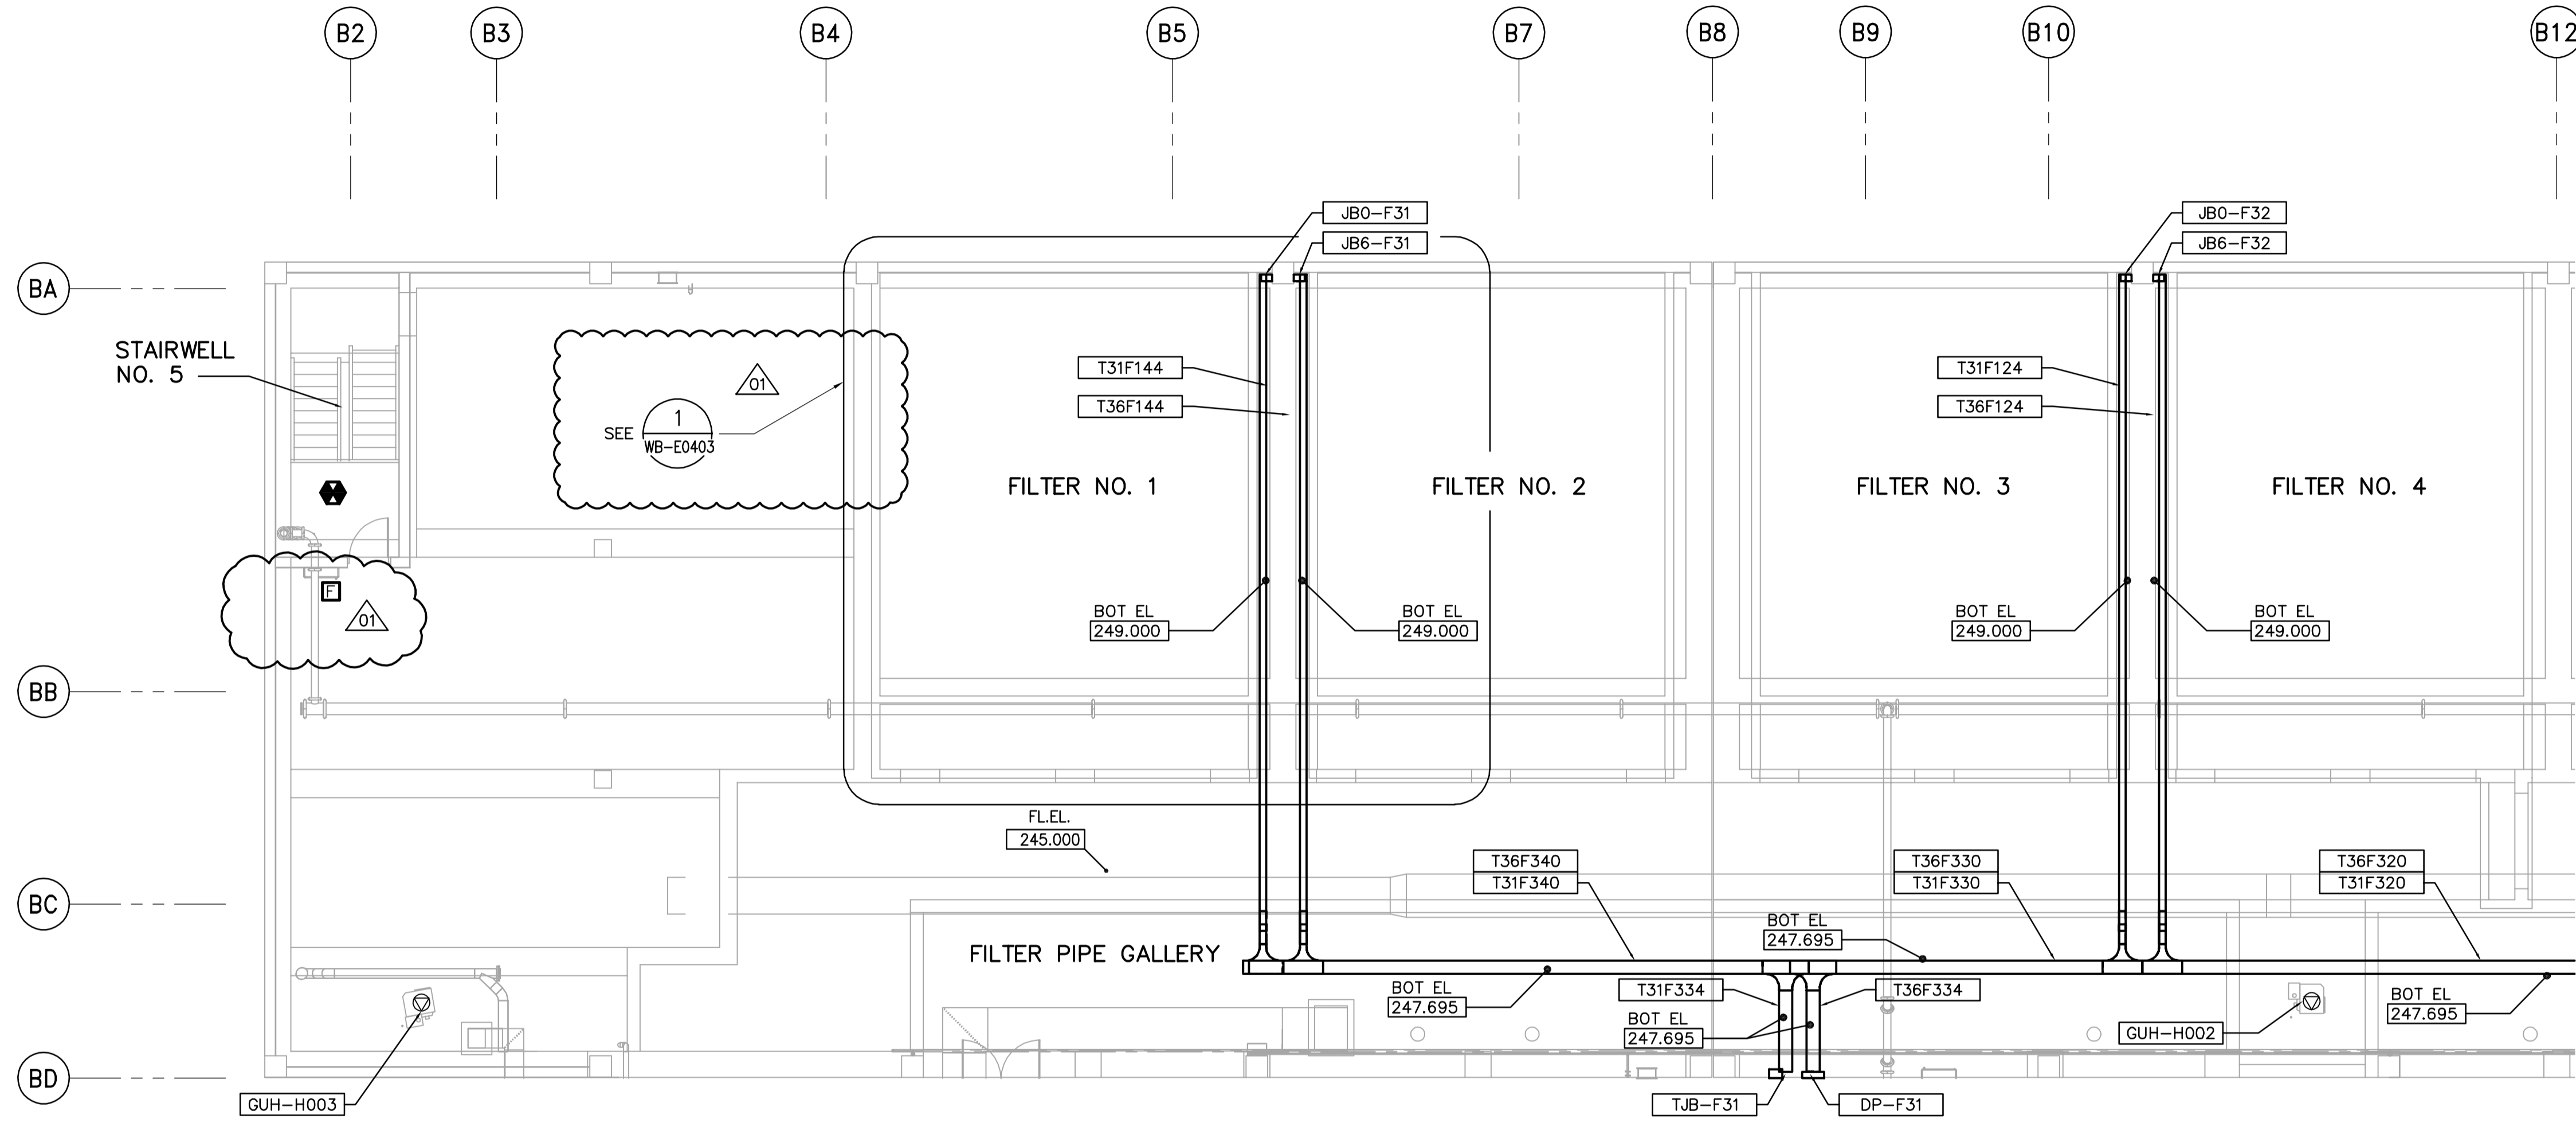

**THIRD FLOOR FACILITY PLAN (AREA 1)**  
1:100

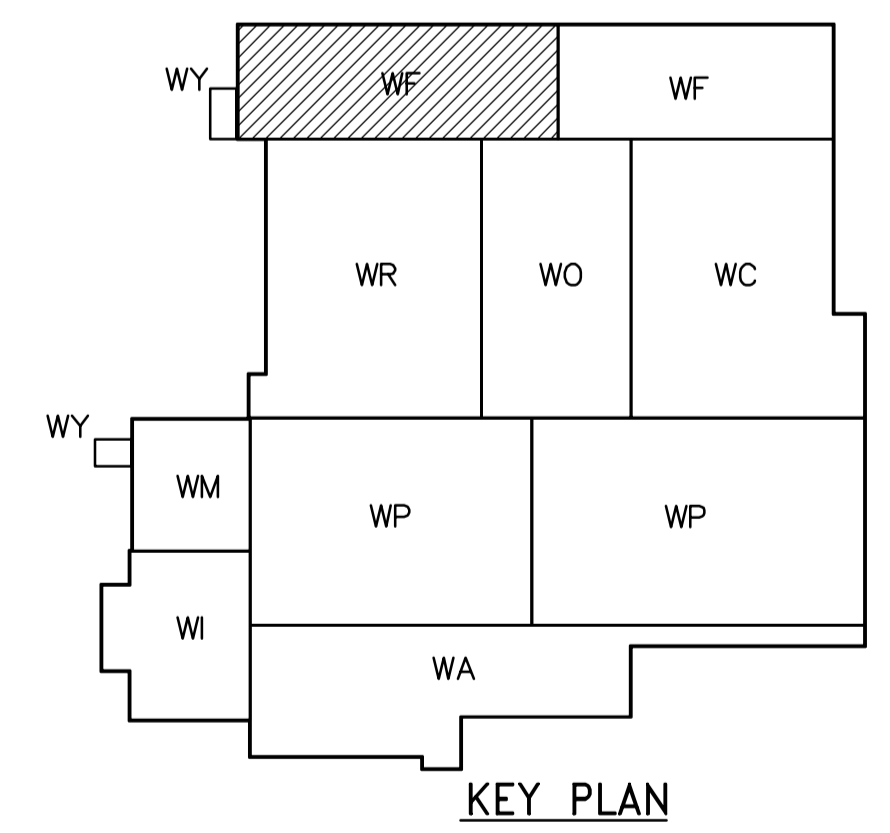

 <b>APEGN</b> Certificate of Authorization CH2M HILL Canada Ltd. No. 1441 Expiry: April 30, 2007	 Frederickson Cooper ARCHITECTS	 A Terra International Ltd. Company	ENGINEER'S SEAL  ORIGINAL SIGNED BY L.D. LLEWELLYN 2006/03/29	 <b>THE CITY OF WINNIPEG</b> WATER AND WASTE DEPARTMENT ENGINEERING DIVISION  WATER TREATMENT PLANT FILTRATION MECHANICAL AND ELECTRICAL	CITY FILE NUMBER SHEET OF
			CONSULTANT DRAWING NO. WF-E0131		ELECTRICAL FILTRATION AREA 1 THIRD FLOOR FACILITY PLAN
DESIGNED BY LL CHECKED BY ND DRAWN BY TL APPROVED BY AHL		SCALE: 1:100 RELEASED FOR CONSTRUCTION BY: R. SOROKOWSKI		DATE 2005/07/13 DATE 2006/03/29	
B.M. ELEV.		NO. REVISIONS DATE BY		NO. REVISIONS DATE BY	