SHEET: COW-A1 (05/2005)

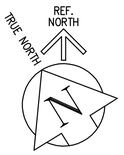

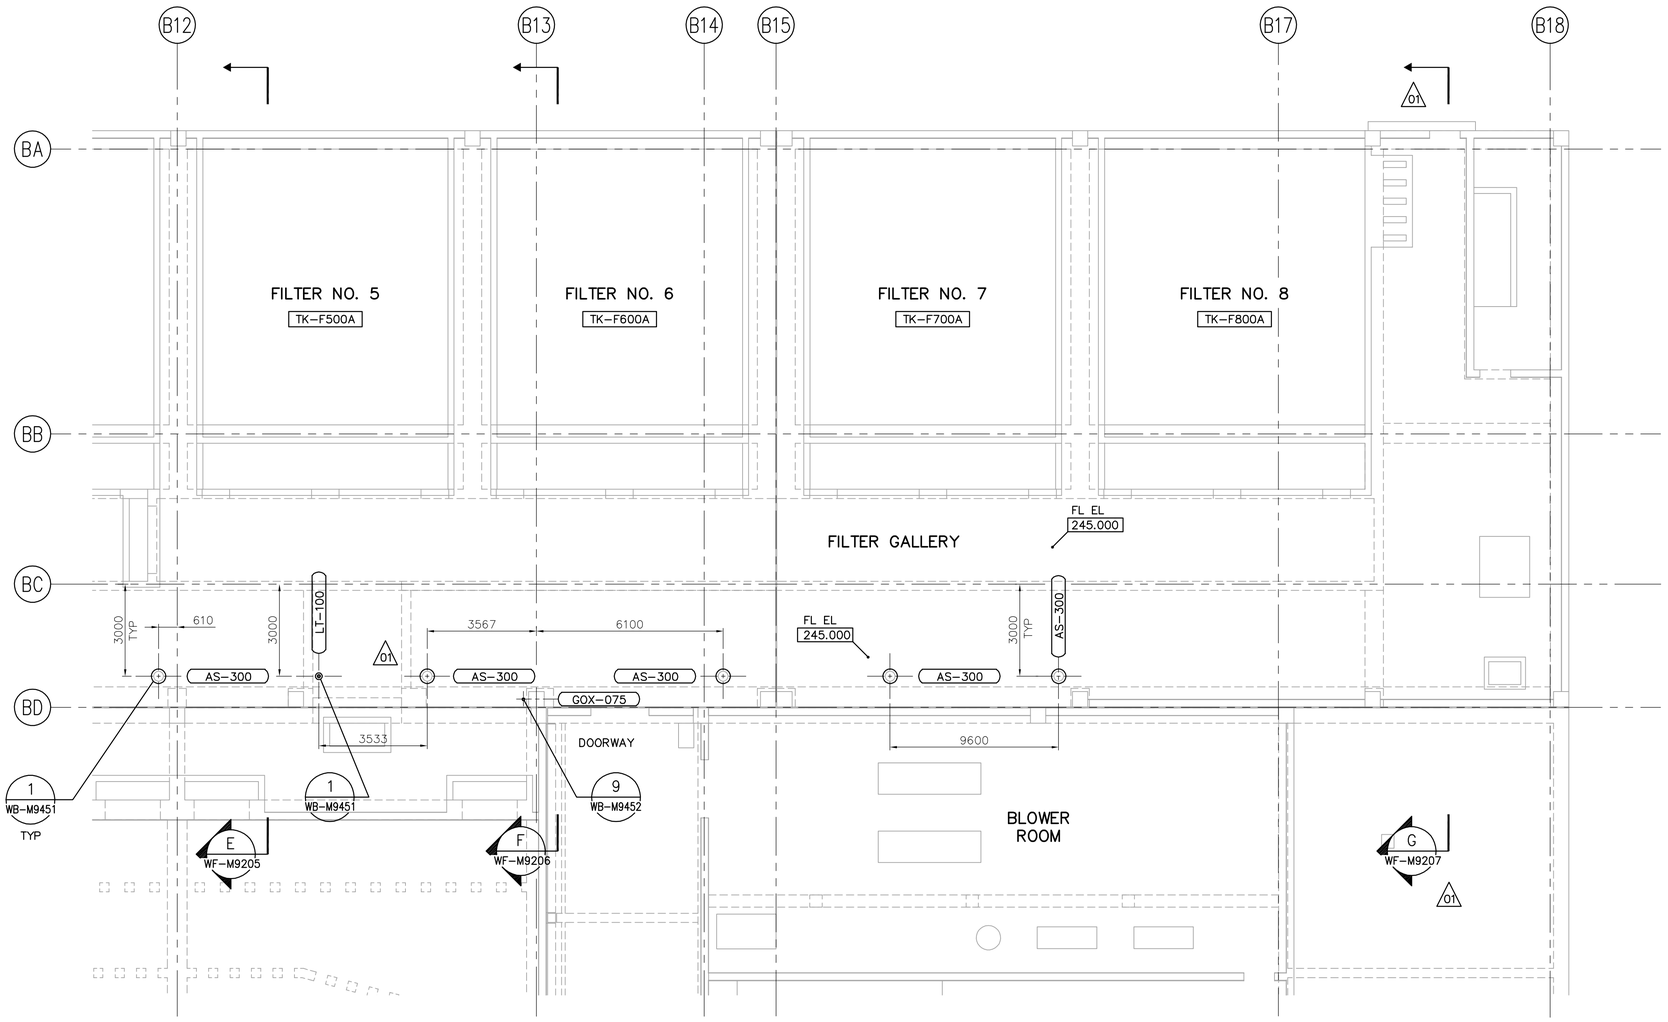

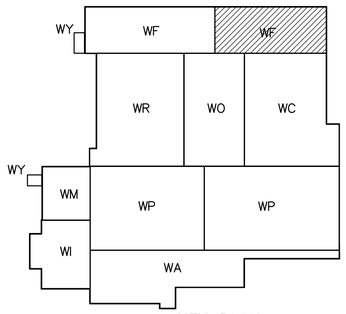

KEY PLAN

PLAN AT ELEVATION 245.000
1:100

SCALE 1:100
SCALE 1:1
METRES 0 2 4 6 8 10
MILLIMETRES 0 20 40 60 80 100

NOTES:

1. BACKGROUND HIDDEN LINES REVISED OR SHOWN FOR CLARITY.

01

APEGM
Certificate of Authorization
CH2M HILL Canada Ltd.
No. 1441 Expiry: April 30, 2007

B.M. ELEV.

NO.	REVISIONS	DATE	BY
02	742-2005 ADDENDUM 3	06/05/05	PW
01	583-2005 ADDENDUM 3	06/03/10	PW
00	ISSUED FOR TENDER	2006/02/03	PW

CH2MHILL
Fredericksen Cooper ARCHITECTS
EarthTech A Tyco International Ltd. Company

DESIGNED BY	TB/PW	CHECKED BY	LS
DRAWN BY	TAR/EK	APPROVED BY	DJT
SCALE:	1:100	RELEASED FOR CONSTRUCTION BY:	R. SOROKOWSKI
DATE	2005/07/08	DATE	2006/02/08

ENGINEER'S SEAL
ORIGINAL SIGNED BY
P. WOBMA
2006/02/06

CONSULTANT DRAWING NO.
WF-M9132

Winnipeg
THE CITY OF WINNIPEG
WATER AND WASTE DEPARTMENT
ENGINEERING DIVISION

WATER TREATMENT PLANT
FILTRATION
MECHANICAL AND ELECTRICAL

CITY FILE NUMBER
SHEET OF

PROCESS MECHANICAL
PIPE EMBEDS
FILTRATION AREA 2 THIRD FLOOR PLAN

CITY DRAWING NUMBER
1-0601F-A-M9132-001-02D

Last Save: 2006-05-04 11:28 AM

C:\DOCUMENTS AND SETTINGS\SEVERITT\MY DOCUMENTS\NDMPROJ\321352 - WINNIPEGWTP\DN_WF-M9132_CH2M.DWG