
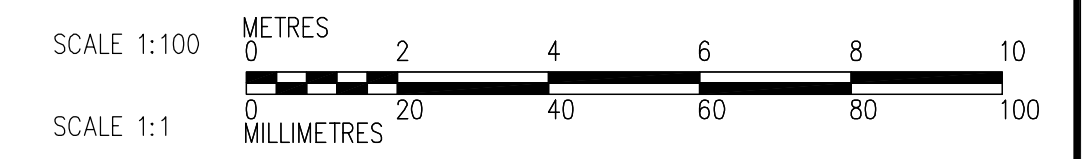


- NOTES:**
1. ALL WIRING IN THIS AREA WILL BE RUN IN CONDUIT.
  2. PROVIDE STAIRWELL SMOKE DETECTORS AS SHOWN ON FIRE PROTECTION DRAWINGS

FOR CABLE TRAY TAGGING SEE DETAIL **3**  
WB-E0455

**THIRD FLOOR FACILITY PLAN**  
1:100

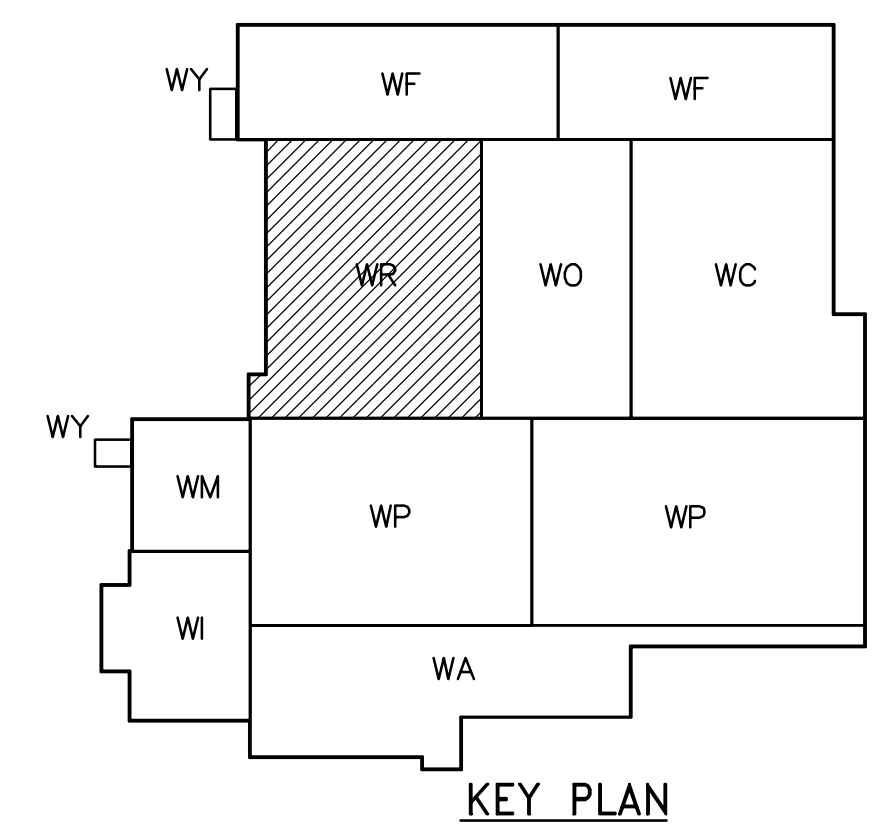

 <b>Certificate of Authorization</b> CH2M HILL Canada Ltd. No. 1441 Expiry: April 30, 2007	B.M. ELEV.	 Frederickson Cooper ARCHITECTS	 A Tyco International Ltd. Company	ENGINEER'S SEAL ORIGINAL SIGNED BY L.D. LLEWELLYN 2006/03/29	 <b>THE CITY OF WINNIPEG</b> WATER AND WASTE DEPARTMENT ENGINEERING DIVISION WATER TREATMENT PLANT RESIDUALS HANDLING MECHANICAL AND ELECTRICAL ELECTRICAL RESIDUALS HANDLING AREA THIRD FLOOR FACILITY PLAN	CITY FILE NUMBER									
	<table border="1"> <tr> <td>01</td> <td>742-2005 ADDENDUM 3</td> <td>06/05/05</td> <td>LL</td> </tr> <tr> <td>00</td> <td>ISSUED FOR TENDER</td> <td>06/03/29</td> <td>LL</td> </tr> <tr> <td>NO.</td> <td>REVISIONS</td> <td>DATE</td> <td>BY</td> </tr> </table>	01	742-2005 ADDENDUM 3	06/05/05		LL	00	ISSUED FOR TENDER	06/03/29	LL	NO.	REVISIONS	DATE	BY	DESIGNED BY LL CHECKED BY ND DRAWN BY TL APPROVED BY AHL SCALE: 1:100 RELEASED FOR CONSTRUCTION BY: R. SOROKOWSKI DATE 2005/07/12 DATE 2006/03/29
01	742-2005 ADDENDUM 3	06/05/05	LL												
00	ISSUED FOR TENDER	06/03/29	LL												
NO.	REVISIONS	DATE	BY												