

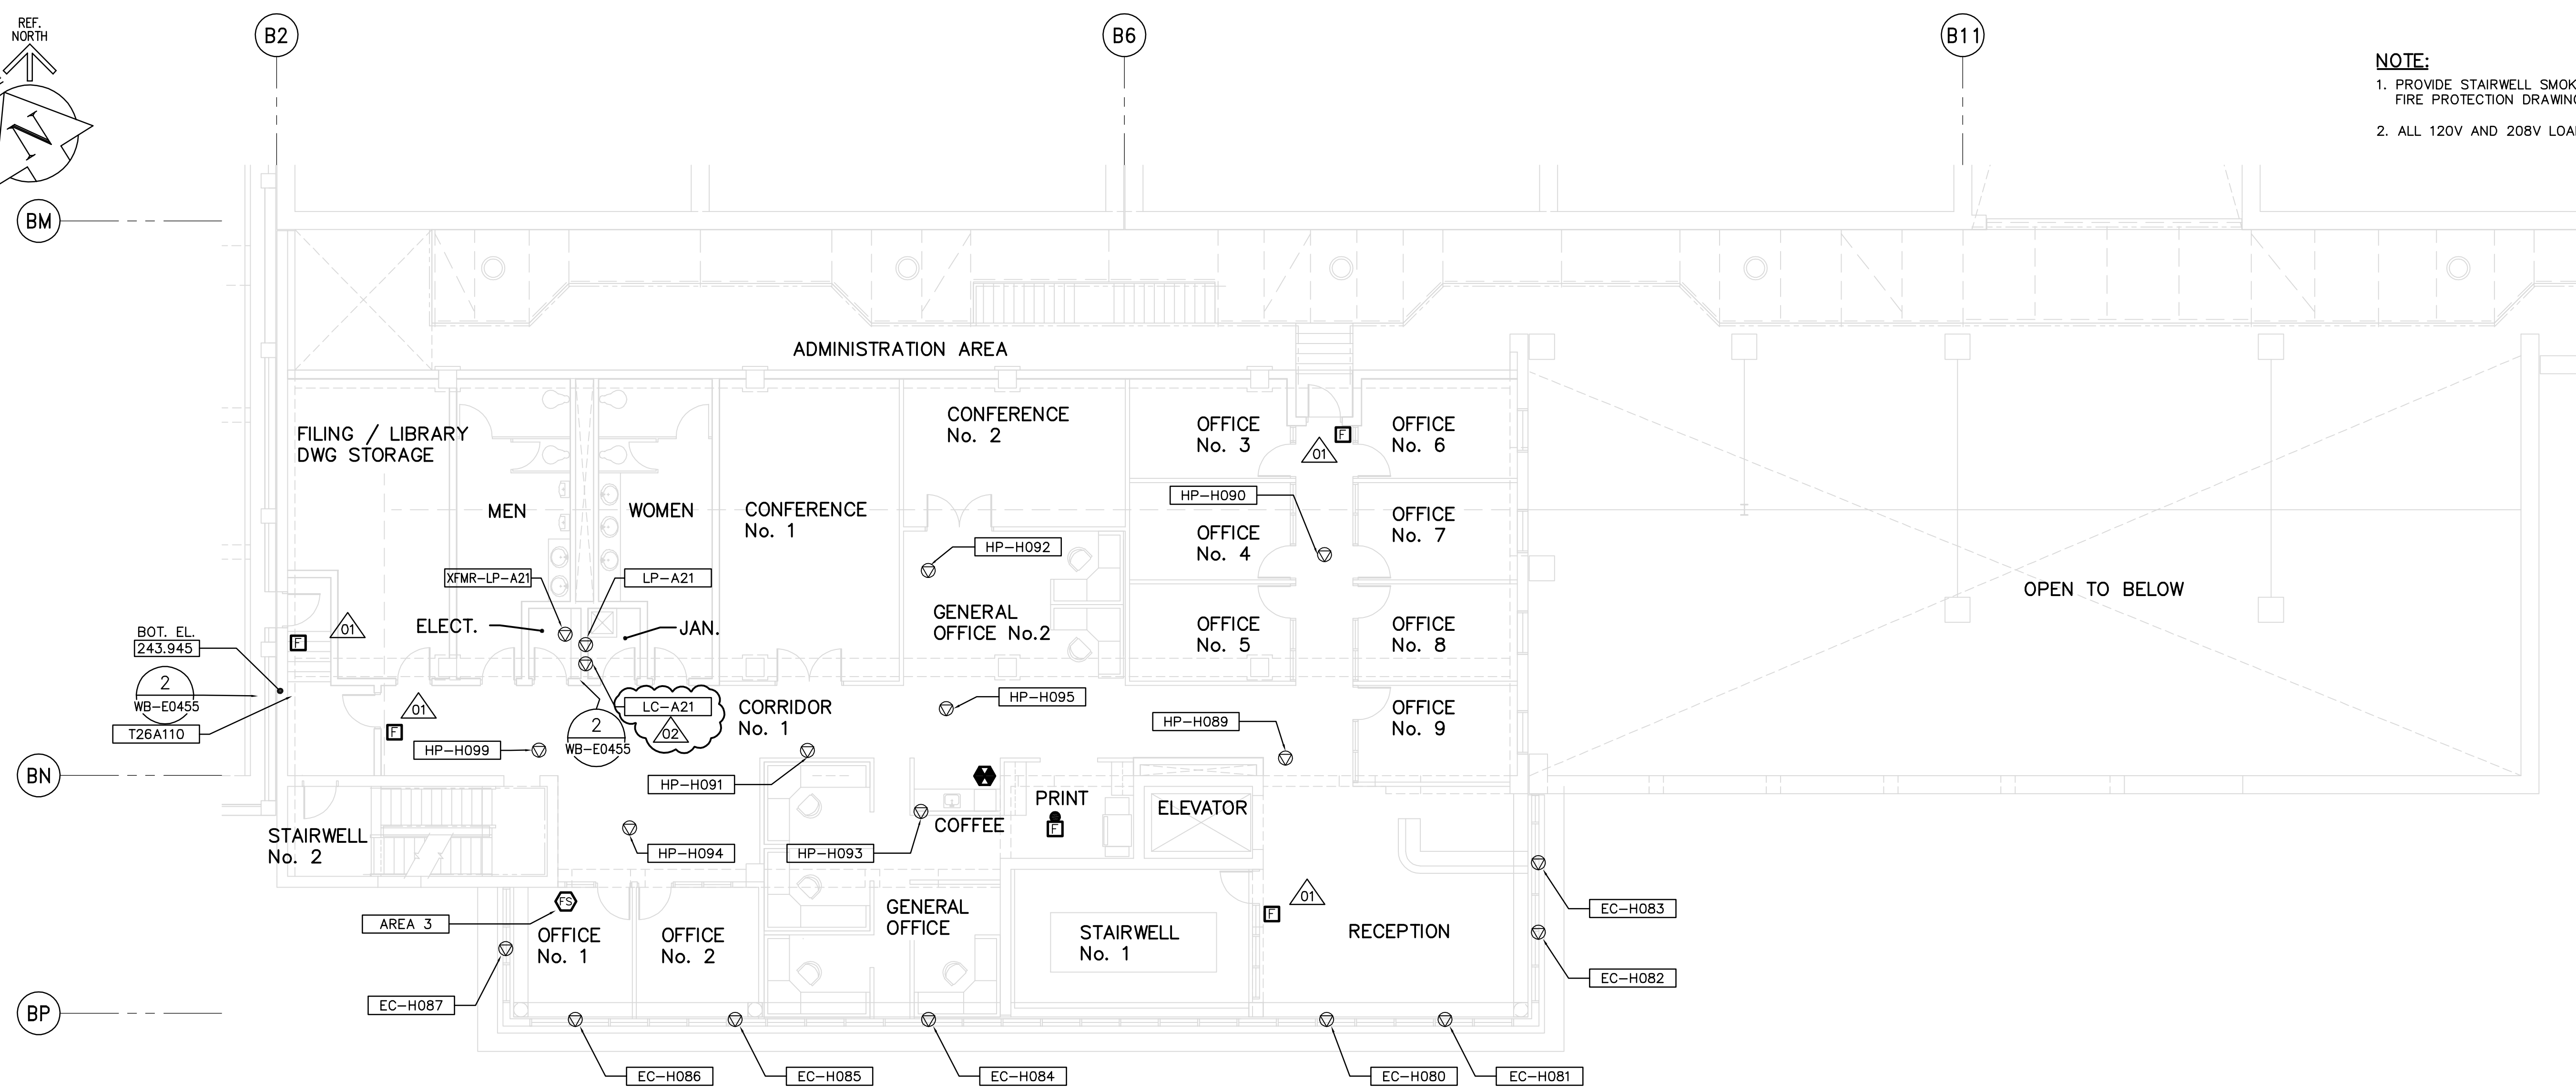


**NOTE:**  
 1. PROVIDE STAIRWELL SMOKE DETECTORS AS SHOWN ON FIRE PROTECTION DRAWINGS.  
 2. ALL 120V AND 208V LOADS ARE FED FROM LP-A11

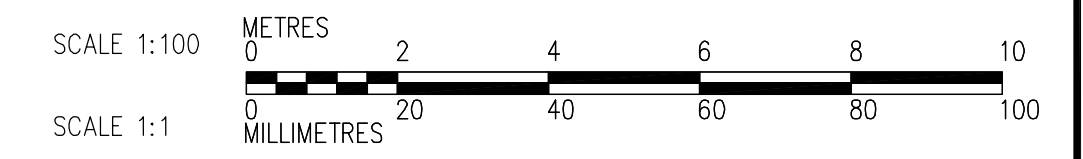

**SECOND FLOOR FACILITY PLAN**  
 1:100

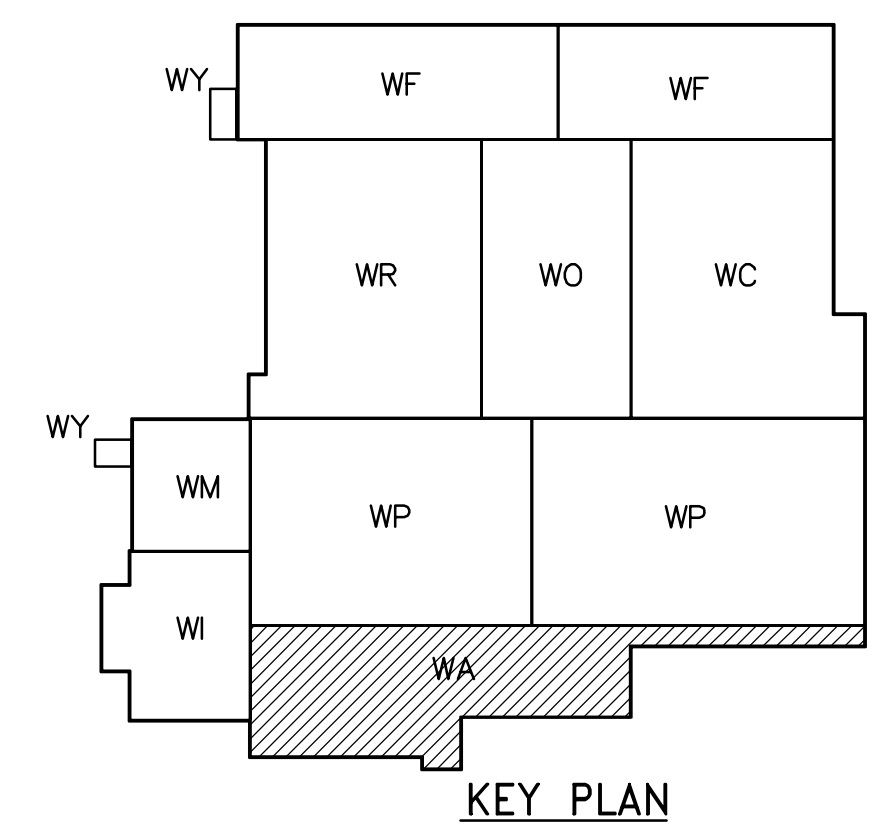

 Certificate of Authorization CH2M HILL Canada Ltd. No. 1441 Expiry: April 30, 2007	B.M. ELEV.	 Frederickson Cooper ARCHITECTS	 A Terra International Ltd. Company	ENGINEER'S SEAL	 <b>THE CITY OF WINNIPEG</b> WATER AND WASTE DEPARTMENT ENGINEERING DIVISION	
	DESIGNED BY: LL			CHECKED BY: ND		ORIGINAL SIGNED BY: L.D. LLEWELLYN
	DRAWN BY: TL			APPROVED BY: AHL		2006/03/29
	SCALE: 1:100			RELEASED FOR CONSTRUCTION BY: R. SOROKOWSKI		CONSULTANT DRAWING NO. WA-E0121
NO. REVISIONS    DATE    BY	DATE    2005/08/18    DATE    2006/03/29	WATER TREATMENT PLANT ADMINISTRATION MECHANICAL AND ELECTRICAL		CITY FILE NUMBER SHEET OF		
		ELECTRICAL ADMINISTRATION AREA SECOND FLOOR FACILITY PLAN		CITY DRAWING NUMBER 1-0601A-A-E0121-001-02D		