


1 ELECTRICAL ROOM HEATING, COOLING AND VENTILATION UNIT T610-AHU
LM4.08 SCALE NTS

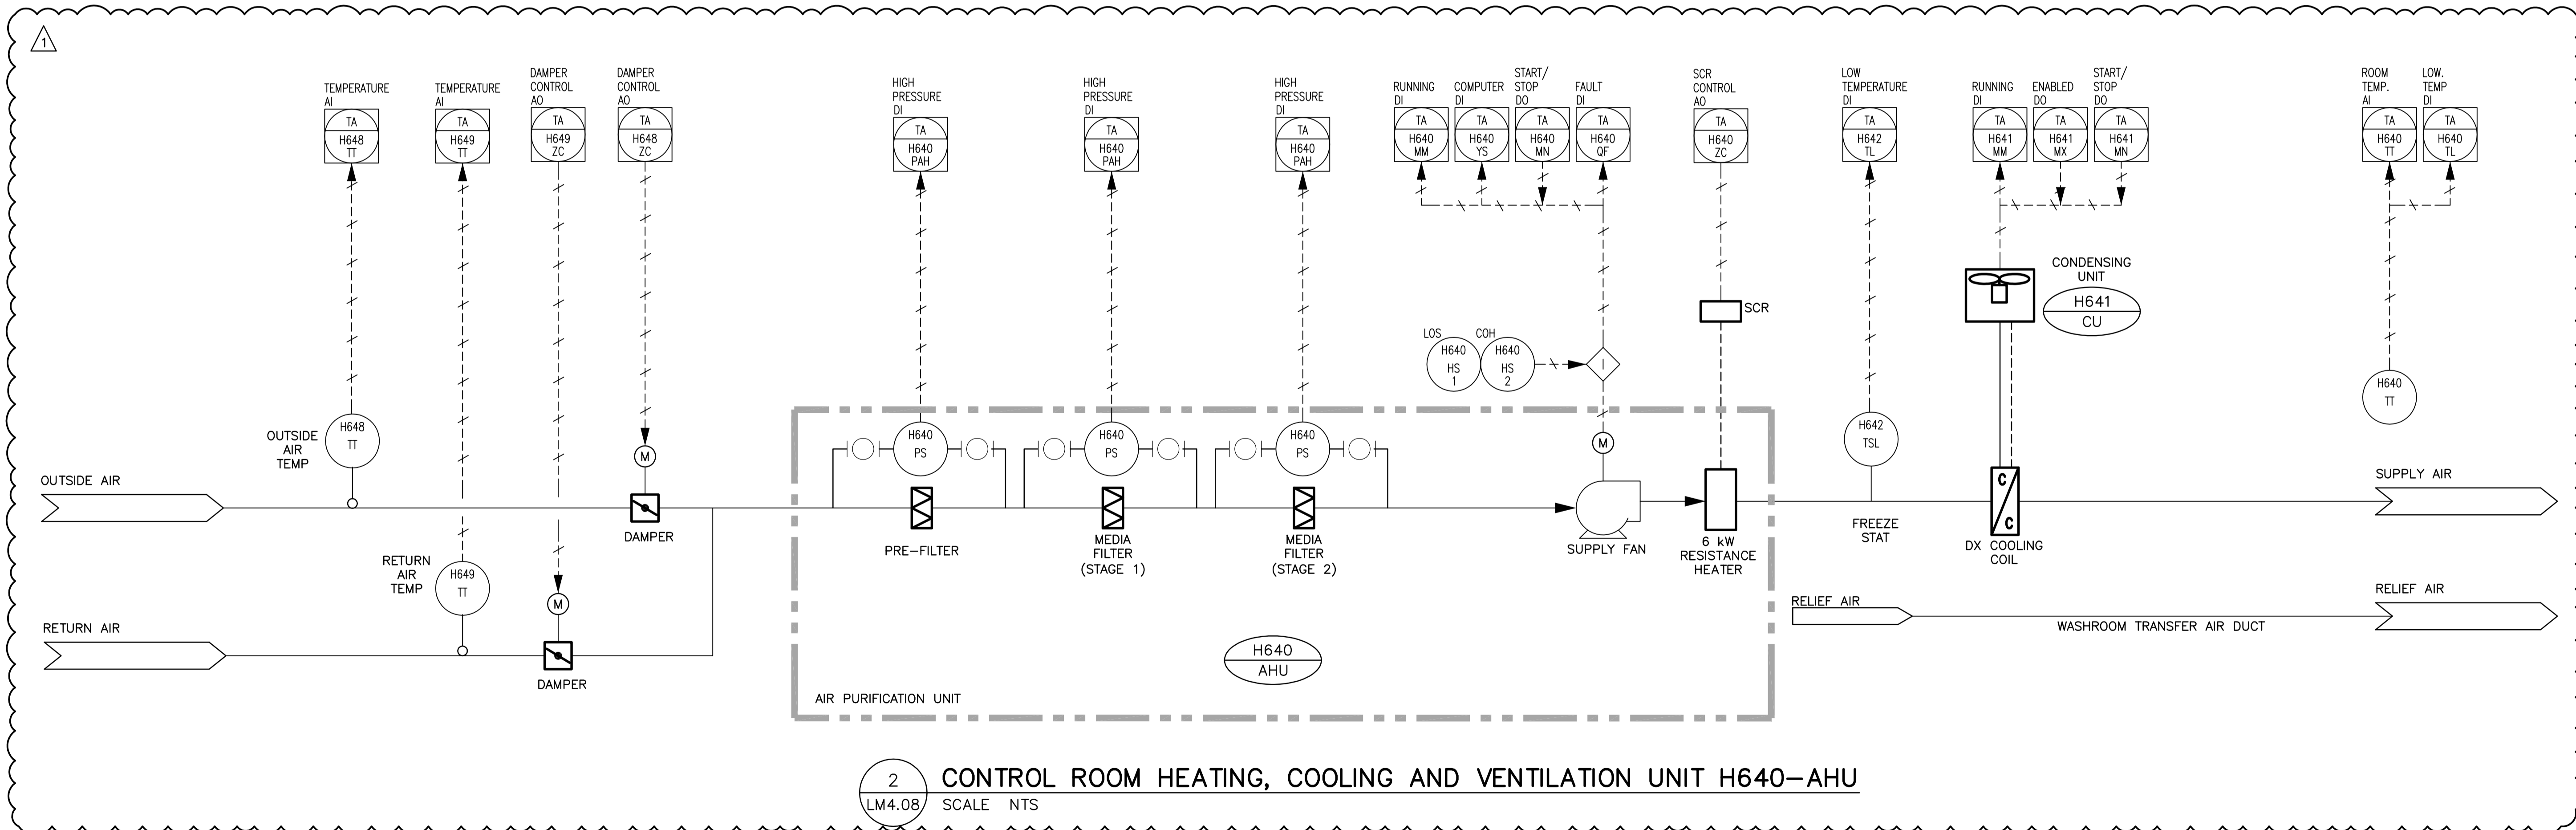

2 CONTROL ROOM HEATING, COOLING AND VENTILATION UNIT H640-AHU
LM4.08 SCALE NTS

GENERAL NOTES

- REFER TO PLANS FOR PIPE AND DUCT SIZES.
- REFER TO SPEC. SECTIONS 15900 FOR ADDITIONAL REQUIREMENTS.



B.M. ELEV.		 A Tyco International Ltd. Company	
DESIGNED BY	AB/LJW		
DRAWN BY	LJW	APPROVED BY	JEH
HOR. SCALE: NTS		RELEASED FOR CONSTRUCTION BY: J. VEILLEUX	
VERTICAL SCALE:		DATE: 2006/01/04	
NO. REVISIONS	DATE	BY	DATE
01	21-2006 ADDENDUM 1	06/05/10	DC
00	ISSUED FOR TENDER	06/04/26	LJW

ENGINEER'S SEAL	 THE CITY OF WINNIPEG WATER AND WASTE DEPARTMENT ENGINEERING DIVISION	
ORIGINAL SIGNED BY	WEWPC BIOLOGICAL NUTRIENT REMOVAL UPGRADE CONTRACT 3	
A. BURACHYNSKY	CITY FILE NUMBER	
2006/04/26	SHEET OF	
CONSULTANT DRAWING NO. LM4.08	CITY DRAWING NUMBER	
MECHANICAL AREA L - GENERAL AND SITWORKS HEATING, COOLING & VENTILATION SCHEMATICS		