




1 SECTION
SP1.04 1:25

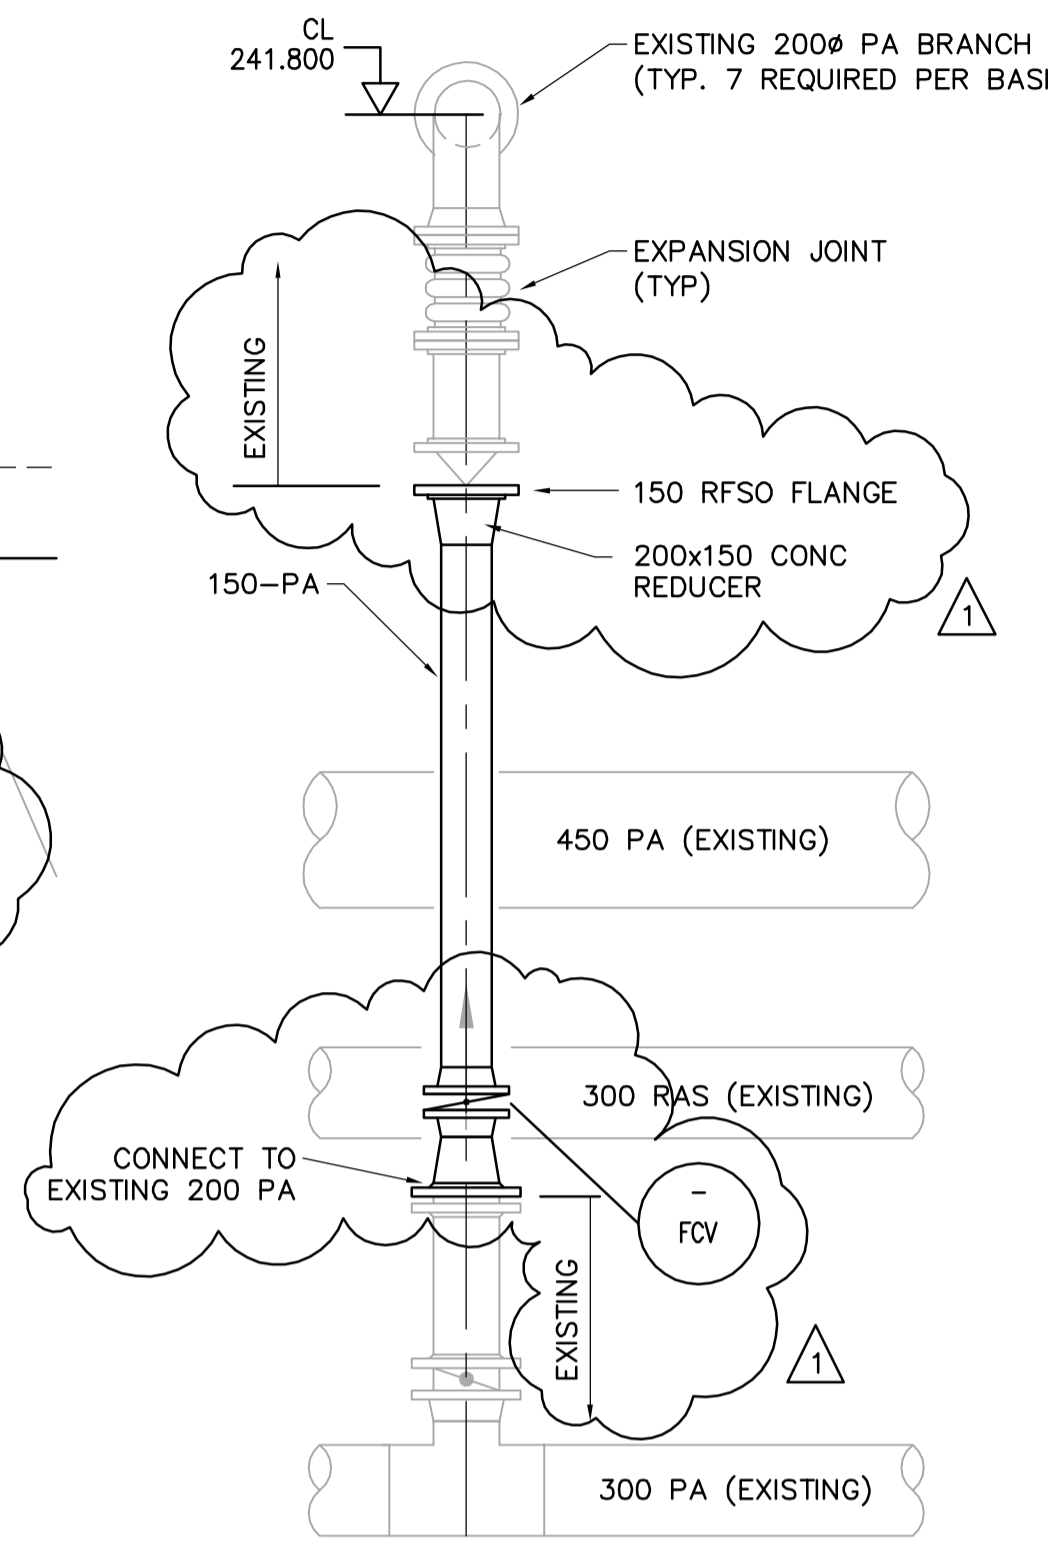

3 AERATION HEADER CONNECTION (TYP)
1:25
TYPICAL SECTION OF AERATION SUPPLY
14 AERATION SUPPLY PIPES IN TOTAL

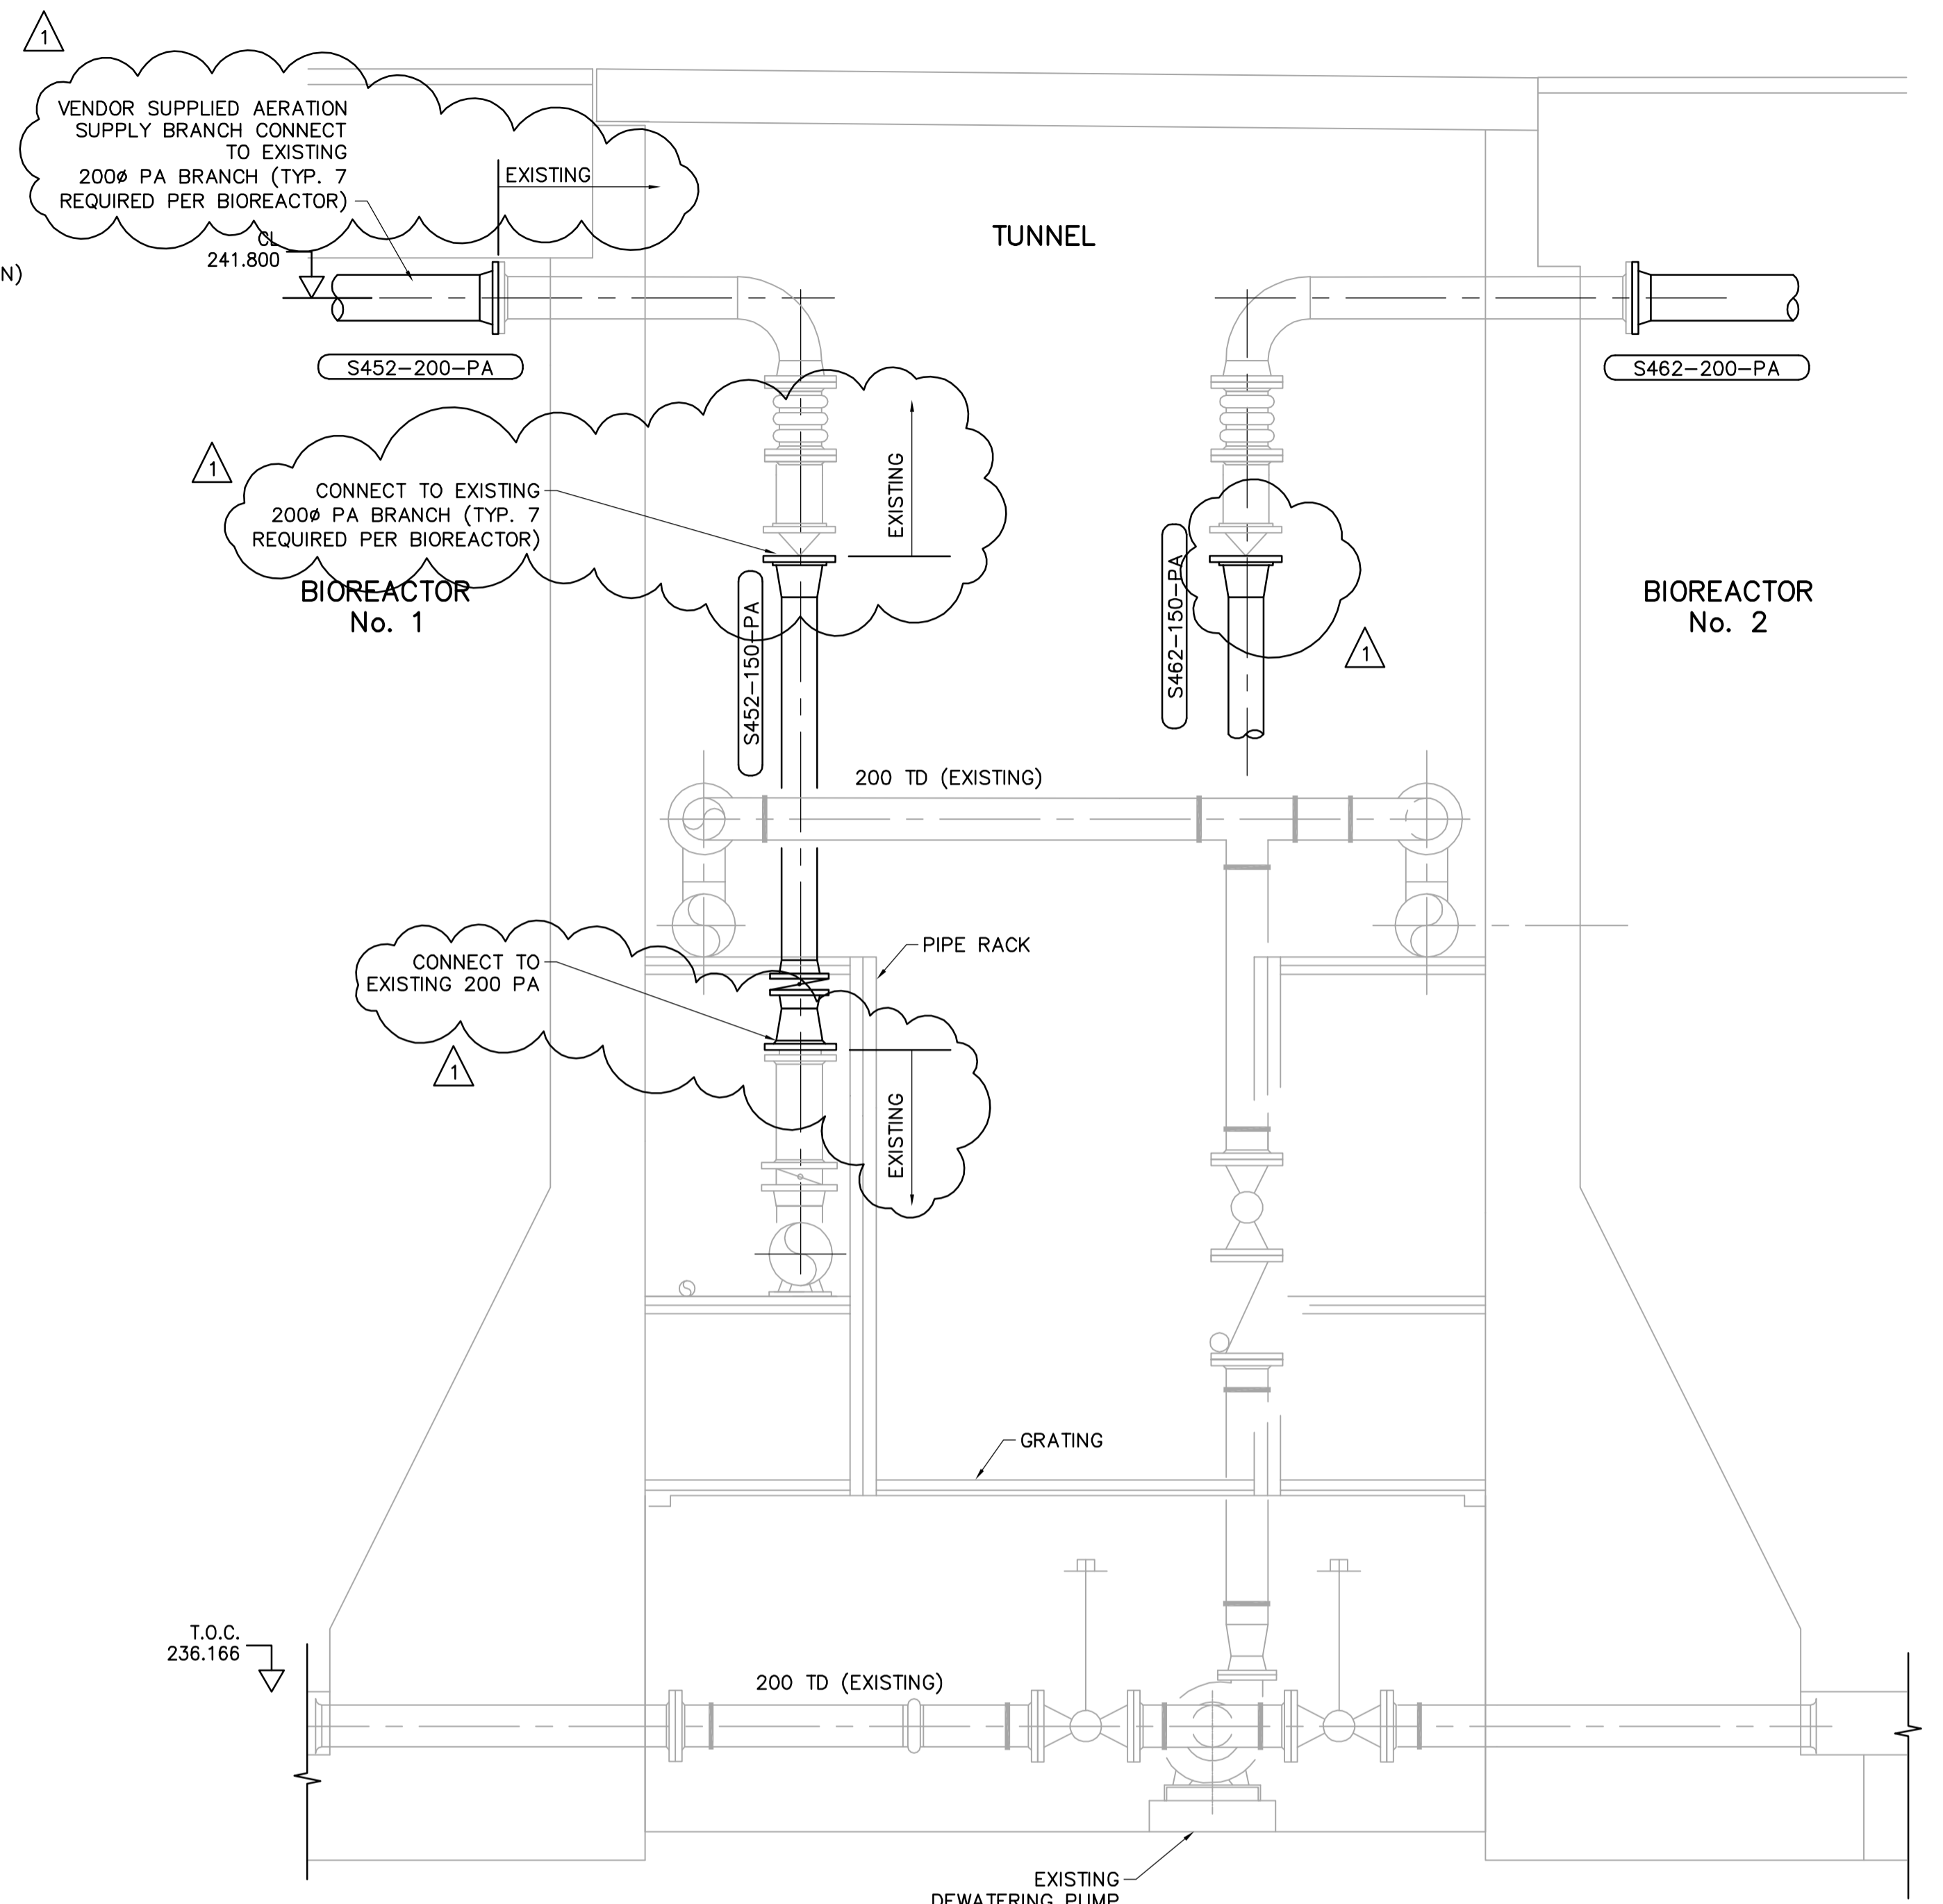

4 SECTION
SP1.02 1:25

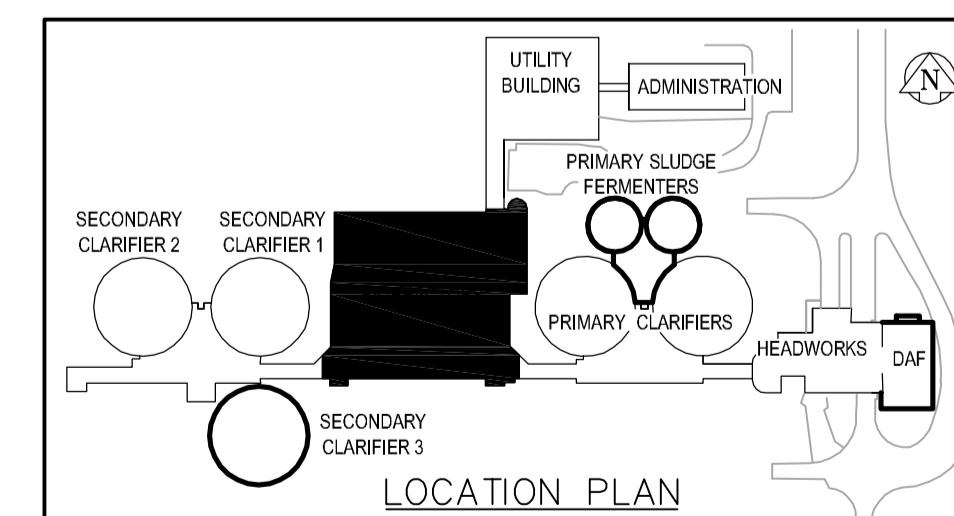

GENERAL NOTES

1. CONTRACTOR TO CONFIRM EXISTING PIPE AND EQUIPMENT DIMENSIONS AND LOCATIONS PRIOR TO CONSTRUCTION.

APEGM
Certificate of Authorization
Earth Tech Canada Inc.
No. 730 Expiry: April 30, 2006

B.M. ELEV.			
DESIGNED BY	CL	CHECKED BY	KM
DRAWN BY	RI	APPROVED BY	JEH
HOR. SCALE:	AS NOTED	RELEASED FOR CONSTRUCTION BY:	J. VEILLEUX
VERTICAL SCALE:		DATE	2005/10/06
NO. REVISIONS	DATE	BY	DATE
01	21-2006 ADDENDUM 3	06/05/19	PAL
00	ISSUED FOR TENDER	06/04/26	SRP

EarthTech
A Tyco International Ltd. Company

ENGINEER'S SEAL

ORIGINAL SIGNED BY
P.R. BARSALOU
2006/04/26

CONSULTANT DRAWING NO.
SP1.07

THE CITY OF WINNIPEG
WATER AND WASTE DEPARTMENT
ENGINEERING DIVISION

WEWPCC
BIOLOGICAL NUTRIENT REMOVAL UPGRADE
CONTRACT 3

PROCESS
AREA S - BIOREACTORS
CONNECTION DETAILS

CITY FILE NUMBER
SHEET OF
CITY DRAWING NUMBER