




1 BUILDING SECTION
 TA1.01 1:100

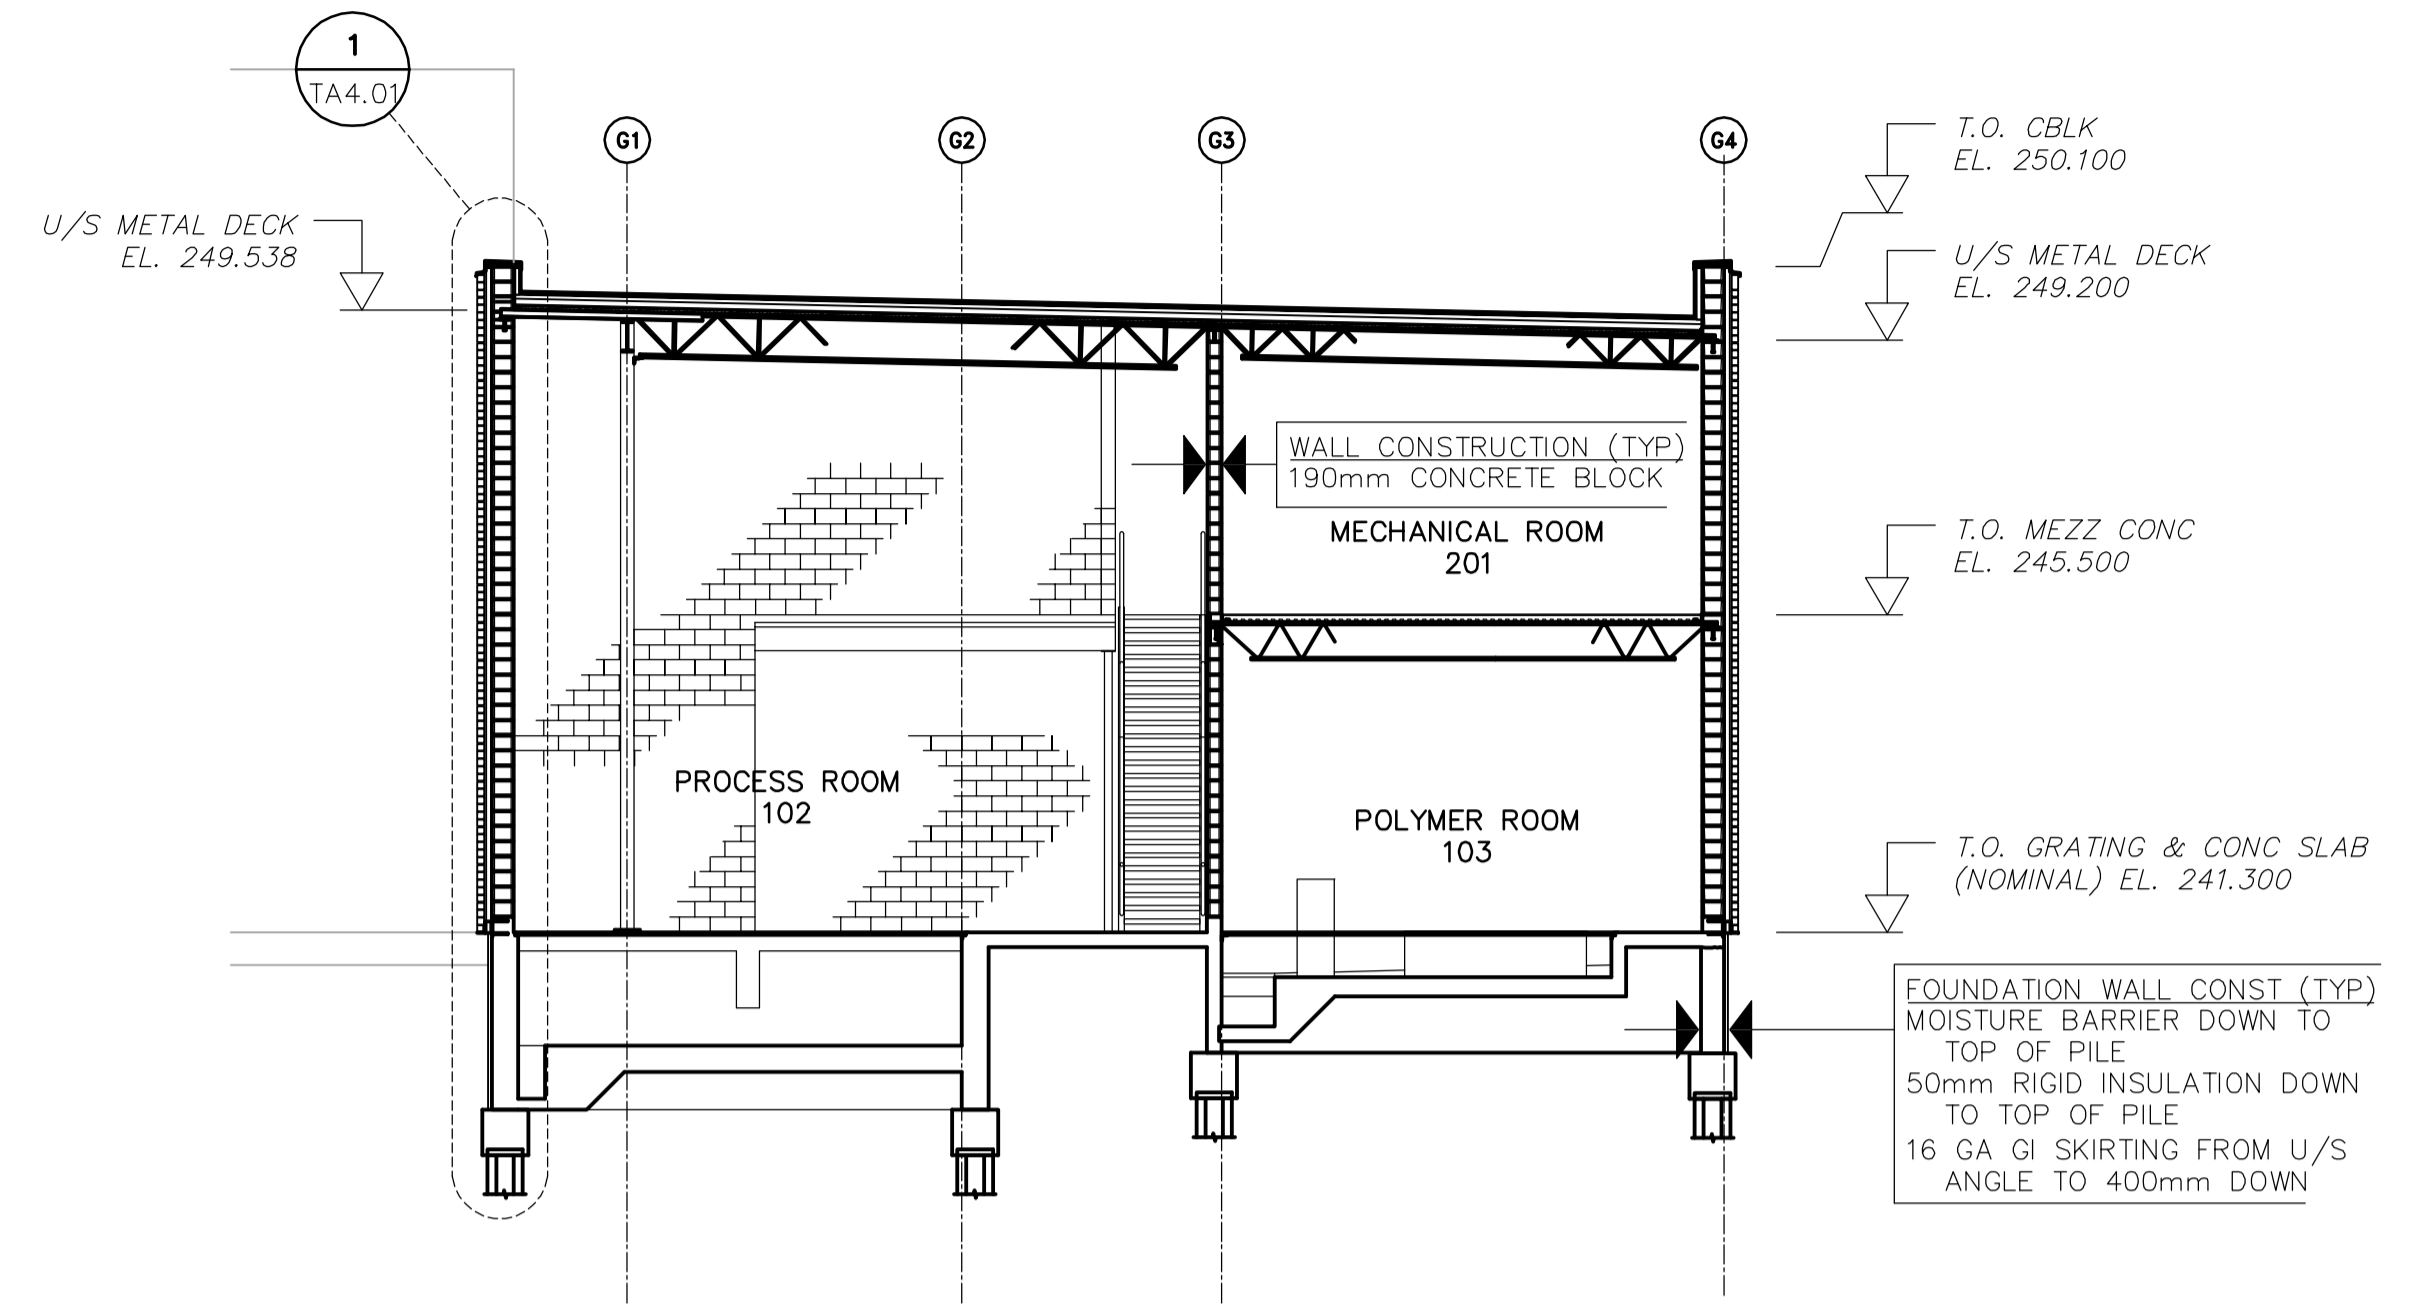


2 BUILDING SECTION
 TA1.01 1:100

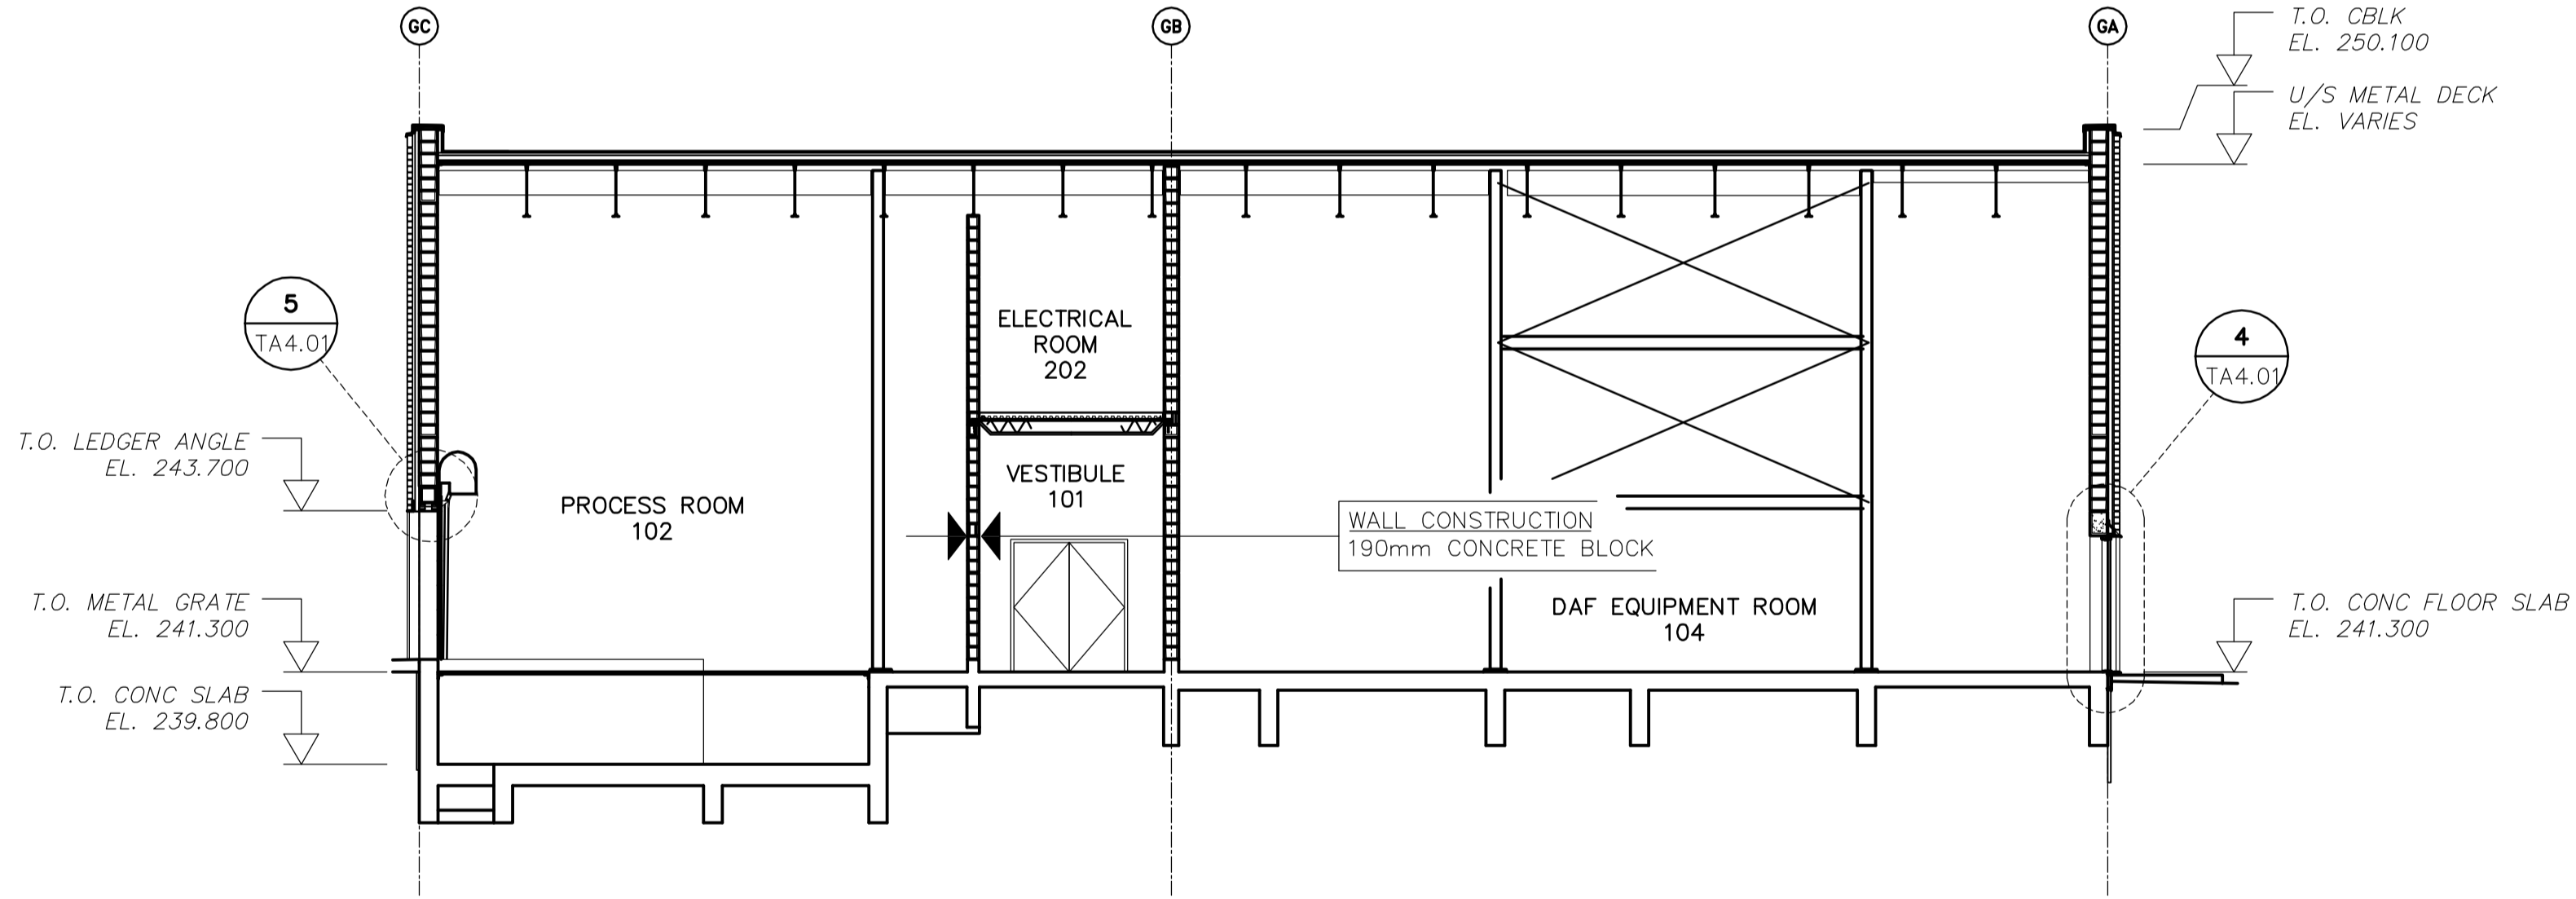

3 BUILDING SECTION
 TA1.01 1:100

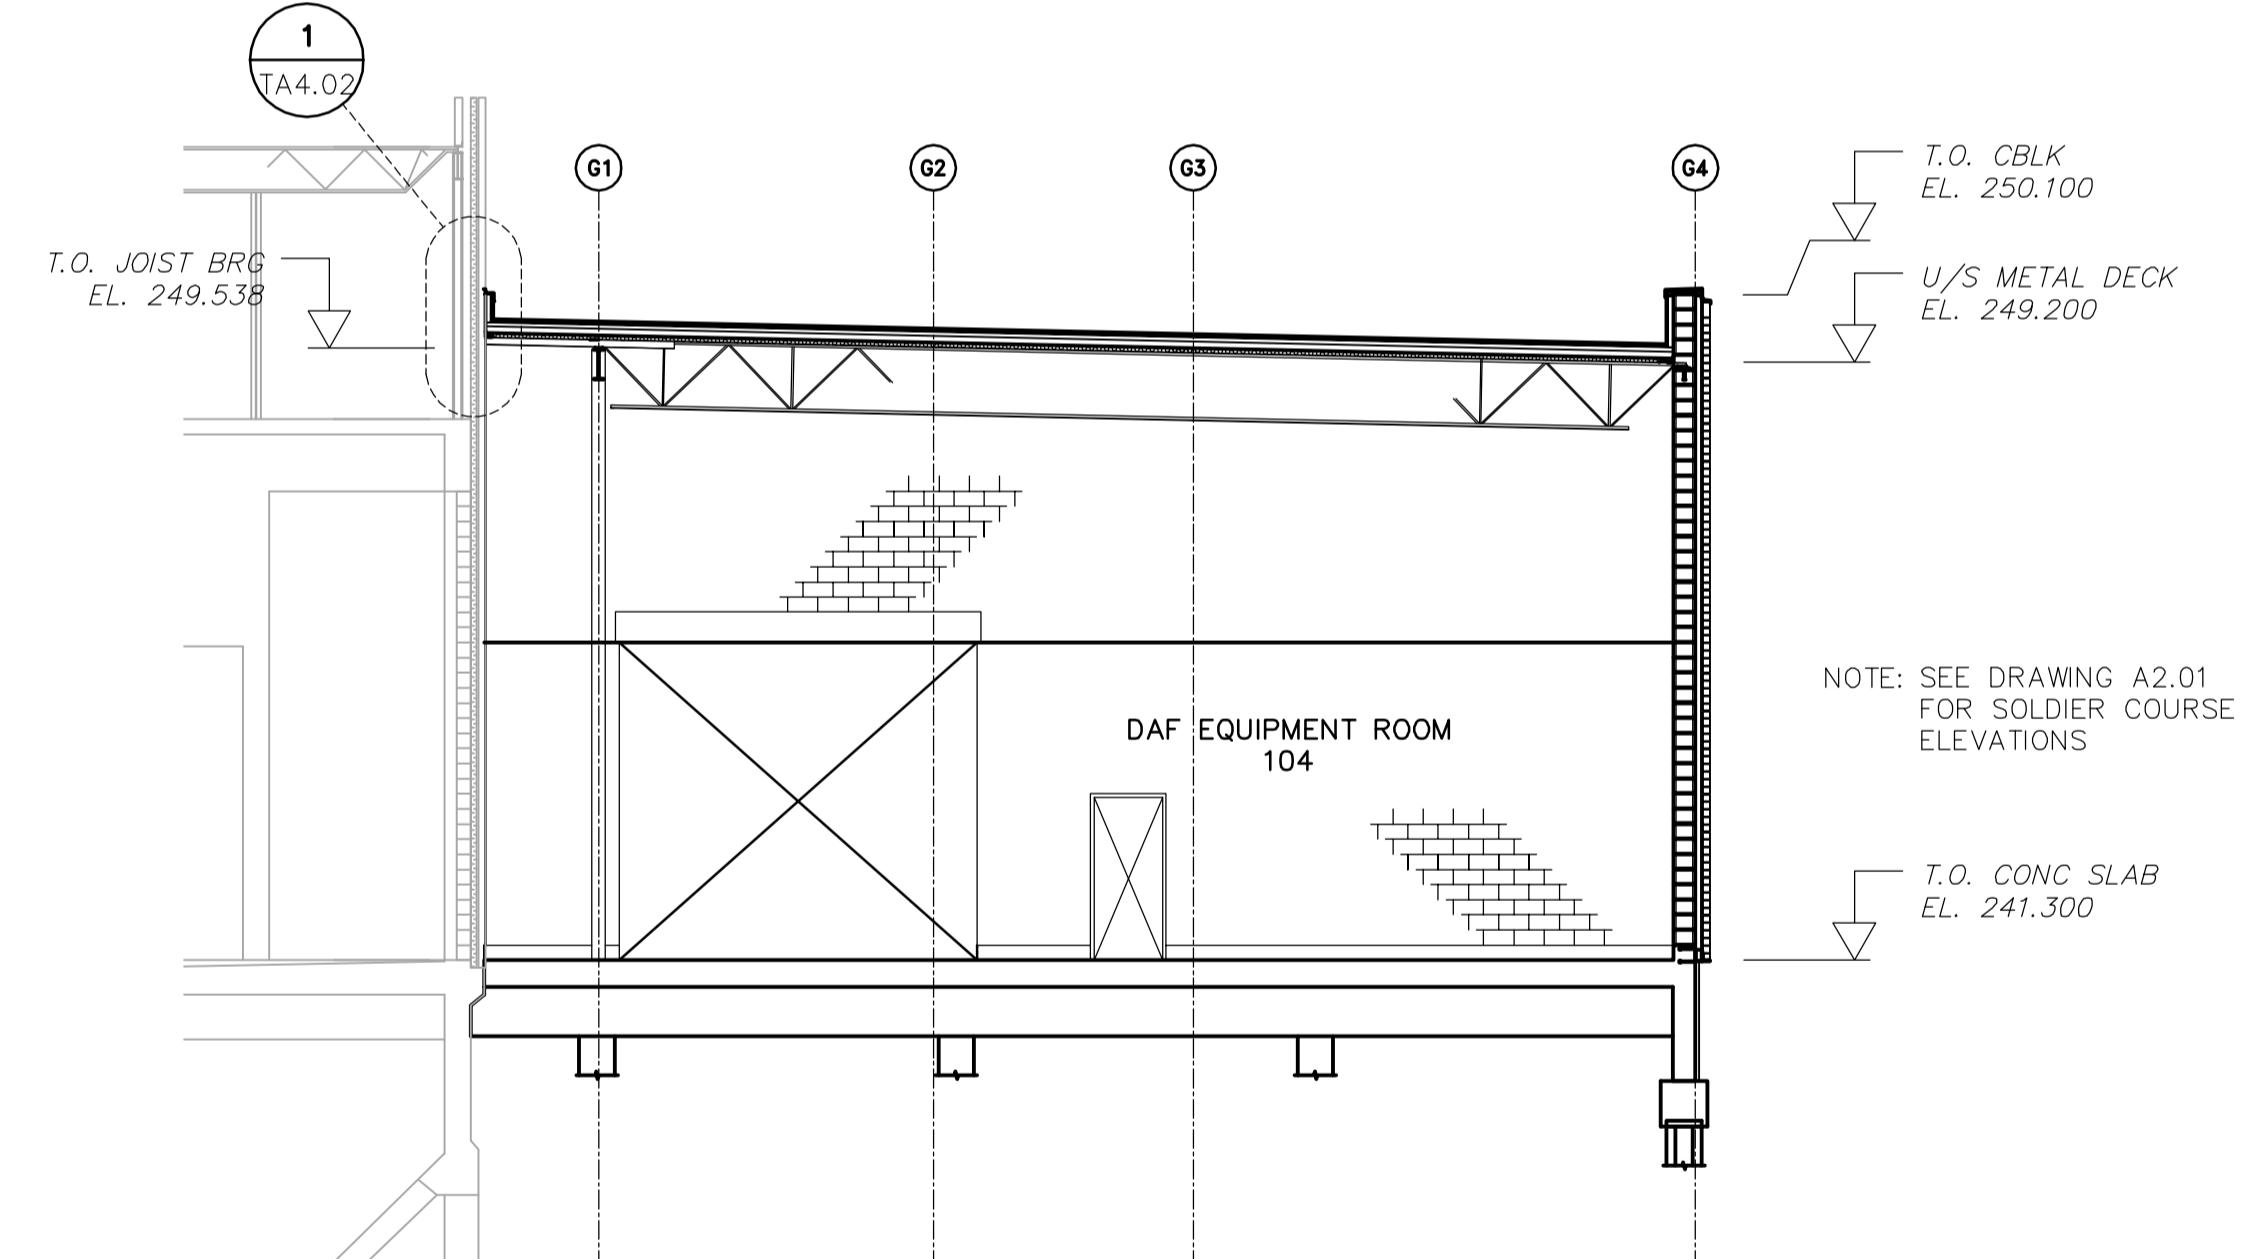

4 BUILDING SECTION
 TA1.01 1:100

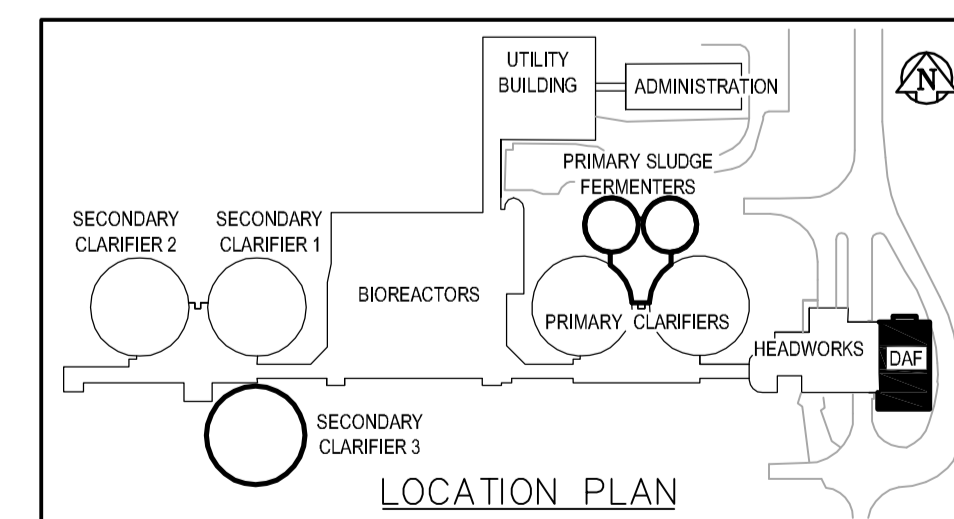

B.M. ELEV.				EarthTech A Tyco International Ltd. Company		ENGINEER'S SEAL	
DESIGNED BY	NC	CHECKED BY	NC	ORIGINAL SIGNED BY		N. COOPER	
DRAWN BY	LK	APPROVED BY	JEH	2006/04/26		CONSULTANT DRAWING NO. TA3.01	
01	21-2006 ADDENDUM 3	06/05/25	LK	HOR. SCALE: AS NOTED		RELEASED FOR CONSTRUCTION BY: J. VEILLEUX	
00	ISSUED FOR TENDER	06/04/26	LK	VERTICAL SCALE: AS NOTED		DATE 2006/01/09 DATE 2006/04/26	
NO.	REVISIONS	DATE	BY	DATE	DATE		

THE CITY OF WINNIPEG
 WATER AND WASTE DEPARTMENT
 ENGINEERING DIVISION

WEWPC
 BIOLOGICAL NUTRIENT REMOVAL UPGRADE
 CONTRACT No. 3

ARCHITECTURAL
 AREA T - DAF THICKENER BUILDING
 BUILDING SECTIONS

CITY FILE NUMBER
 SHEET 4 OF 6
 CITY DRAWING NUMBER