


1 BUILDING SECTION
TS2.03 SCALE 1:75

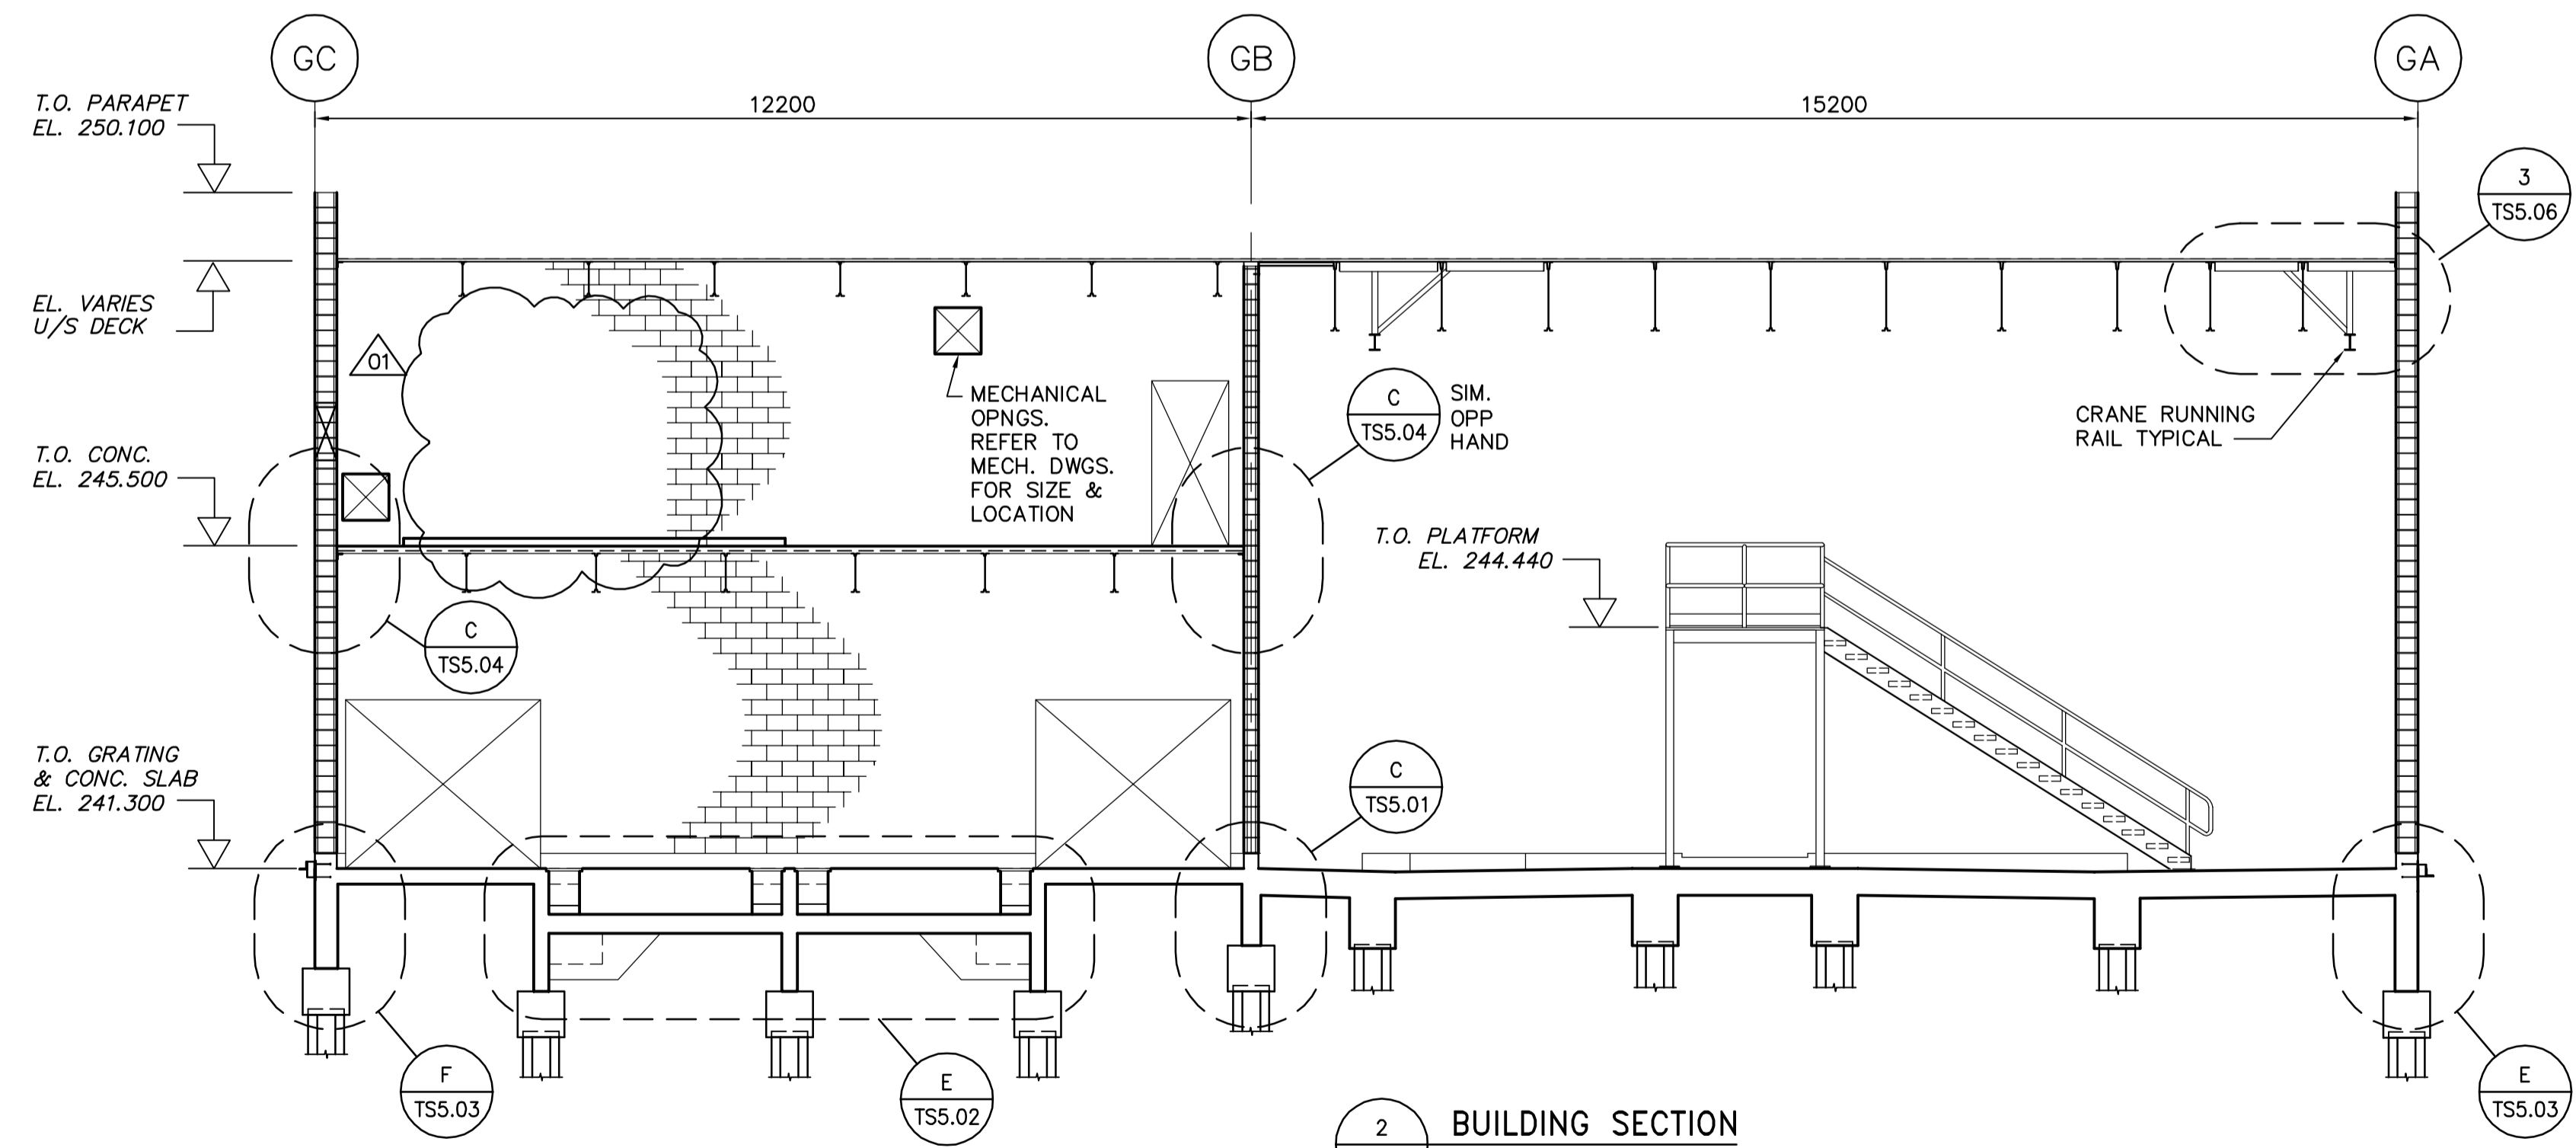

2 BUILDING SECTION
TS2.03 SCALE 1:75

APECA
Certificate of Authorization
Earth Tech Canada Inc.
No. 730 Expiry: April 30, 2006

B.M. ELEV.	DESIGNED BY	CHECKED BY	DRAWN BY	HOR. SCALE:	VERTICAL SCALE:	NO.	REVISIONS	DATE	BY	DATE
	ARA	LR	NDH	AS NOTED		01	21-2006-ADDENDUM 3	06/05/19	NS	
						00	ISSUED FOR TENDER	06/04/26	CMF	
								2002/03/13		2006/04/26

EarthTech
A Tyco International Ltd. Company

DESIGNED BY: ARA
CHECKED BY: LR
DRAWN BY: NDH
APPROVED BY: JEH

HOR. SCALE: AS NOTED
VERTICAL SCALE: AS NOTED

RELEASED FOR CONSTRUCTION BY:
J. VEILLEUX

DATE: 2002/03/13
DATE: 2006/04/26

ENGINEER'S SEAL
ORIGINAL SIGNED BY
L.L. RIDING
2006/04/26

THE CITY OF WINNIPEG
WATER AND WASTE DEPARTMENT
ENGINEERING DIVISION

WEWPC
BIOLOGICAL NUTRIENT REMOVAL UPGRADE
CONTRACT 3

STRUCTURAL
AREA T - DAF THICKENER BUILDING
BUILDING SECTIONS

CITY FILE NUMBER
SHEET OF
CITY DRAWING NUMBER

CONSULTANT DRAWING NO.
TS4.01