SHEET: COW-A1 (03/2005)

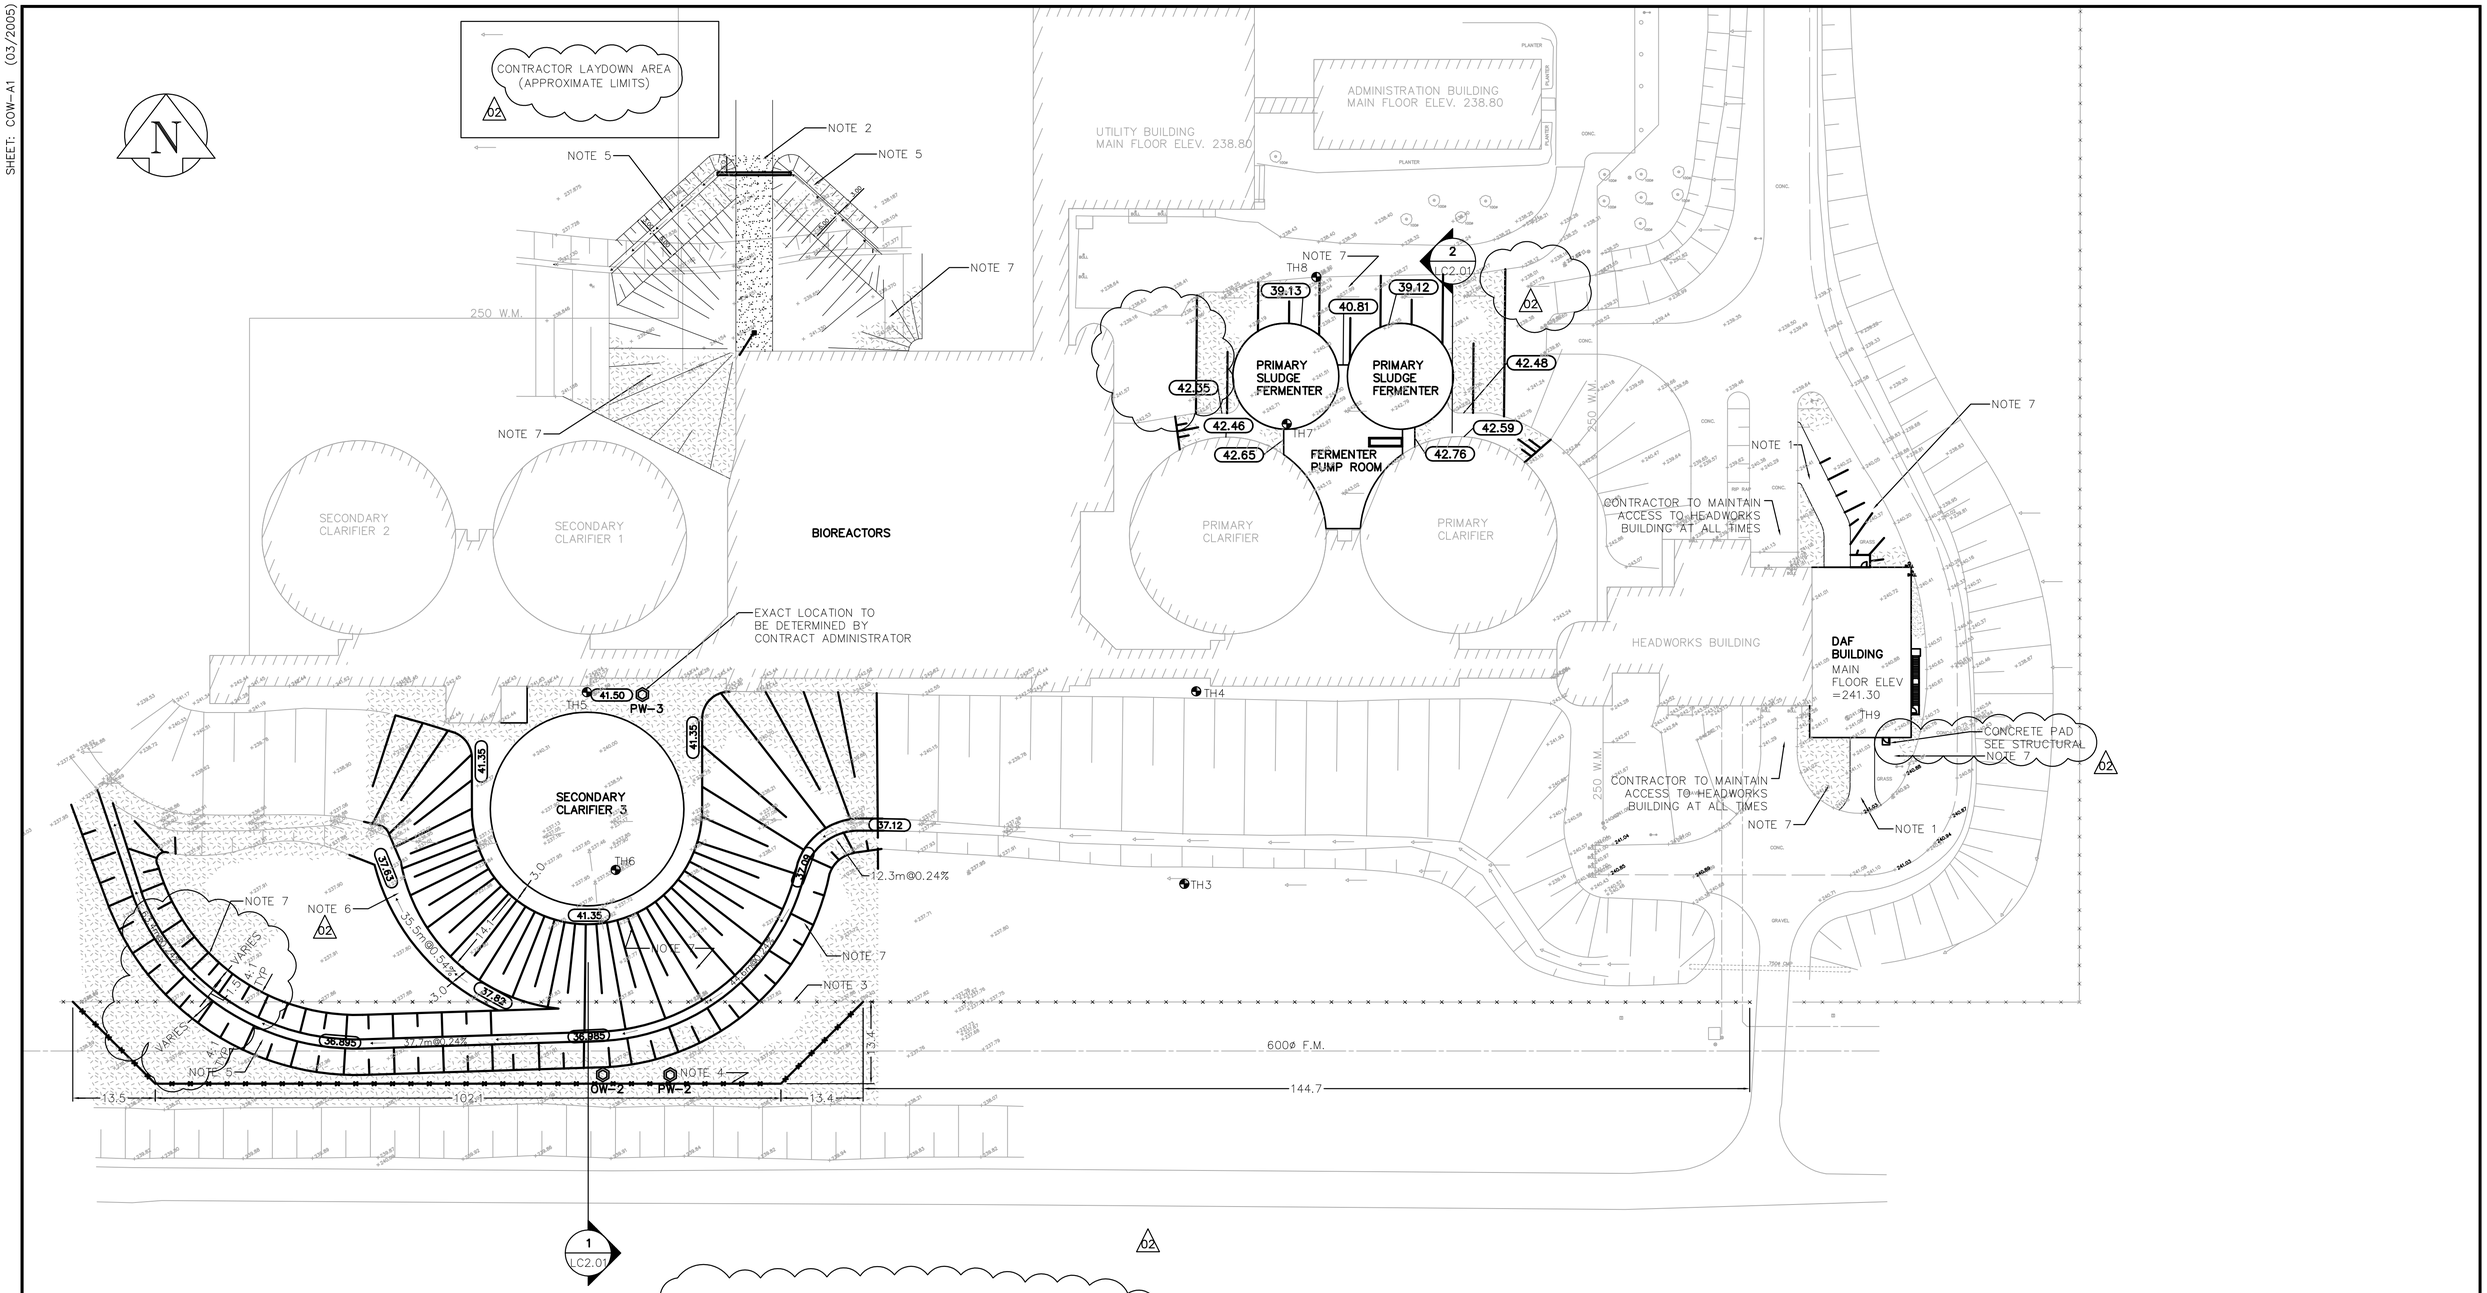

GENERAL NOTE

1. PLACE IMPORTED TOPSOIL AND SOD ON NEW SLOPES AND DITCHES CONTRACTOR TO RESTORE ALL LAYDOWN AREAS, DAMAGED AREAS AND STOCKPILE AREAS TO EQUAL OR BETTER THAN ORIGINAL CONDITION

NOTES

1. CONSTRUCT NEW 200mm REINFORCED CONCRETE APPROACH. SEE DETAIL 5 AND 7 ON DWG. LC2.01
2. CONSTRUCT NEW GRAVEL APPROACH c/w 450 DIA. CMP. SEE DETAIL 3 ON DWG. LC2.01
3. REMOVE EXISTING CHAIN LINK FENCE WITHIN LIMITS OF NEW FENCE CONSTRUCTION
4. INSTALL NEW CHAIN LINK AND CONNECT TO EXISTING FENCE PRIOR TO REMOVAL OF EXISTING FENCE
5. CONSTRUCT NEW DRAINAGE DITCH
6. CONSTRUCT NEW DRAINAGE SWALE

APEGM
Certificate of Authorization
Earth Tech Canada Inc.
No. 730 Expiry: April 30, 2006

EXISTING	LEGEND – PLAN	PROPOSED	EXISTING	LEGEND – PLAN	PROPOSED	EXISTING	LEGEND – PLAN	PROPOSED
150 mm W.M.	WATERMAIN	150 mm W.M.		HYDRO			LIGHT STANDARD	
	HYDRANT			M.T.S.			ANCHOR	
	VALVE			CONCRETE		H	POLE	
300mm L.D.S.	LAND DRAINAGE SEWER	300mm L.D.S.		ASPHALT		391.0	CONTOURS	
250mm W.W.S.	WASTEWATER SEWER	250mm W.W.S.		PROPERTY LINE			RAIL X-ING SIGNAL	
	MANHOLE			SURVEY BAR			℄ RAILWAY TRACK	
	CATCH BASIN		232.750	ELEVATION	32.750		DITCH	
	CURB INLET		500ø	TREE			GRAVEL SURFACE	
	JUNCTIONS			ANODE			TEST HOLE	
	CULVERT			CONCRETE SIDEWALK			PUMPING WELL	
	GAS			FENCE			MTS PEDESTAL	

B.M.
ELEV.

NO.	REVISIONS	DATE	BY
02	21-2006 ADDENDUM 6	06/07/05	KWR
01	21-2006 ADDENDUM 3	06/05/26	SRP
00	ISSUED FOR TENDER	06/04/26	KWR

EarthTech
A Tyco International Ltd. Company

DESIGNED BY KWR
CHECKED BY KWR
DRAWN BY PAAP
APPROVED BY JEH
HOR. SCALE: 1:500
VERTICAL SCALE:
RELEASED FOR CONSTRUCTION BY: J. VEILLEUX
DATE 2005/06/27
DATE

ENGINEER'S SEAL
ORIGINAL SIGNED BY
K.W. RAE
2006/04/26

CONSULTANT DRAWING NO.
LC1.01

Winnipeg
THE CITY OF WINNIPEG
WATER AND WASTE DEPARTMENT
ENGINEERING DIVISION

WEWPCC
BIOLOGICAL NUTRIENT REMOVAL UPGRADE
CONTRACT No. 3

CITY FILE NUMBER
SHEET OF
CITY DRAWING NUMBER

CIVIL
AREA L – GENERAL & SITE WORKS
PAVING AND GRADING PLAN

ISSUED FOR TENDER

07/04/06 04:19pm lee.edge L:\work\76000\76063\02a-CAD\TRA\CONTR\bnr\LC1.01-BND.dwg Layout:Layout1