


PRIMARY CLARIFIERS

BIOREACTORS

SECONDARY CLARIFIERS

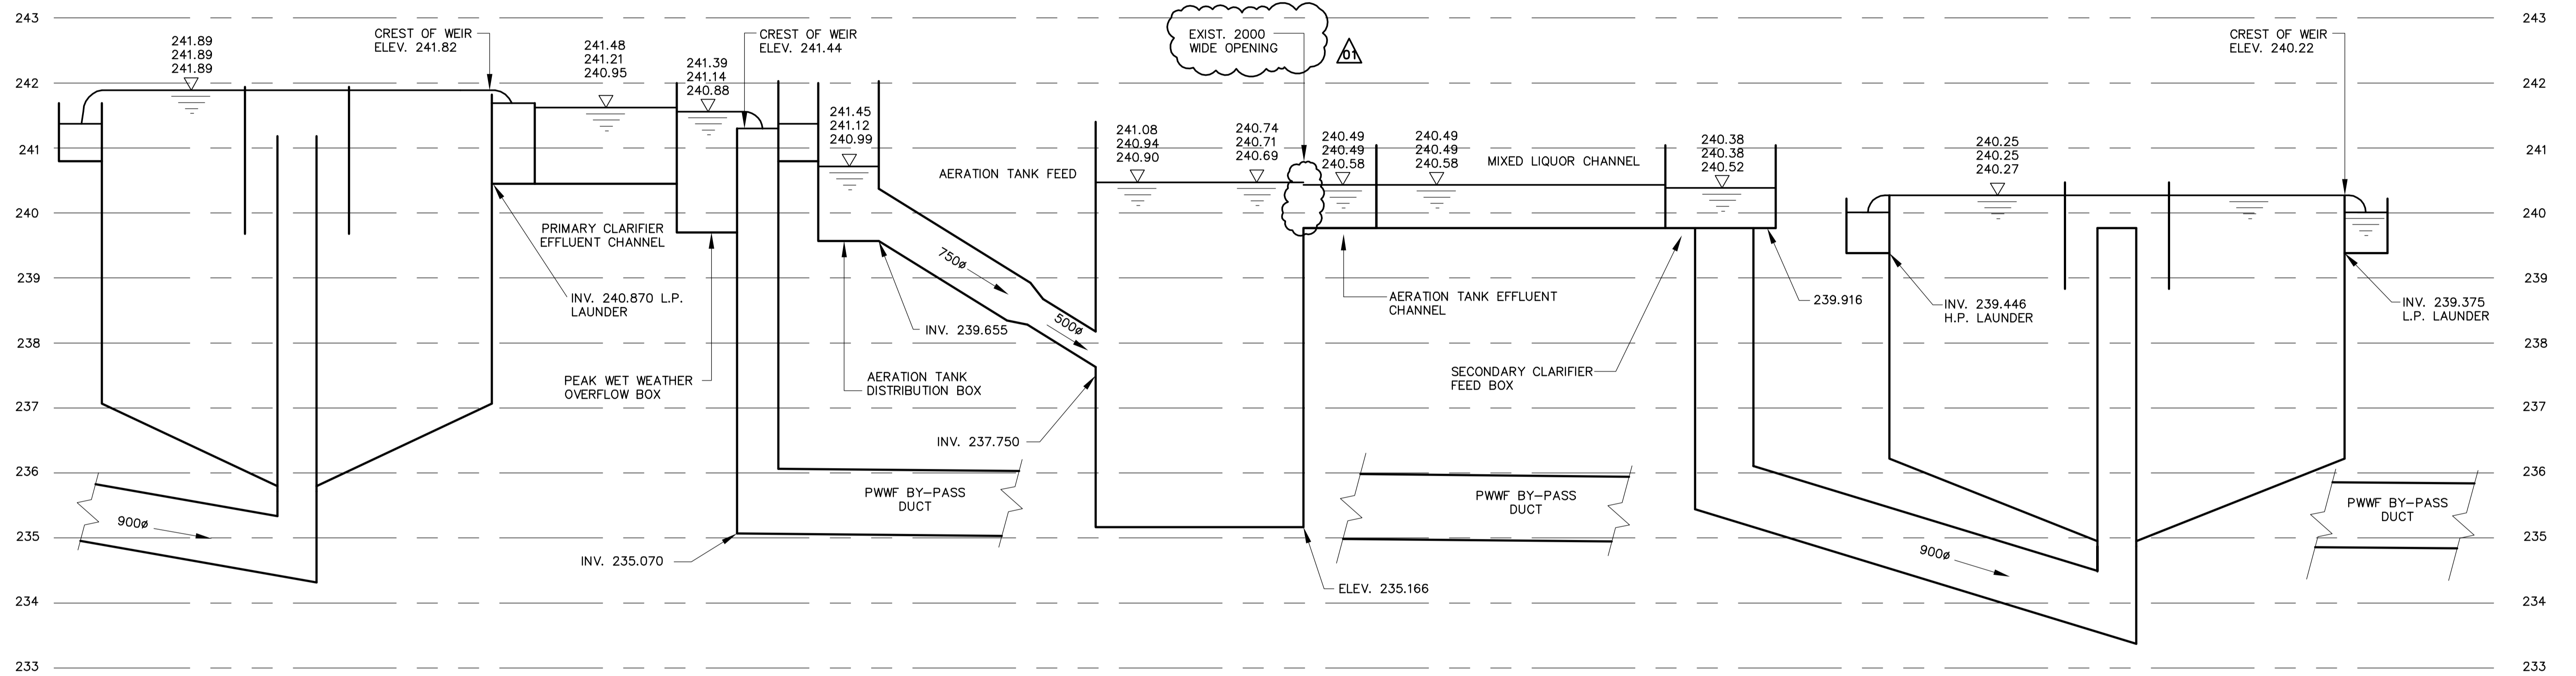

LEGEND

- 241.39 — 90 ML/d BNR, 2 BIOREACTORS AND 3 SECONDARY CLARIFIERS (EQUIVALENT TO 45 ML/d ONE REACTOR OUT OF SERVICE)
- 241.14 — 54 ML/d BNR, 2 BIOREACTORS AND 3 SECONDARY CLARIFIERS
- 240.88 — 54 ML/d EXISTING, 2 BIOREACTORS AND 2 SECONDARY CLARIFIERS.



NO.	REVISIONS	DATE	BY
01	21-2006 ADDENDUM 6	06/06/30	JBC
00	ISSUED FOR TENDER	06/04/26	SRP



DESIGNED BY	CGL	CHECKED BY	KJS
DRAWN BY	LAE	APPROVED BY	JEH
HOR. SCALE: NONE		RELEASED FOR CONSTRUCTION BY: J. VEILLEUX	
VERTICAL SCALE:		DATE 2002/04/08	

ENGINEER'S SEAL
ORIGINAL SIGNED BY
J.E. HUTCHISON
2006/04/26
CONSULTANT DRAWING NO.
LP1.01

THE CITY OF WINNIPEG
 WATER AND WASTE DEPARTMENT
 ENGINEERING DIVISION

WEWPCC
 BIOLOGICAL NUTRIENT REMOVAL UPGRADE
 CONTRACT 3

PROCESS
 AREA L - GENERAL & SITEWORKS
 BNR HYDRAULIC PROFILE

CITY FILE NUMBER
 SHEET OF
 CITY DRAWING NUMBER