SHEET: COW-A1 (03/2005)

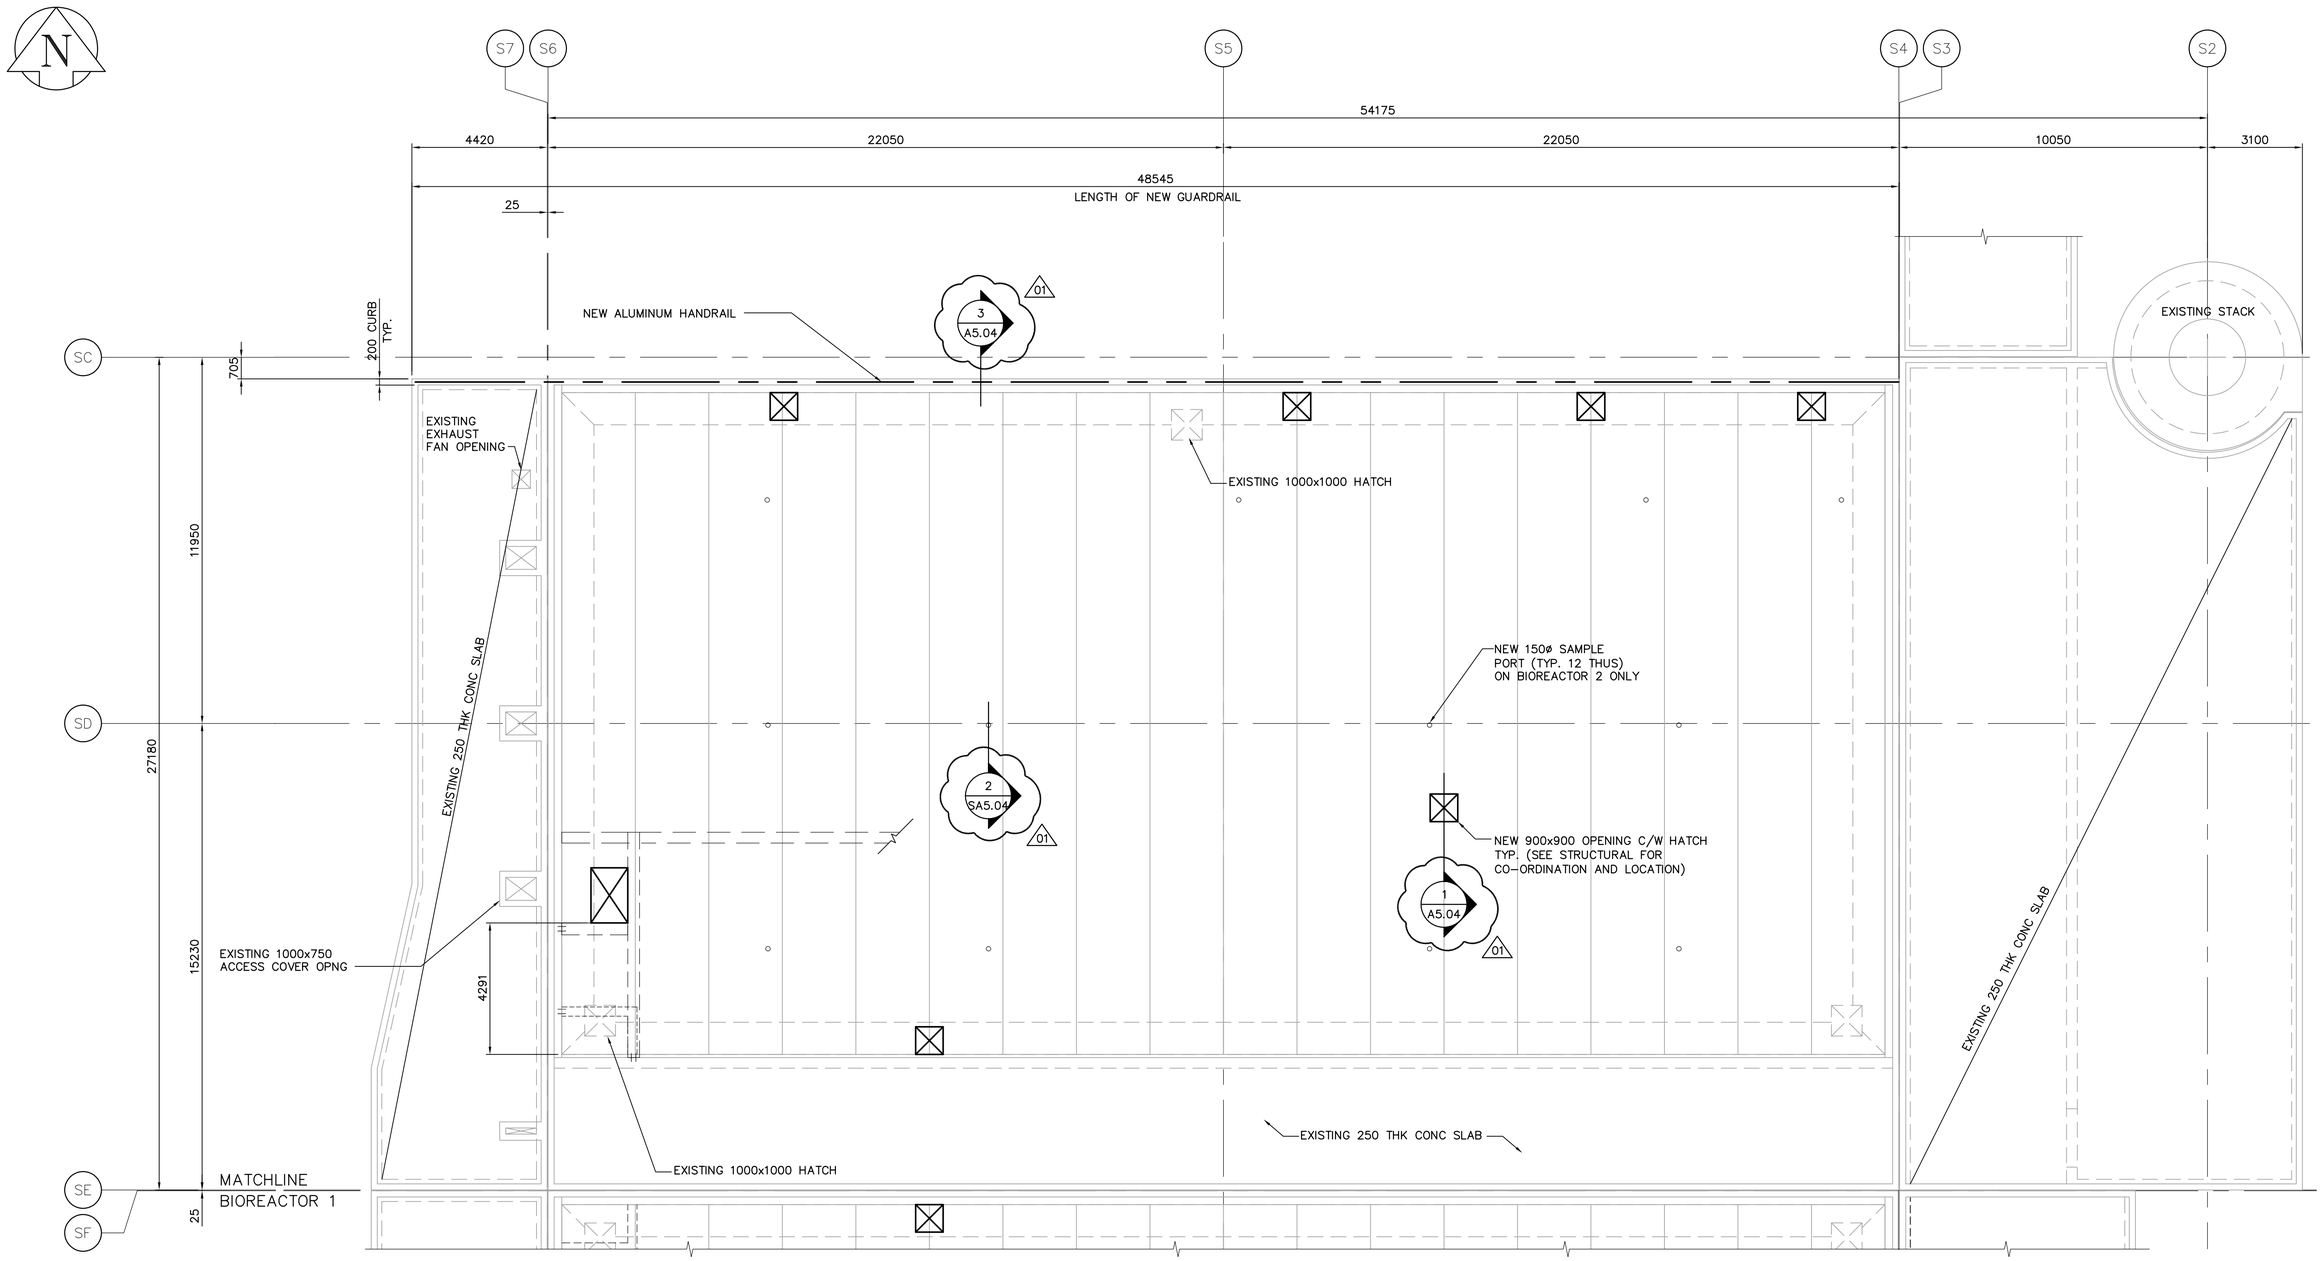

NOTE: REFER TO STRUCTURAL DRAWINGS FOR HATCH LOCATIONS

ROOF PLAN – BIOREACTOR 2

SCALE : 1:100

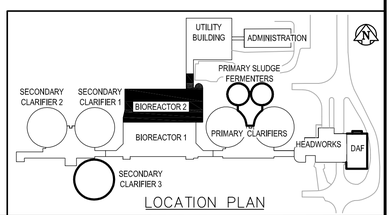

LOCATION PLAN

PROVINCE OF MANITOBA
NEIL COOPER ARCHITECT INC.
№090
APPROVED ARCHITECTURAL CORPORATION

B.M. ELEV.

NO.	REVISIONS	DATE	BY
01	21-2006 ADDENDUM 6	06/07/05	LK
00	21-2006 ADDENDUM 3	06/05/25	LK

EarthTech
A Tyco International Ltd. Company

DESIGNED BY	LK	CHECKED BY	NC
DRAWN BY	LK	APPROVED BY	JEH
HOR. SCALE:	AS NOTED	RELEASED FOR CONSTRUCTION BY:	J. VEILLEUX
VERTICAL SCALE:			
DATE	2006/05/19	DATE	2006/05/25

ENGINEER'S SEAL
ORIGINAL SIGNED BY
N. COOPER
2006/05/25

CONSULTANT DRAWING NO.
SA5.03

Winnipeg
THE CITY OF WINNIPEG
WATER AND WASTE DEPARTMENT
ENGINEERING DIVISION

WEWPCC
BIOLOGICAL NUTRIENT REMOVAL UPGRADE
CONTRACT No. 3

ARCHITECTURAL
AREA S – BIOREACTOR 2
ROOF GUARDRAIL PLAN

CITY FILE NUMBER
SHEET OF
CITY DRAWING NUMBER

07/04/06 04:45pm lee.edge L:\work\76000\76063\02a-CAD\ARCH\CONTR\bnr – contract 3\04127-SA5.03R1.dwg Layout:BIO. 2