SHEET: COW-A1 (03/2005)

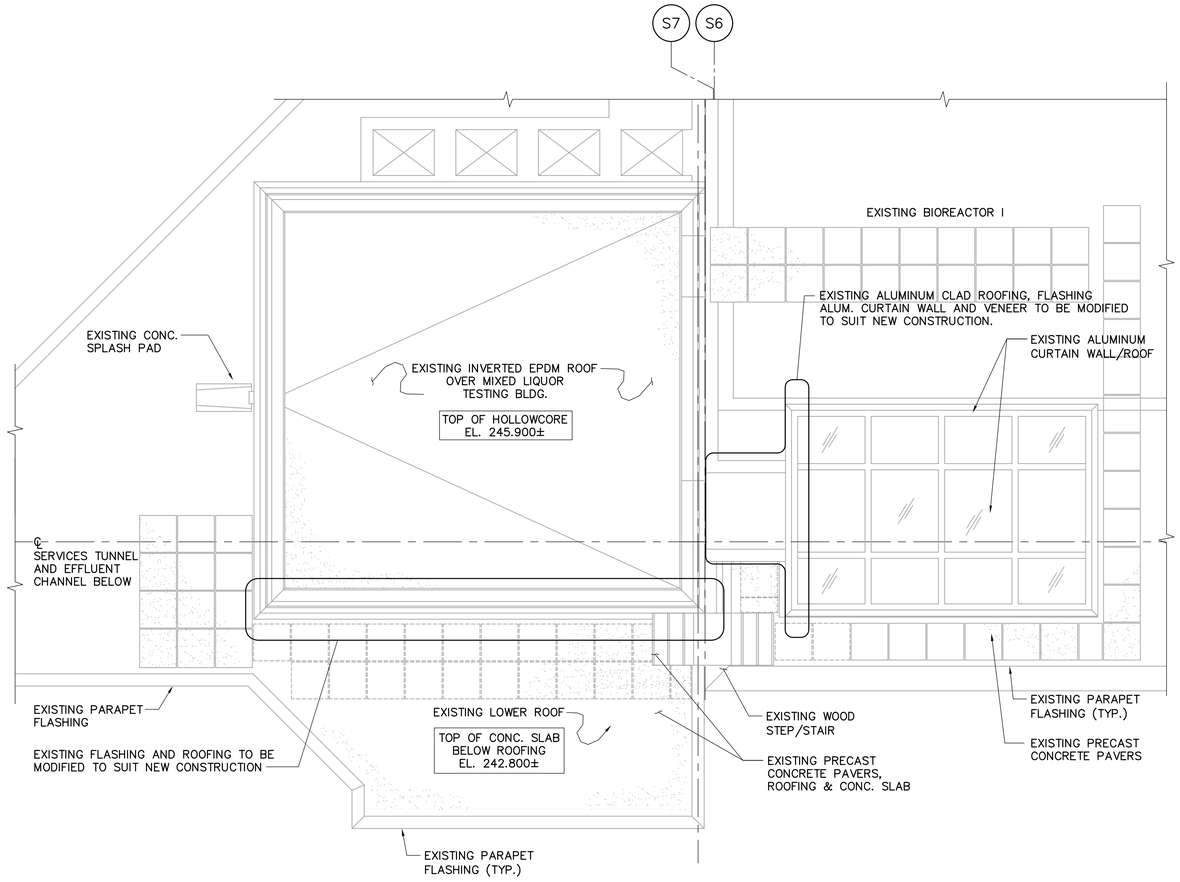

1 SA6.01 ROOF DEMOLITION PLAN
SCALE 1:50

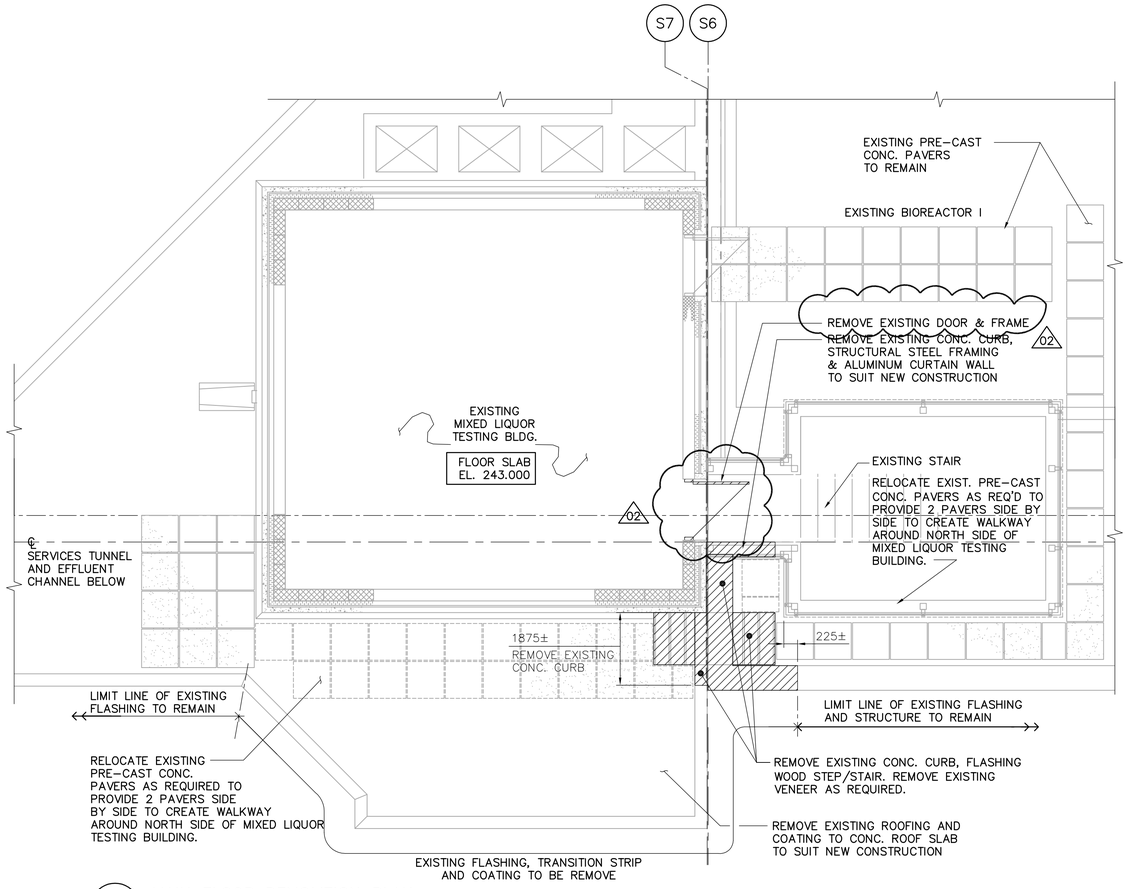

2 SA6.01 MAIN FLOOR DEMOLITION PLAN
SCALE 1:50

NOTE:

1. DIMENSIONS NOTED ARE APPROXIMATE. SITE CONFIRM ALL DIMENSION PRIOR TO CONSTRUCTION.

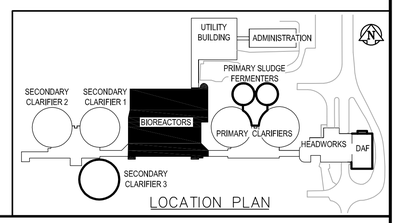

LOCATION PLAN

PROVINCE OF MANITOBA
NEIL COOPER ARCHITECT INC.
No.090
APPROVED ARCHITECTURAL CORPORATION

B.M.
ELEV.

NO.	REVISIONS	DATE	BY
02	21-2006 ADDENDUM 6	06/07/05	LK
01	21-2006 ADDENDUM 3	06/05/19	LK
00	ISSUED FOR TENDER	06/04/26	CMF

EarthTech
A Tyco International Ltd. Company

DESIGNED BY ARA/LK
CHECKED BY NC
DRAWN BY JI
APPROVED BY JEH
HOR. SCALE: AS NOTED
VERTICAL SCALE: AS NOTED
RELEASED FOR CONSTRUCTION BY: J. VEILLEUX
DATE 2005/12/27
DATE 2006/04/26

ENGINEER'S SEAL
ORIGINAL SIGNED BY
N. COOPER
2006/04/26

CONSULTANT DRAWING NO.
SA6.01

Winnipeg
THE CITY OF WINNIPEG
WATER AND WASTE DEPARTMENT
ENGINEERING DIVISION

WEWPCC
BIOLOGICAL NUTRIENT REMOVAL UPGRADE
CONTRACT No. 3

CITY FILE NUMBER
SHEET 1 OF 5

ARCHITECTURAL
AREA S – BIOREACTORS
ELECTRICAL ROOM ROOF & MAIN FLOOR DEMOLITION PLANS

CITY DRAWING NUMBER

07/04/06 04:42pm lee.edge L:\work\76000\76063\02a-CAD\ARCH\CONTR\bnr – contract 3\04127-SA6.01R2.dwg Layout:Layout1