

FOR CONTINUATION
SEE DRAWING SP2.04

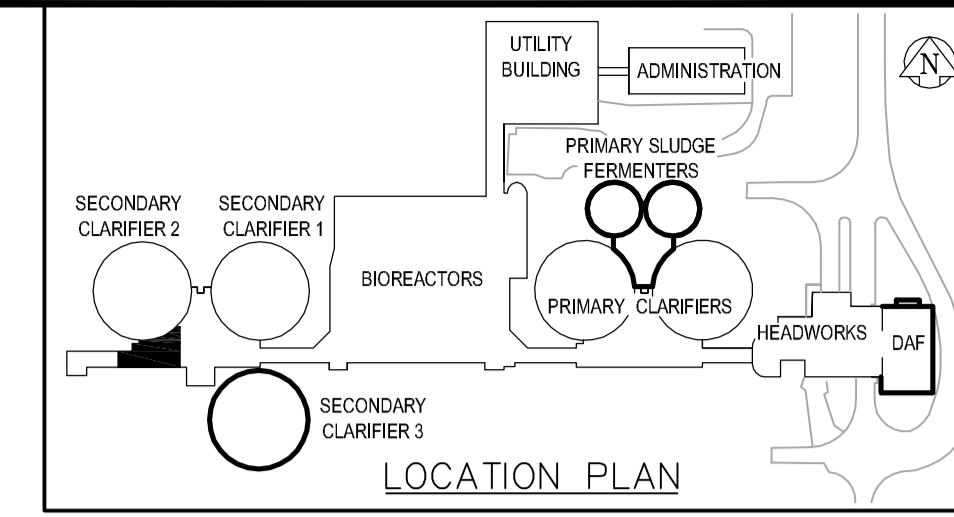
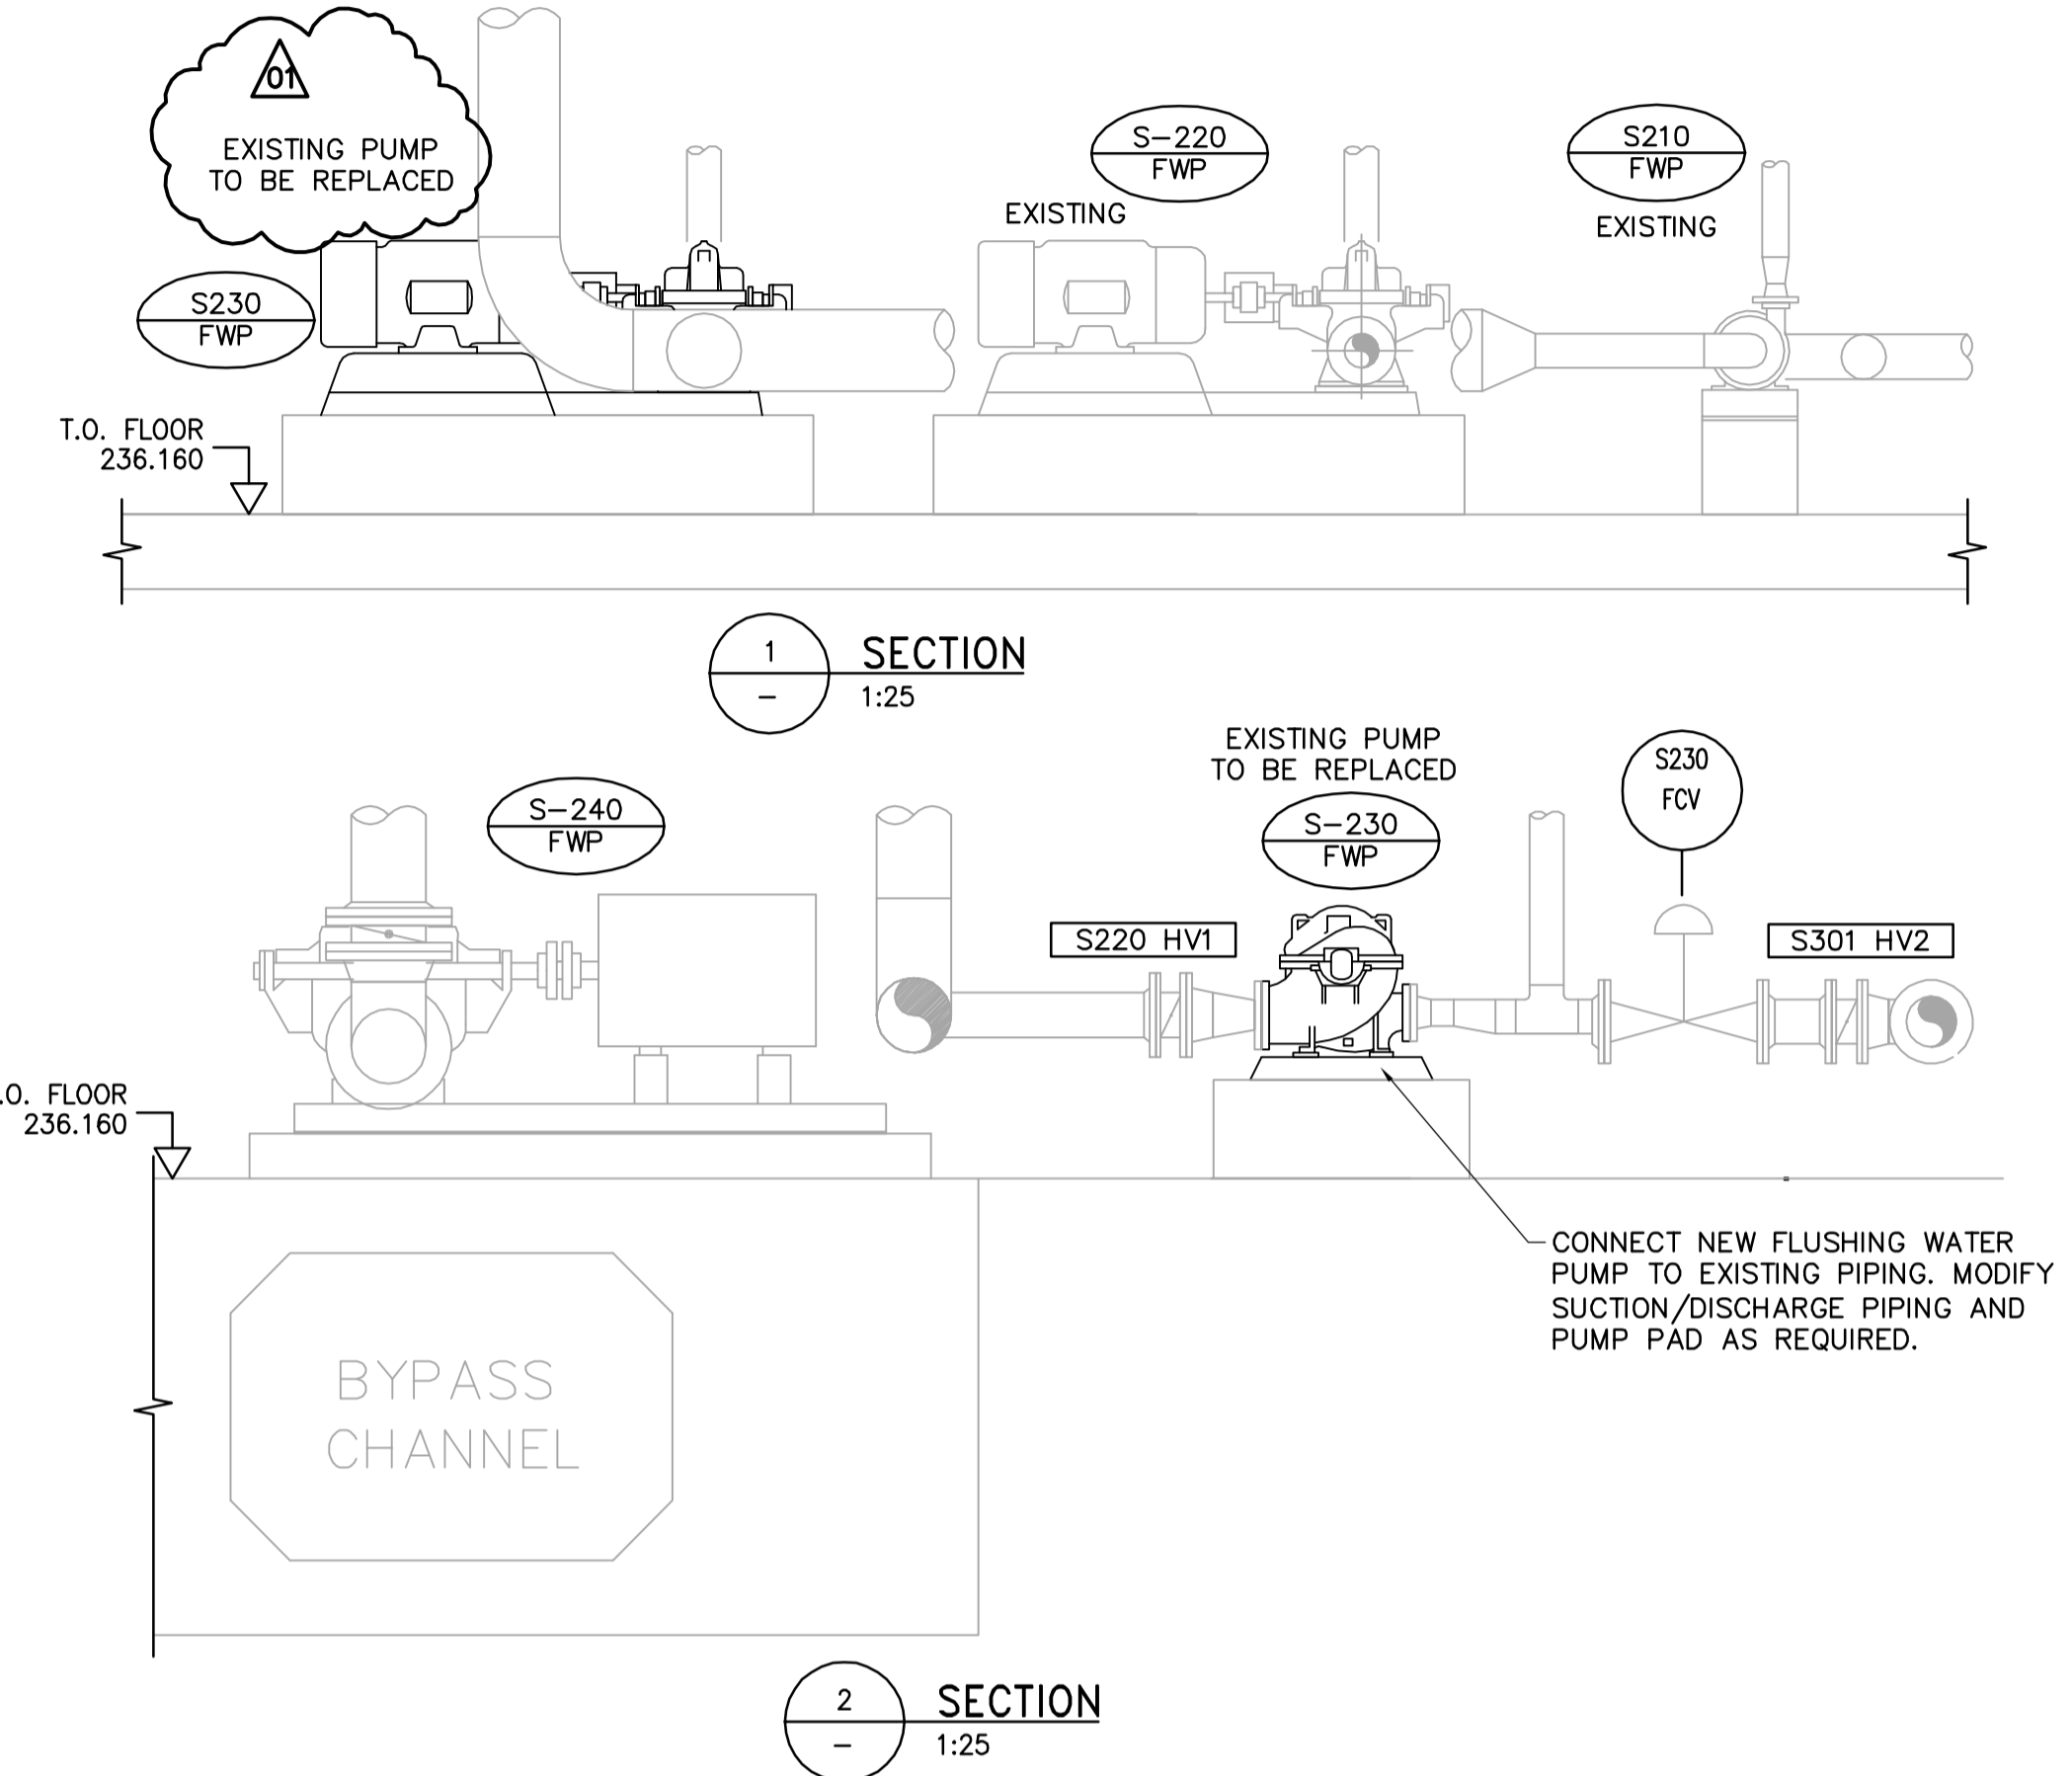


FIGURE A

GENERAL NOTES

1. CONTRACTOR TO CONFIRM EXISTING PIPE AND EQUIPMENT DIMENSIONS AND LOCATIONS PRIOR TO CONSTRUCTION.

APECM
Certificate of Authorization
Earth Tech Canada Inc.
No. 730 Expiry: April 30, 2006

B.M. ELEV.			
DESIGNED BY	KS	CHECKED BY	KM
DRAWN BY	PJY	APPROVED BY	JEH
NO.	REVISIONS	DATE	BY
01	21-2006 ADDENDUM 6	06/06/30	JBC
00	ISSUED FOR TENDER	06/04/26	PJY
NO.	REVISIONS	DATE	BY
		2005/10/06	

EarthTech
A Tyco International Ltd. Company

DESIGNED BY: KS
DRAWN BY: PJY
CHECKED BY: KM
APPROVED BY: JEH

HOR. SCALE: AS NOTED
VERTICAL SCALE:

RELEASED FOR CONSTRUCTION BY: J. VEILLEUX
DATE: 2006/04/26

ENGINEER'S SEAL
ORIGINAL SIGNED BY: J.E. HUTCHISON
DATE: 2006/04/26
CONSULTANT DRAWING NO. SP2.06

THE CITY OF WINNIPEG
WATER AND WASTE DEPARTMENT
ENGINEERING DIVISION

WEWPCC
BIOLOGICAL NUTRIENT REMOVAL UPGRADE
CONTRACT 3

CITY FILE NUMBER
SHEET OF
CITY DRAWING NUMBER

PROCESS
AREA S - SECONDARY CLARIFIERS
FLUSHING WATER PUMP PLAN AND SECTIONS