


**EXHAUST FAN ROOM - PLAN**  
SCALE: 1:50

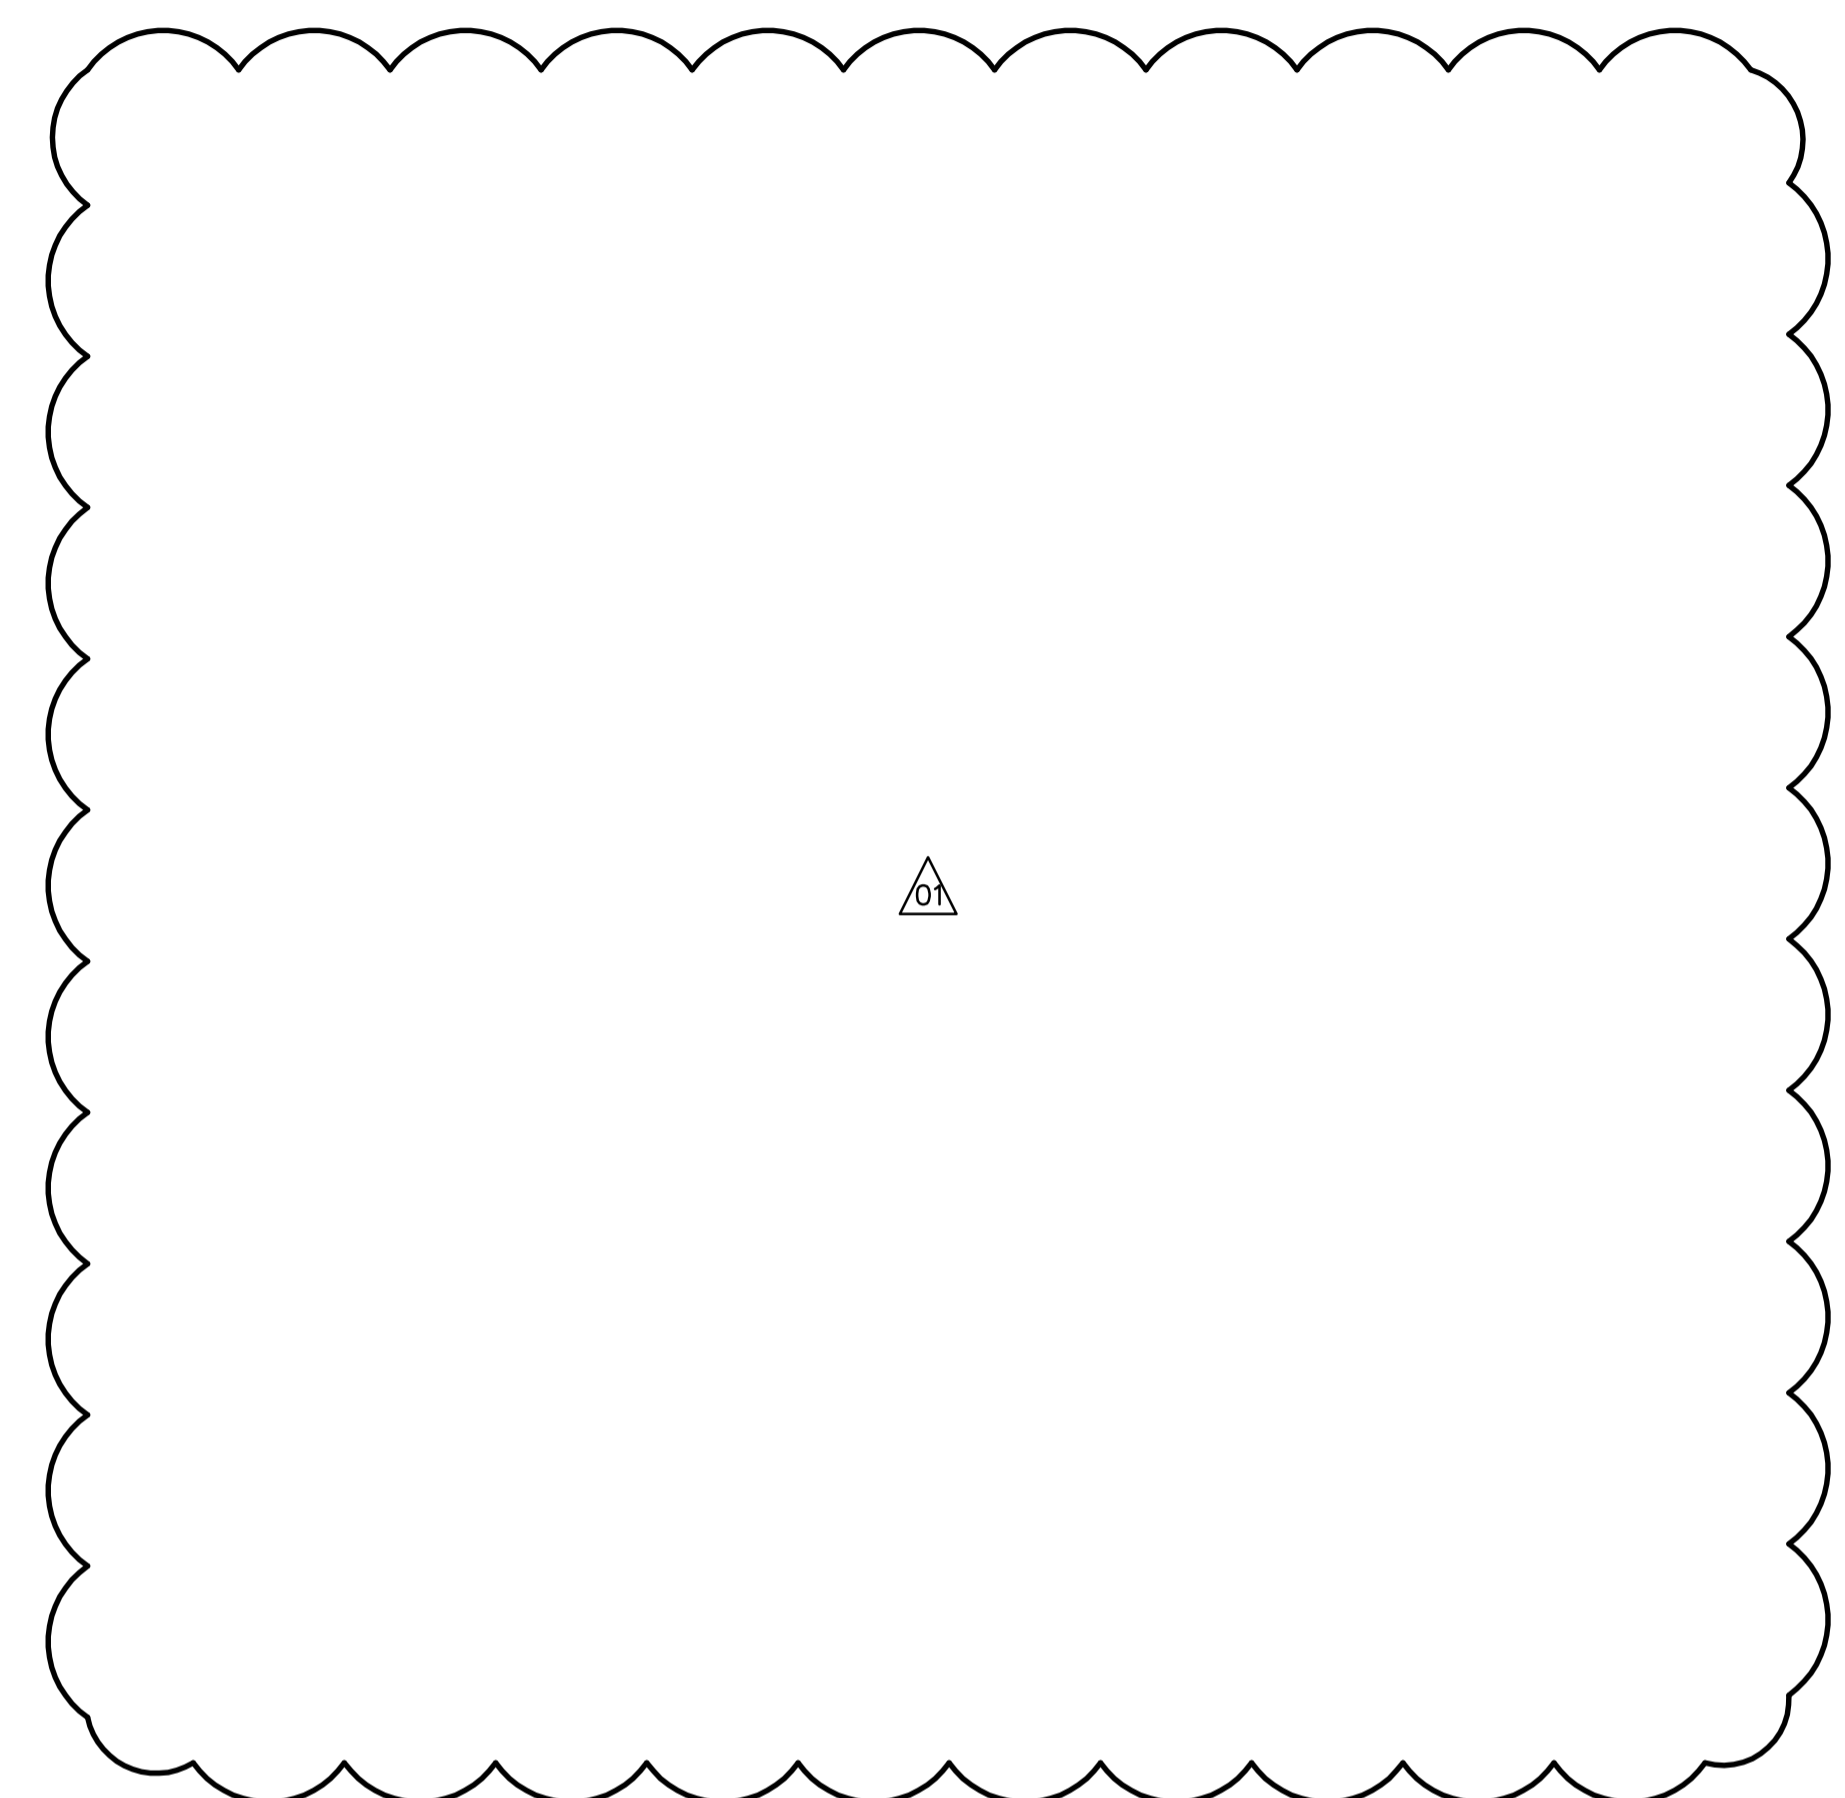

**NOTES:**  
1. OVERHEAD DOOR #2 (O/H DOOR #2) SHALL BE SUPPLIED AND INSTALLED BY O/H DOOR SUPPLIER. ELECTRICAL SUBCONTRACTOR TO PROVIDE DISCONNECT SWITCH AND CONNECT DOOR MOTOR. ALL CONTROLS TO BE PART OF DOOR SUPPLY.

 Certificate of Authorization Earth Tech Canada Inc. No. 730 Expiry: April 30, 2007	B.M. ELEV.	 A Tyco International Ltd. Company	ENGINEER'S SEAL	 THE CITY OF WINNIPEG WATER AND WASTE DEPARTMENT ENGINEERING DIVISION		
			DESIGNED BY PS		CHECKED BY GSN	ORIGINAL SIGNED BY P. STRYK
			DRAWN BY CPG		APPROVED BY JEH	2005/05/15
	01 291-2006 ADDENDUM 3 06/07/12 CPG	SCALE: 1:50	RELEASED FOR CONSTRUCTION BY: K. MARTENS	NEWPCC CENTRATE NUTRIENT TREATMENT NITROGEN REMOVAL FACILITY		
	00 ISSUED FOR TENDER 06/05/15 CPG	DATE 2006/02/23	DATE 2006/05/15	CITY FILE NUMBER		
	NO. REVISIONS			SHEET OF		
				CITY DRAWING NUMBER		
				ELECTRICAL FAN ROOM PLAN POWER, LIGHTING AND SYSTEMS		
				CONSULTANT DRAWING NO. E2.06		