


1 DETAIL
P13.01 SCALE 1:25

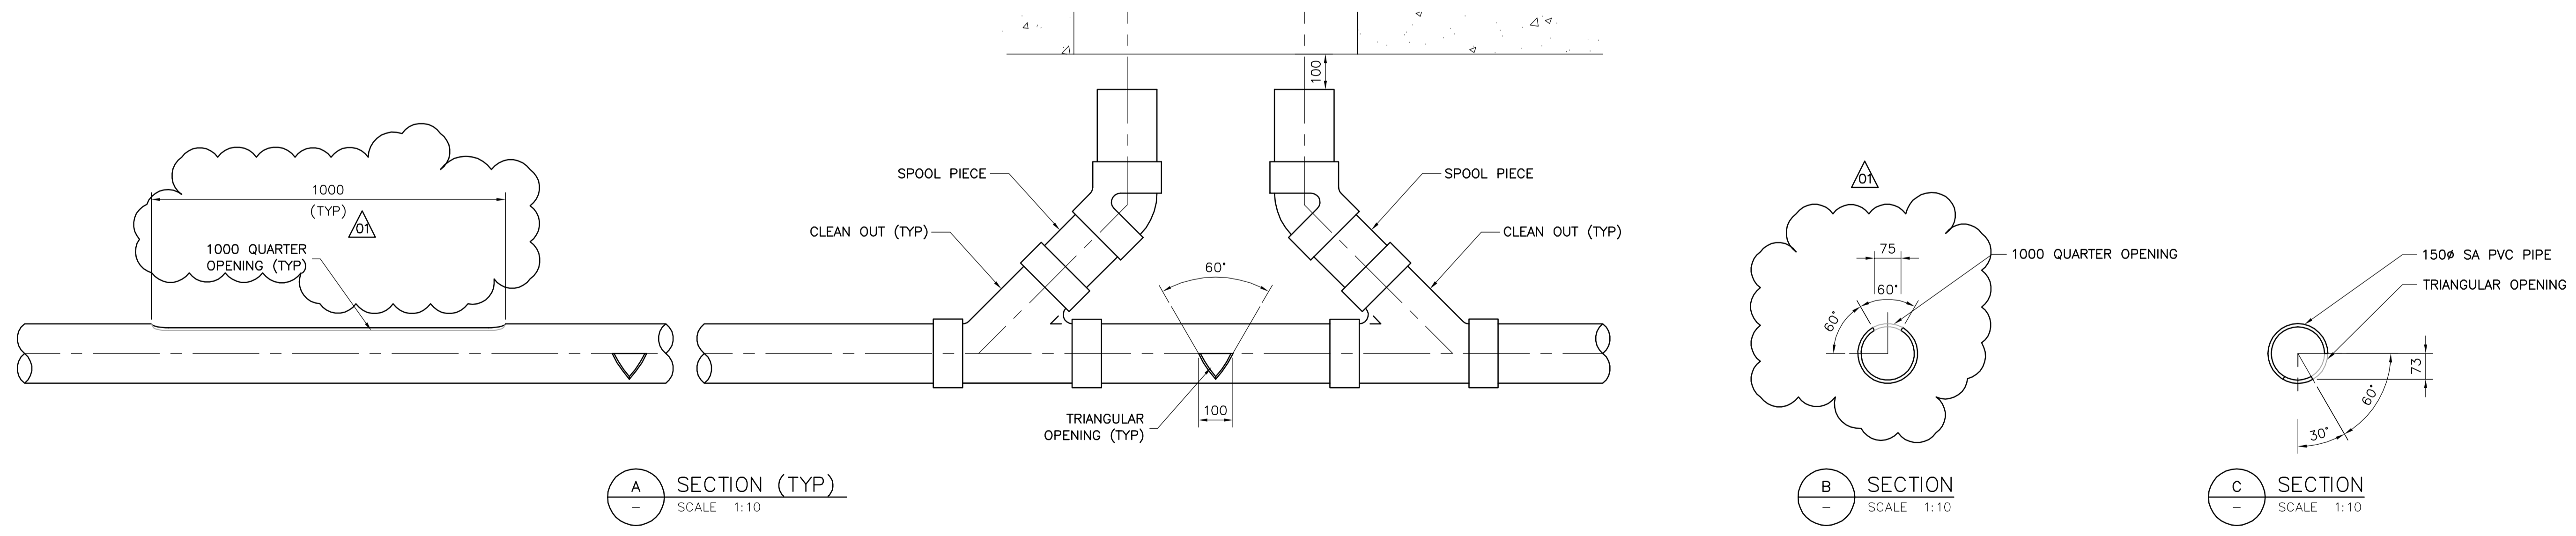

APECM
Certificate of Authorization
Earth Tech Canada Inc.
No. 730 Expiry: April 30, 2007

NO.	REVISIONS	DATE	BY
01	291-2006 ADDENDUM 3	06/07/12	LAE
00	ISSUED FOR TENDER	06/05/15	GLG

EarthTech
A Tyco International Ltd. Company

DESIGNED BY: LW	CHECKED BY: SB
DRAWN BY: GLG	APPROVED BY: JEH
SCALE: AS NOTED	RELEASED FOR CONSTRUCTION BY: K. MARTENS
DATE: 2006/02/03	DATE: 2006/05/15

ENGINEER'S SEAL
ORIGINAL SIGNED BY: J.E. HUTCHISON
2006/05/15
CONSULTANT DRAWING NO. P18.01

THE CITY OF WINNIPEG
WATER AND WASTE DEPARTMENT
ENGINEERING DIVISION

NEWPCC CENTRATE NUTRIENT TREATMENT NITROGEN REMOVAL FACILITY

PROCESS SODA ASH PIPES PLAN, SECTIONS & DETAILS

CITY FILE NUMBER	SHEET OF
CITY DRAWING NUMBER	