


E DETAIL
WG-S0203 1:30

F DETAIL
WG-S0203 1:30

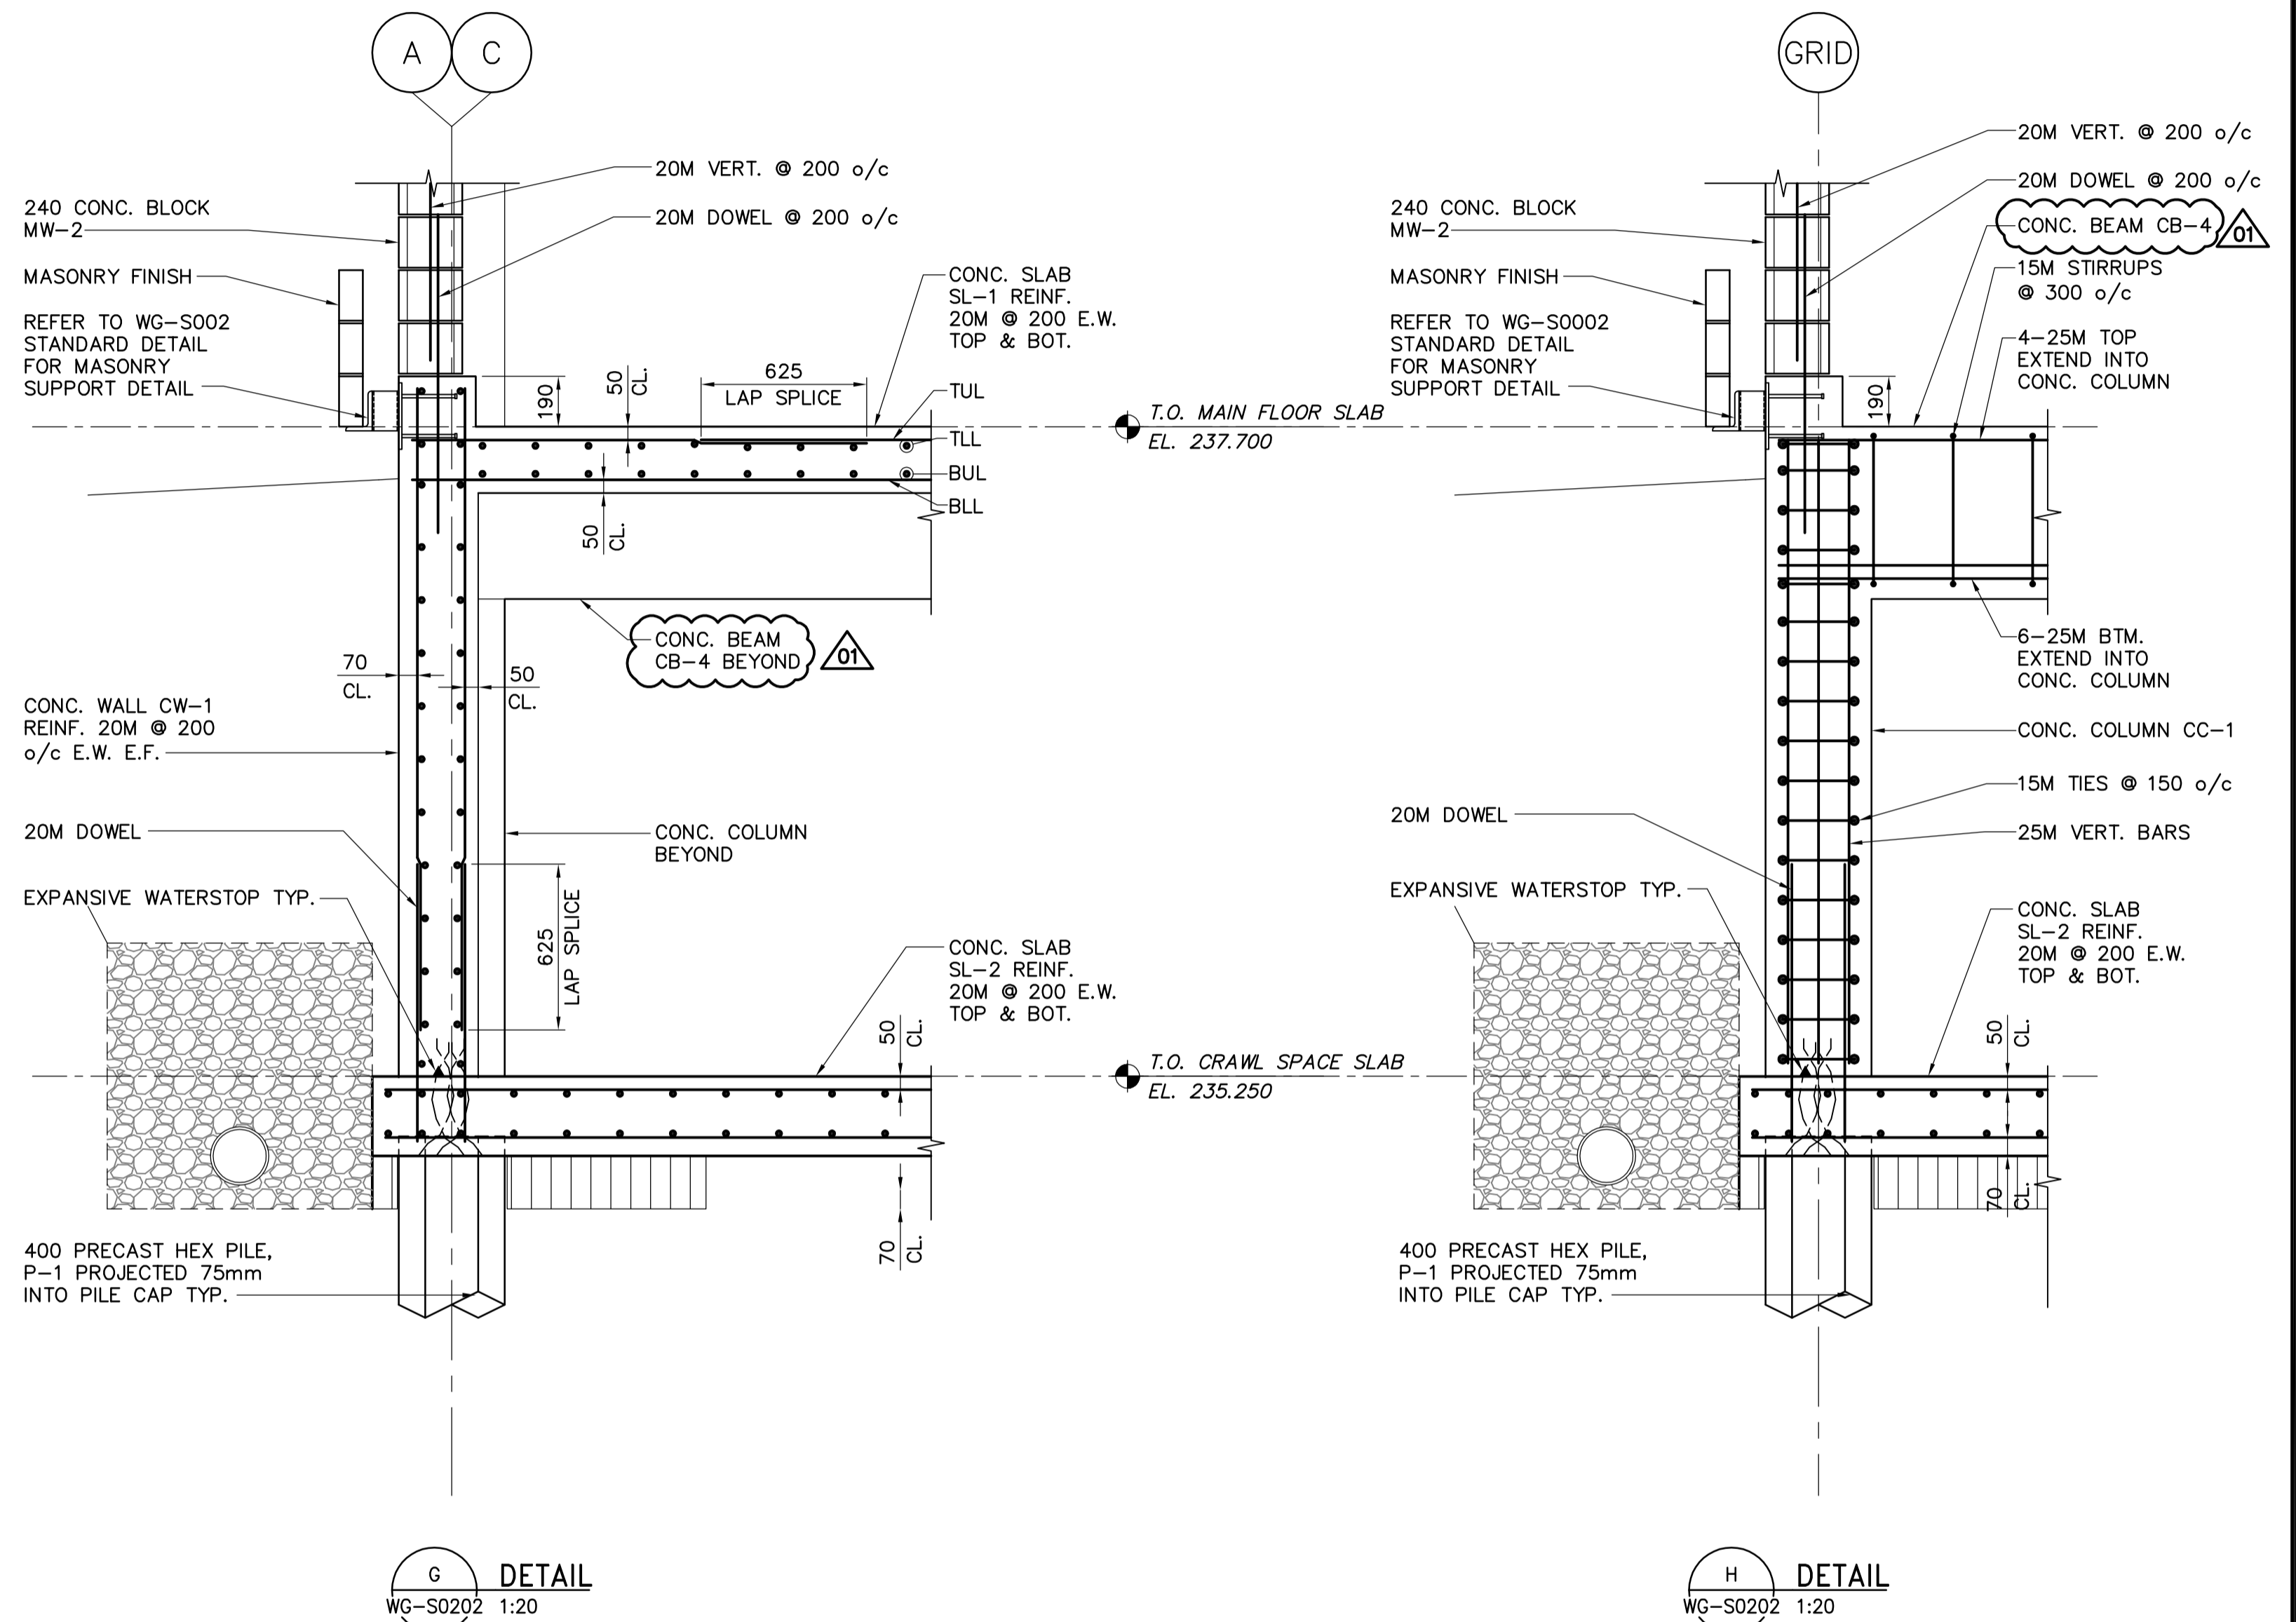

G DETAIL
WG-S0202 1:20

H DETAIL
WG-S0202 1:20



B.M. ELEV.					
DESIGNED BY	AP/GGP	CHECKED BY	MK		
DRAWN BY	KK	APPROVED BY	AHL		
SCALE:	AS SHOWN	RELEASED FOR CONSTRUCTION BY:	R. SOROKOWSKI		
NO. REVISIONS		DATE	2006/06/16	DATE	2006/08/30

Frederickson Cooper ARCHITECTS		A Type International Ltd. Company	
DESIGNED BY	AP/GGP	CHECKED BY	MK
DRAWN BY	KK	APPROVED BY	AHL
SCALE:	AS SHOWN	RELEASED FOR CONSTRUCTION BY:	R. SOROKOWSKI
DATE	2006/06/16	DATE	2006/08/30

ENGINEER'S SEAL	
ORIGINAL SIGNED BY	A. POCHANART
	2006/08/30
CONSULTANT DRAWING NO.	WG-S0402

		THE CITY OF WINNIPEG WATER AND WASTE DEPARTMENT ENGINEERING DIVISION	
WATER TREATMENT PLANT STANDBY POWER GENERATOR		CITY FILE NUMBER	
		SHEET OF	
STRUCTURAL		CITY DRAWING NUMBER	
DETAILS		1-0601G-A-S0402-001-01D	