


PLAN VIEW
SCALE: 15:1

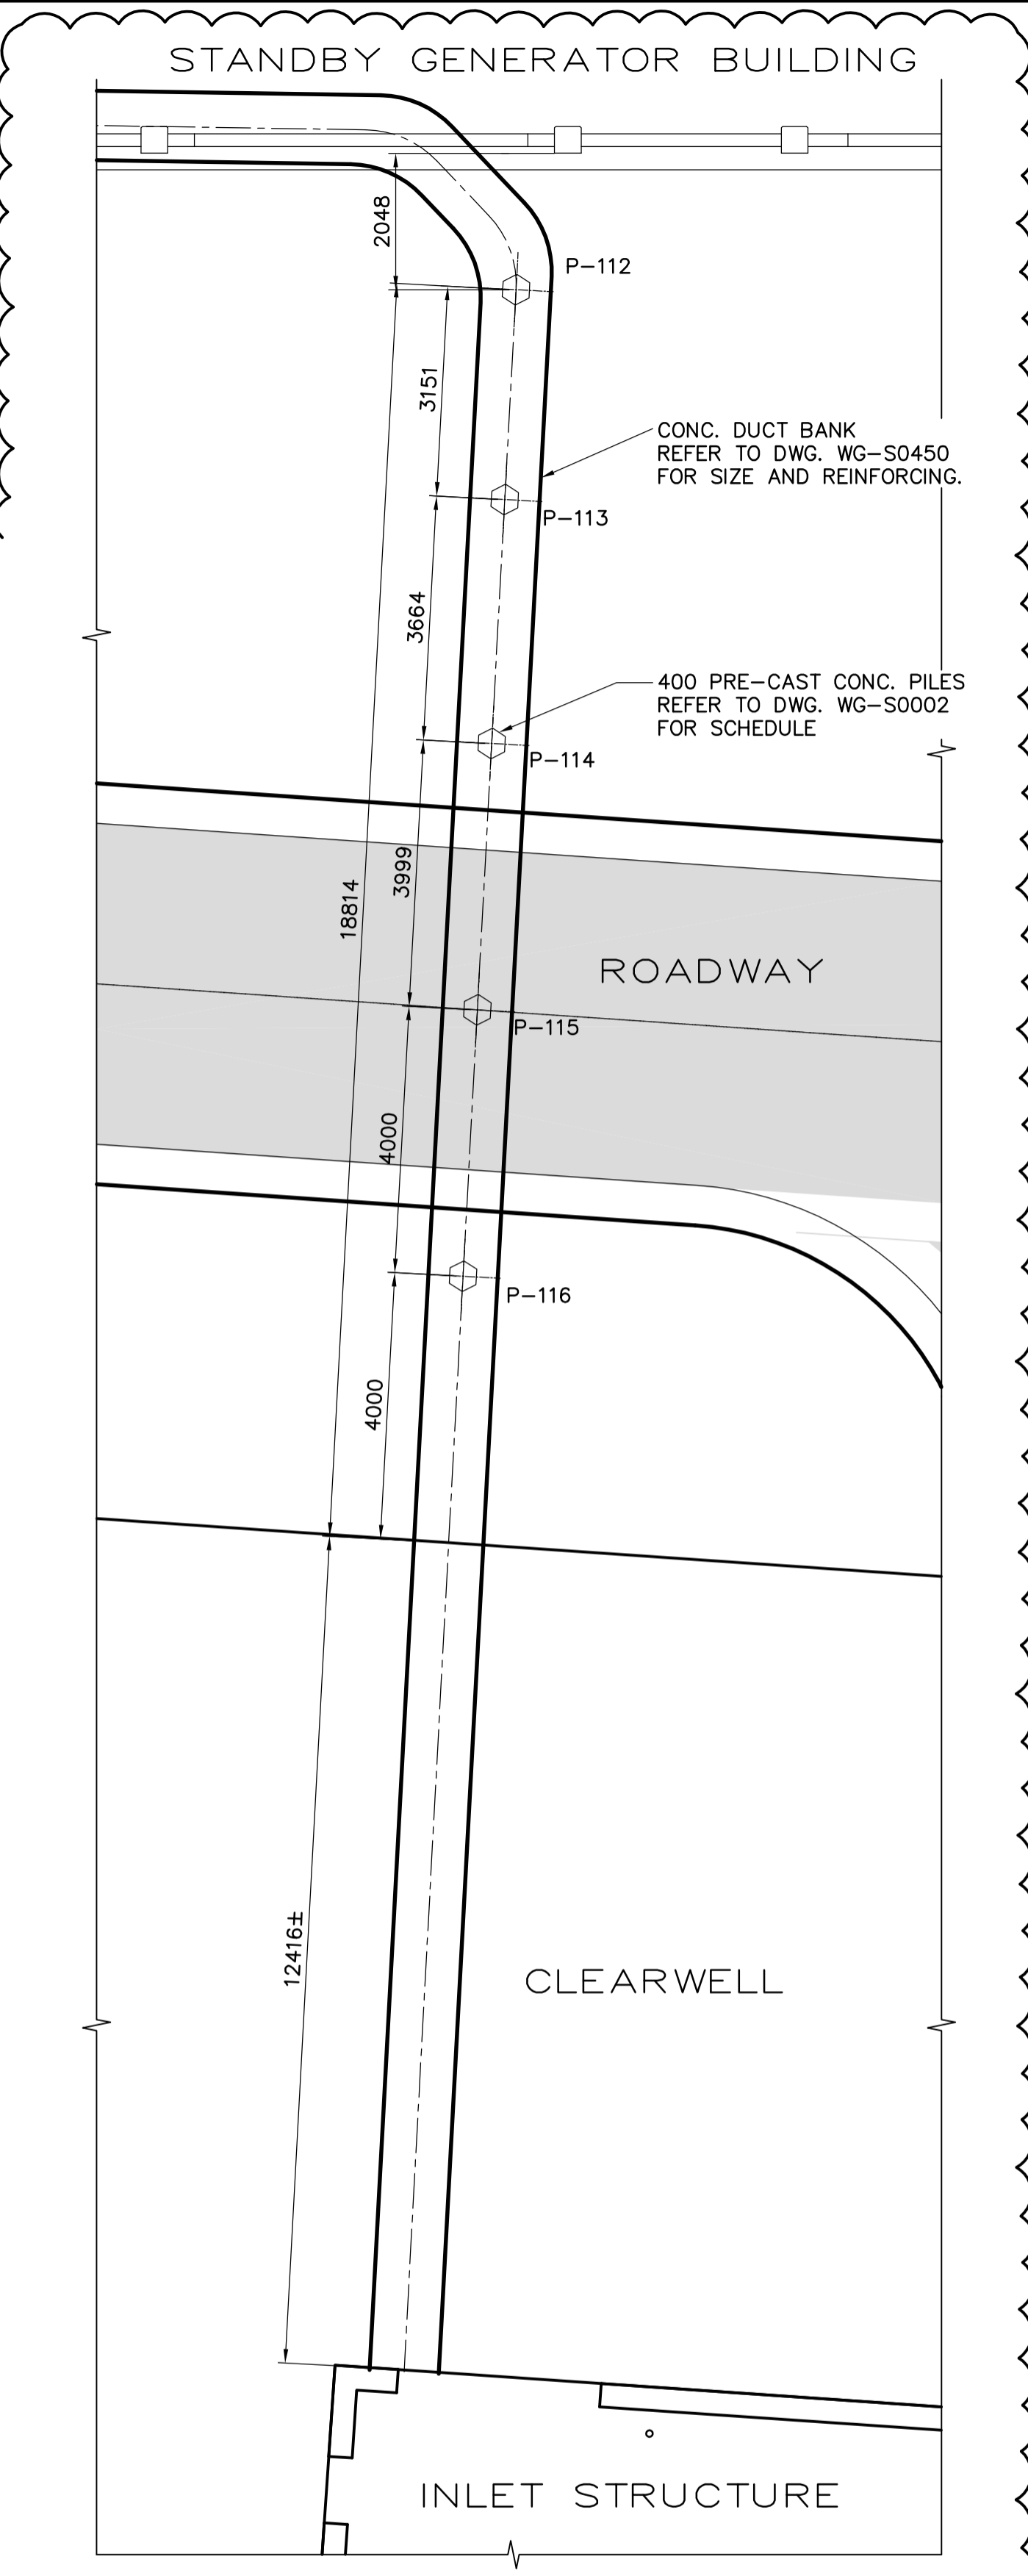

PLAN VIEW
SCALE: 12:1

FINAL LOCATION OF TRANSFORMERS TO BE DETERMINED BY MANITOBA HYDRO WHEN TRANSFORMER AND GROUNDING GRID SIZES ARE FINALIZED. CONTRACTOR TO ALLOW FOR EXTRA 2m LENGTH OF EACH DUCT BANK. COORDINATE LOCATION WITH MANITOBA HYDRO.



NO.	REVISIONS	DATE	BY
02	498-2006 ADDENDUM 7	06/10/19	KK
01	498-2006 ADDENDUM 6	06/10/16	KK
00	ISSUED FOR TENDER	06/08/28	KK

DESIGNED BY	AP/GGP	CHECKED BY	GGP
DRAWN BY	CMF	APPROVED BY	AHL
SCALE:	AS SHOWN	RELEASED FOR CONSTRUCTION BY:	R. SOROKOWSKI
DATE	2006/07/04	DATE	2006/08/30

ENGINEER'S SEAL	ORIGINAL SIGNED BY
	A. POCHANART
	2006/08/30
CONSULTANT DRAWING NO.	WG-S0451

THE CITY OF WINNIPEG
WATER AND WASTE DEPARTMENT
ENGINEERING DIVISION

WATER TREATMENT PLANT
EMERGENCY POWER GENERATOR

STRUCTURAL
DUCT BANK PLANS

CITY FILE NUMBER
SHEET OF
CITY DRAWING NUMBER
1-0601G-A-S0451-001-02D