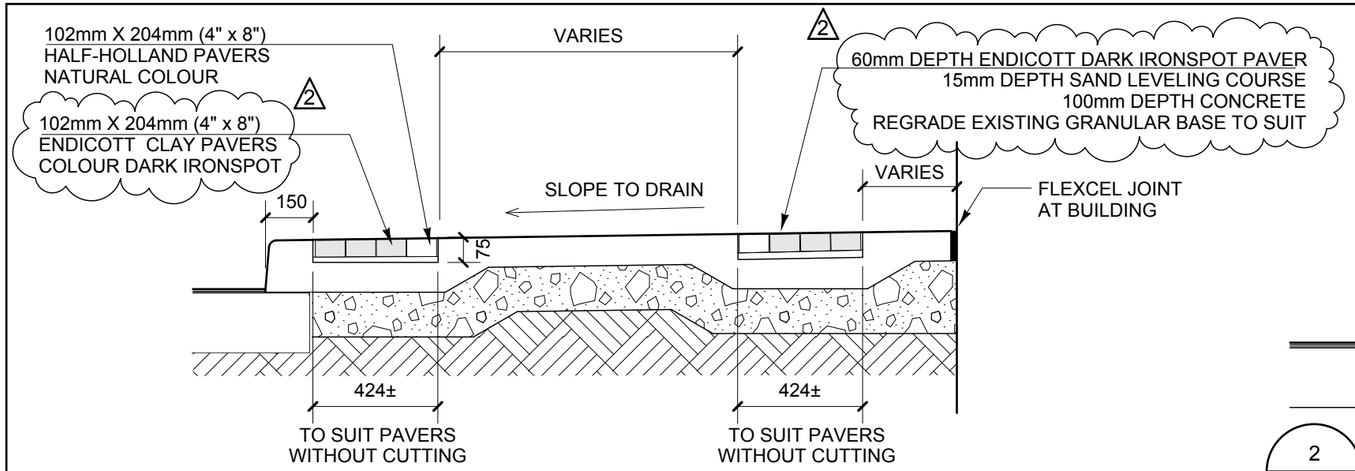

1 / L03 CONCRETE WALKWAY PAVING SECTION

SCALE: 1:20

0 1m 2m

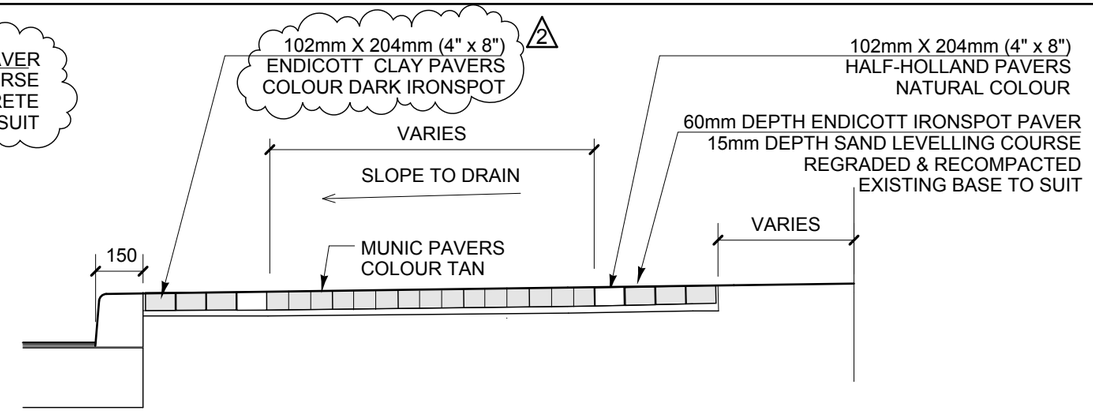

2 / L03 REGRADED PAVER WALKWAY PAVING SECTION

SCALE: 1:20

0 1m 2m

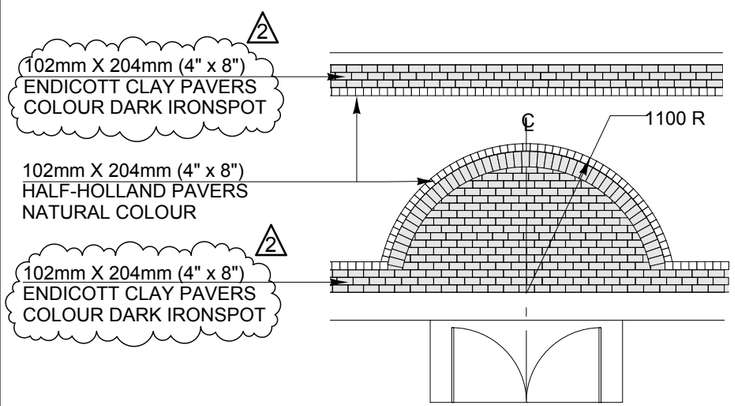

3 / L03 ENTRY PAVING DETAIL

SCALE: 1:75

0 1 2 3 4 5m

DETAIL 'B' CONC. TREE WELL CURB SECTION

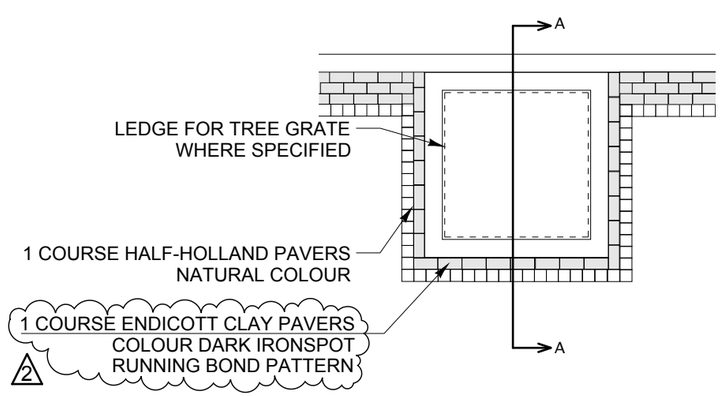

4 / L03 TREE WELL DETAIL

SCALE: NTS

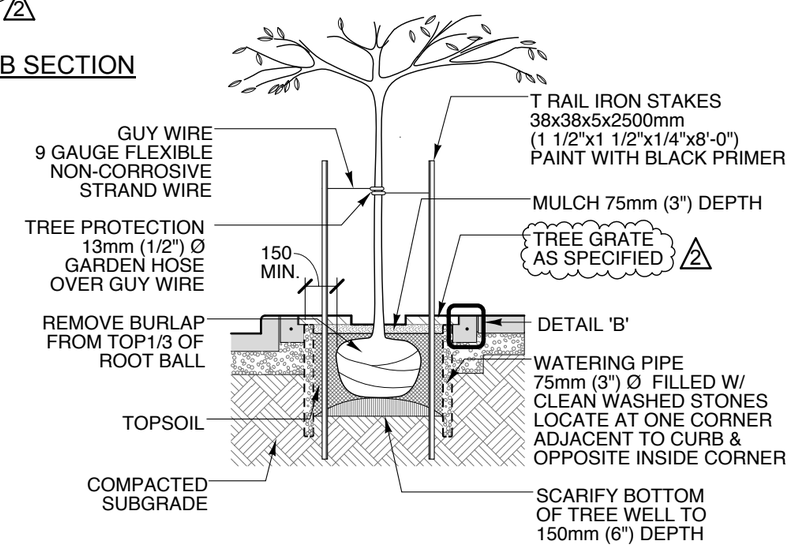

SECTION A-A TREE WELL CONSTRUCTION & PLANTING

HILDERMAN THOMAS FRANK CRAMPTON
Landscape Architecture • Planning
500 - 115 Bannatyne Avenue East, Winnipeg, MB R3B 0R3
Phone: 204.944.9907 Fax: 204.957.1467

B.M. ELEV. YY.MM.DD

NO.	REVISIONS	DATE	BY
2	ADDENDUM 1	9/11/06	RGM
1	RELEASED FOR TENDER	8/31/06	RGM
0	RELEASED FOR REVIEW	8/30/06	RGM

WARDROP Engineering Inc.

DESIGNED: RGM DRAWN: RGM/MB
SCALE: 1:200 APPROVED: RGM
DATE 9/11/06

CONSULTANT DRAWING NO 06-040-L03

THE CITY OF WINNIPEG
PUBLIC WORKS DEPARTMENT
ENGINEERING DIVISION

BROADWAY / EXCHANGE DISTRICT STREETSCAPE IMPROVEMENTS

CITY DRAWING NUMBER

SHEET 3 OF 6

EXCHANGE DISTRICT PAVING & PLANTING DETAILS

L03

DATE PLOTTED: 9/11/06