


THIS DRAWING MUST NOT BE SCALED.  
 THE GENERAL CONTRACTOR SHALL VERIFY ALL DIMENSIONS, DURING, AND LEVELS PRIOR TO COMMENCEMENT OF WORK. ALL ERRORS AND OMISSIONS TO BE REPORTED TO NUMBER TEN ARCHITECTURAL GROUP BEFORE PROCEEDING.  
 VARIATIONS AND MODIFICATIONS TO WORK SHOWN ON THESE DRAWINGS SHALL NOT BE CARRIED OUT WITHOUT WRITTEN PERMISSION OF NUMBER TEN ARCHITECTURAL GROUP.  
 THIS DRAWING IS THE EXCLUSIVE PROPERTY OF NUMBER TEN ARCHITECTURAL GROUP AND THE COPYRIGHT IN THE SAME BEING RESERVED TO THEM. IT MAY BE REPRODUCED ONLY WITH THE PERMISSION OF NUMBER TEN ARCHITECTURAL GROUP, IN WHICH CASE THE REPRODUCTION MUST BEAR THEIR NAME.

REVISED/	ISSUED/	PLOTTED	DATE
▲			

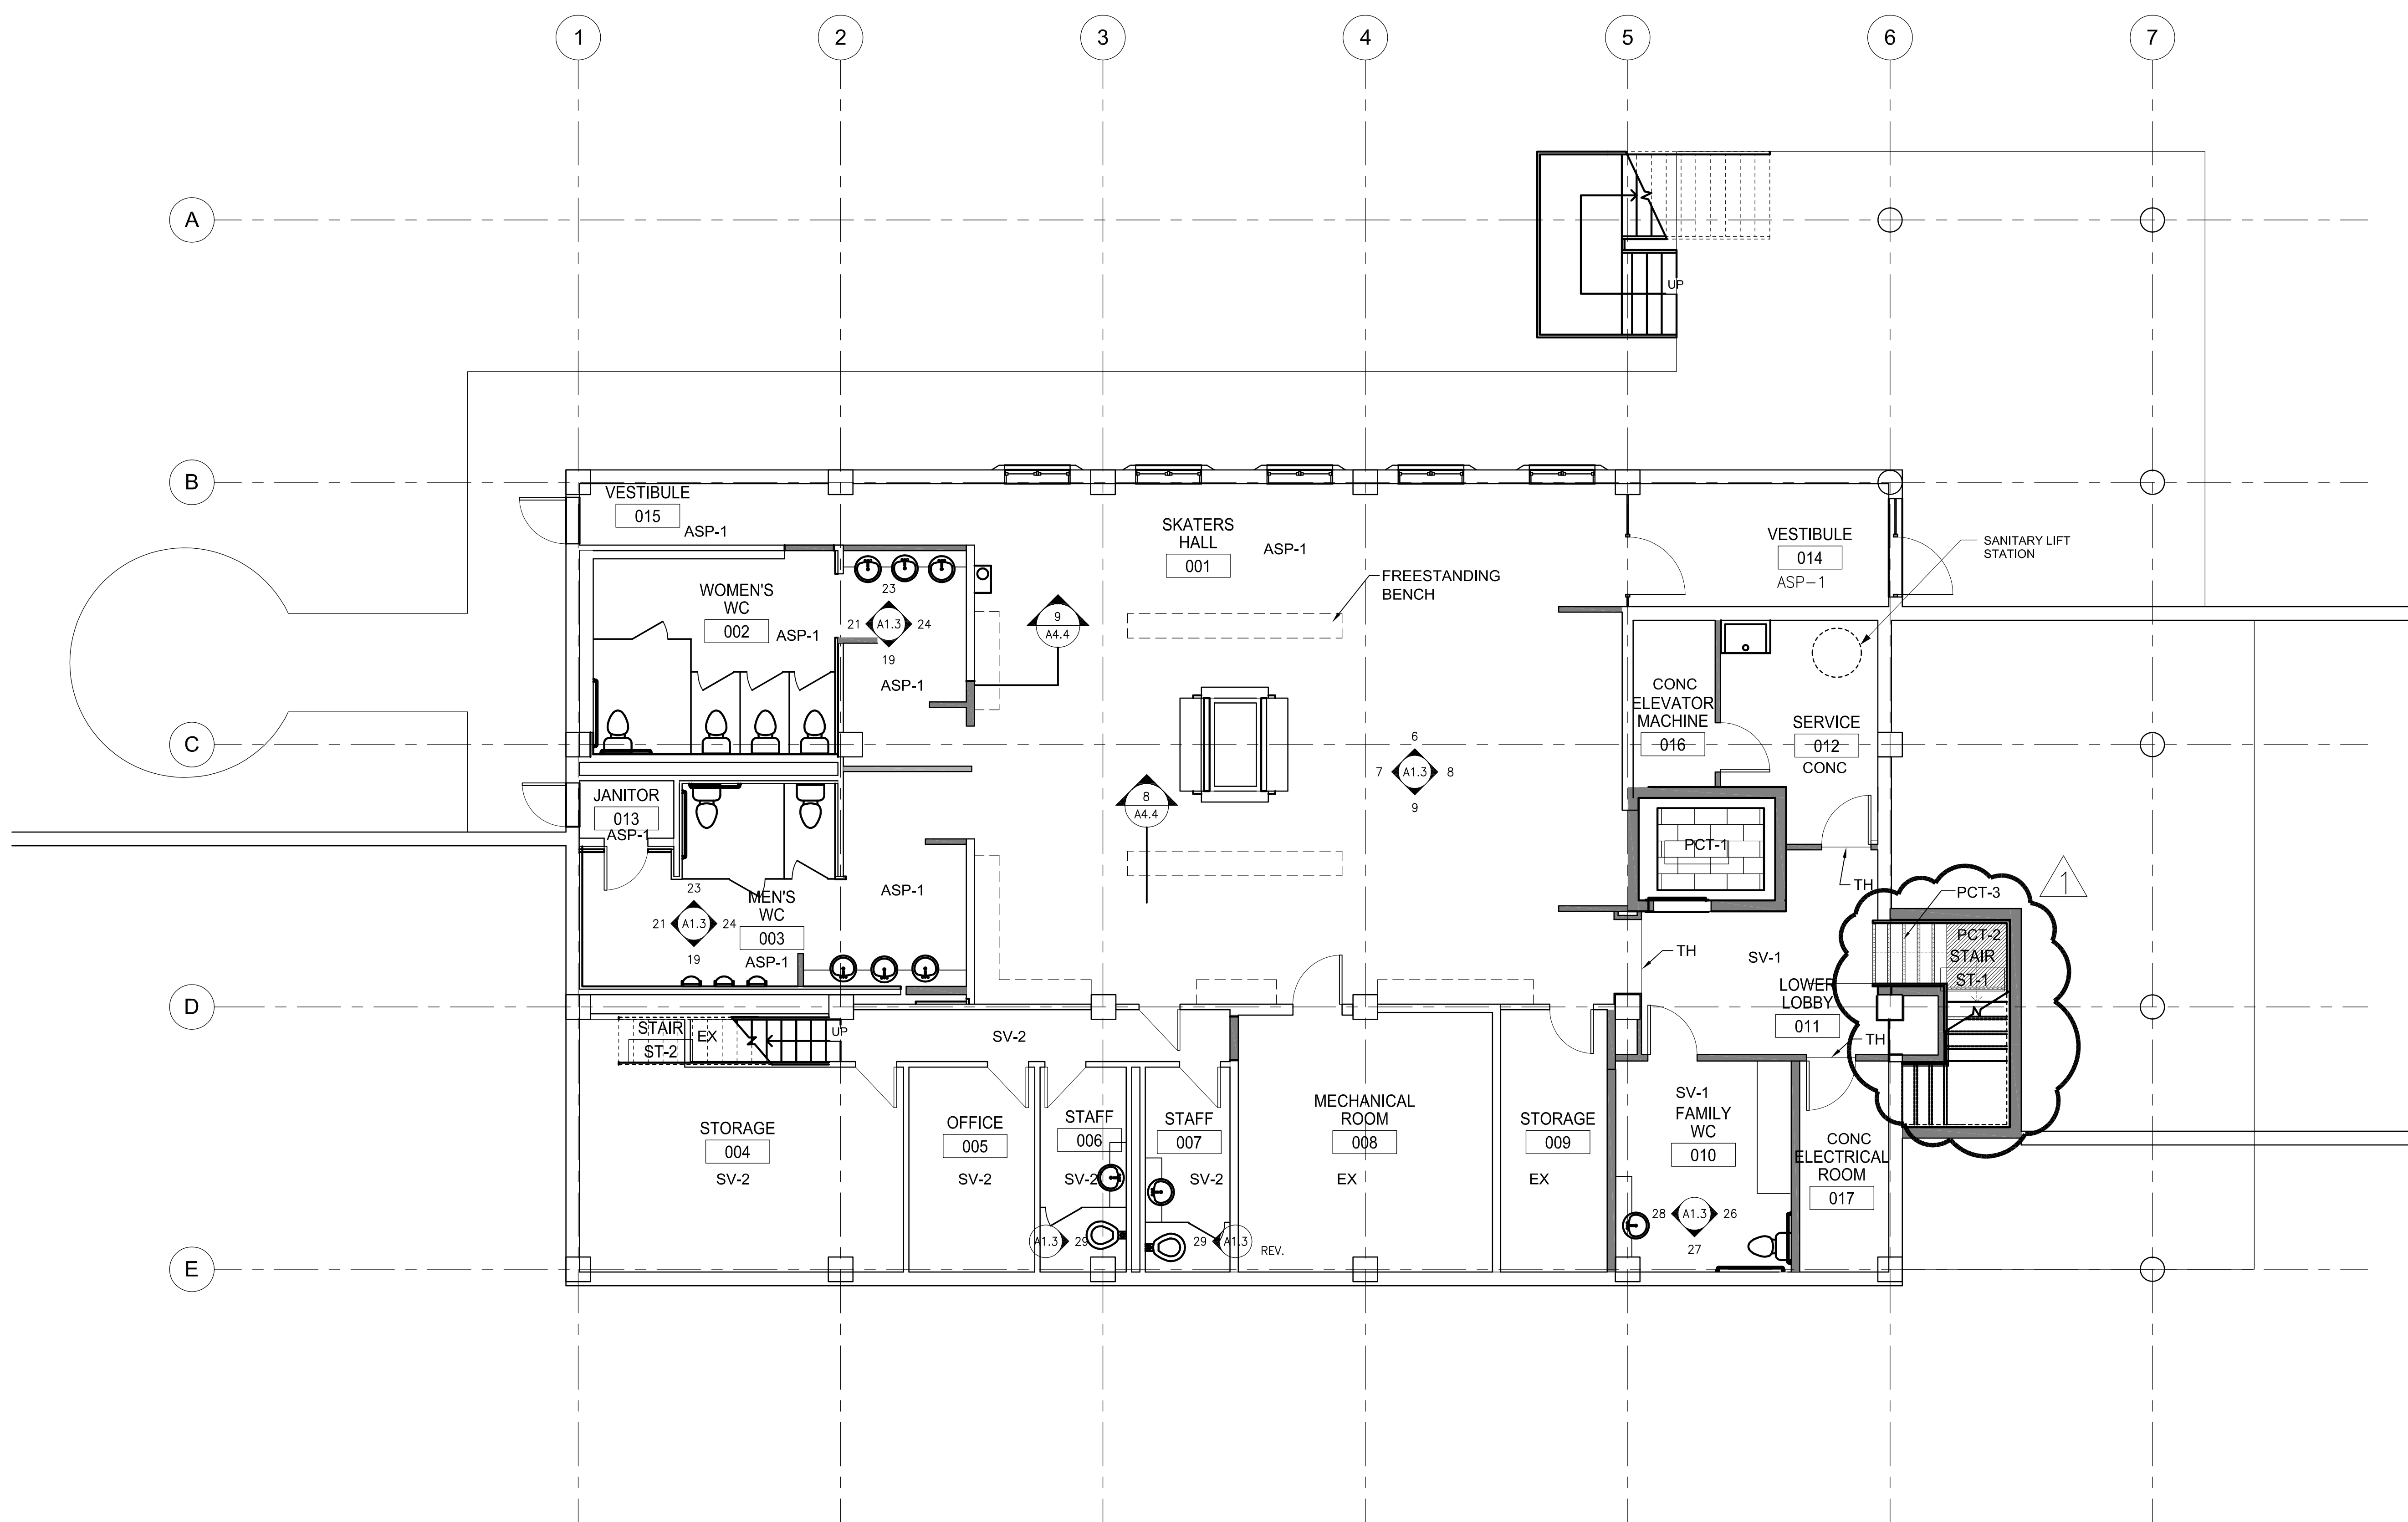

**numberTEN**  
 architectural group  
 winnipeg MB regina SK victoria BC  
 204.942.0981 306.721.1501 250.360.2106  
 architecture • interior design • graphic design

PEGUIS PAVILION  
 UPGRADES AND ADDITION  
 project  
 LOWER LEVEL PLAN  
 FLOOR FINISHES/FURNITURE  
 sheet title

consultant  
 seal  
 drawn by: KDS  
 checked by: RB  
 project no. 2011026  
 scale: 3/16"=1'-0"  
 date: NOV 23/11  
 sheet no. **A1.3**