
power pole required for electrical access; power reg'd below desk too.

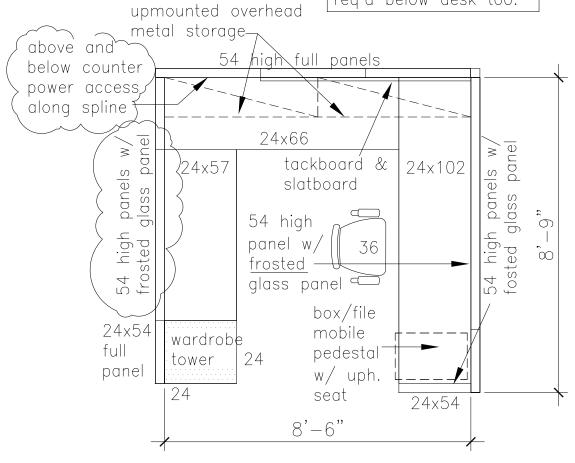

IST Typical Workstation

	THE CITY OF WINNIPEG				ECT		SHEET TITLE	
	PLANNING, PROPERTY AND						ENLARGED PLAN- IST WORKSTATIONS	
Winnipeg	Winnipeg DEVELOPMENT DEPARTMENT MUNICIPAL ACCOMMODATIONS DIVISION				LID WASTE/ IST R	ELOCATION		
3-65 GARRY STREET, R3C 4K4				1120 WAVERLY STREET				
						I _{DATE}	20415	OUEET N
DRAWN BY: C		CHECKED BY:	DESIGNED BY:		APPROVED BY:	DATE:	SCALE: 3/8"=1'-0"	SHEET No:
	KN		l KN			2012-04-26		
	KIN			IXIN		eFILE:	PROJECT No: 2012-035	AZ-K1
							20,200	