




3 DITCH 3 PROFILE
H: 1:500 V: 1:50

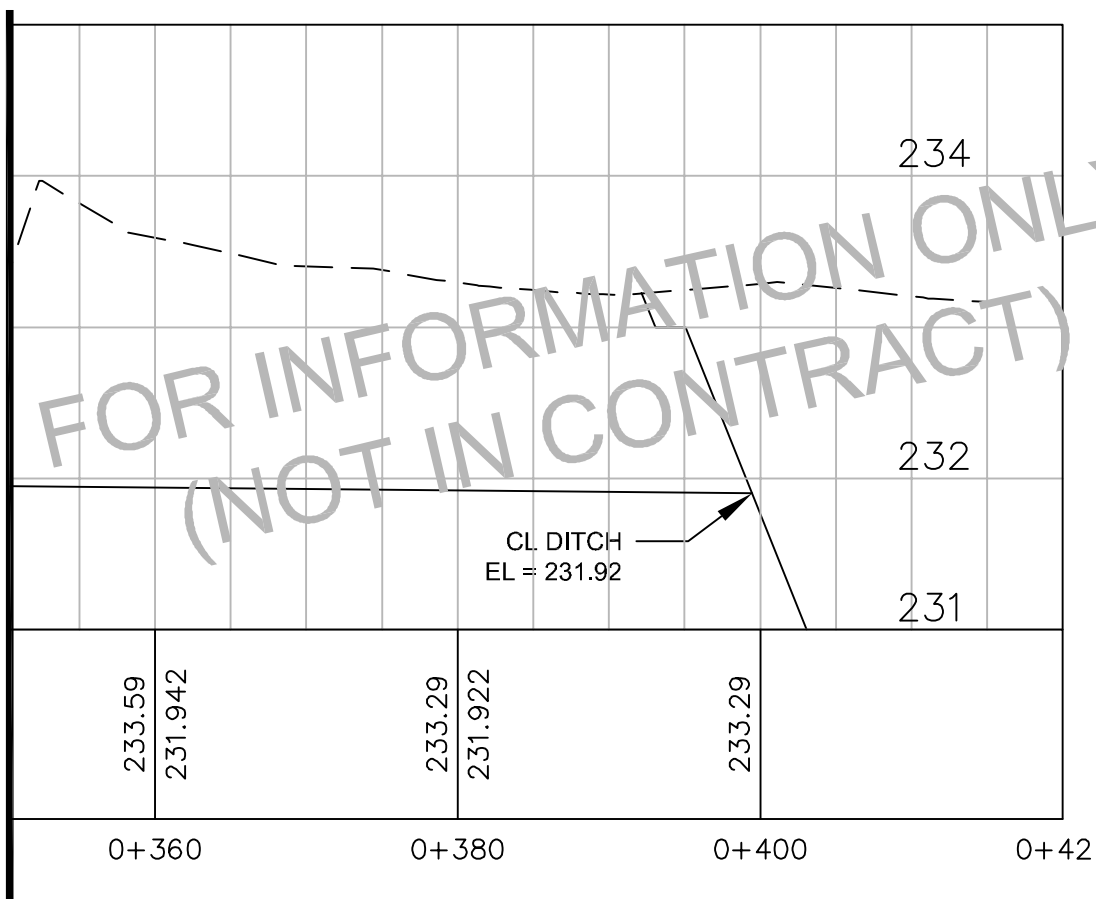


DITCH 3 PROFILE (CONT'D)
H: 1:500 V: 1:50

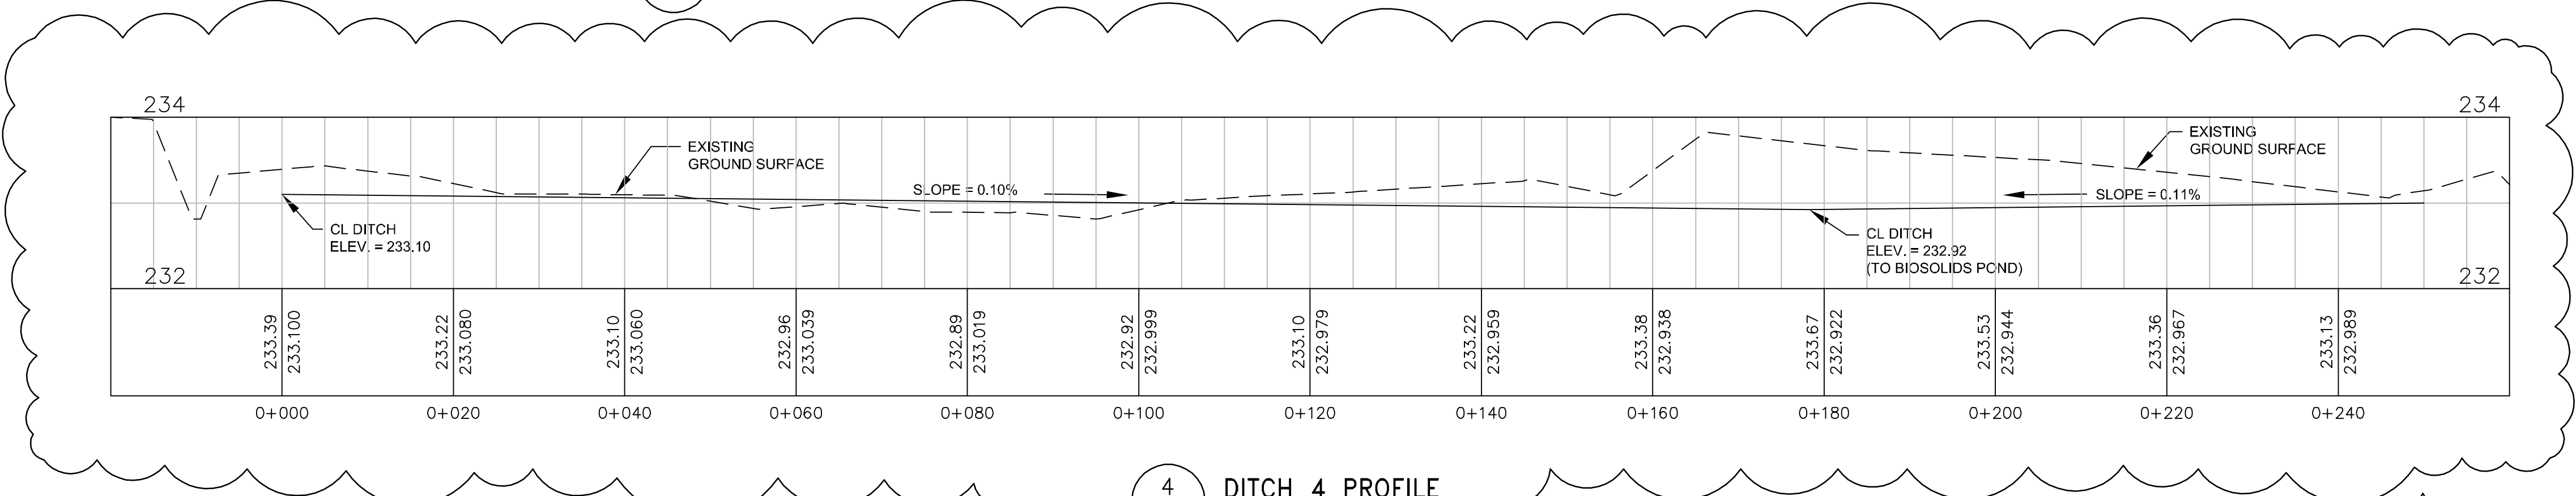

4 DITCH 4 PROFILE
H: 1:500 V: 1:50

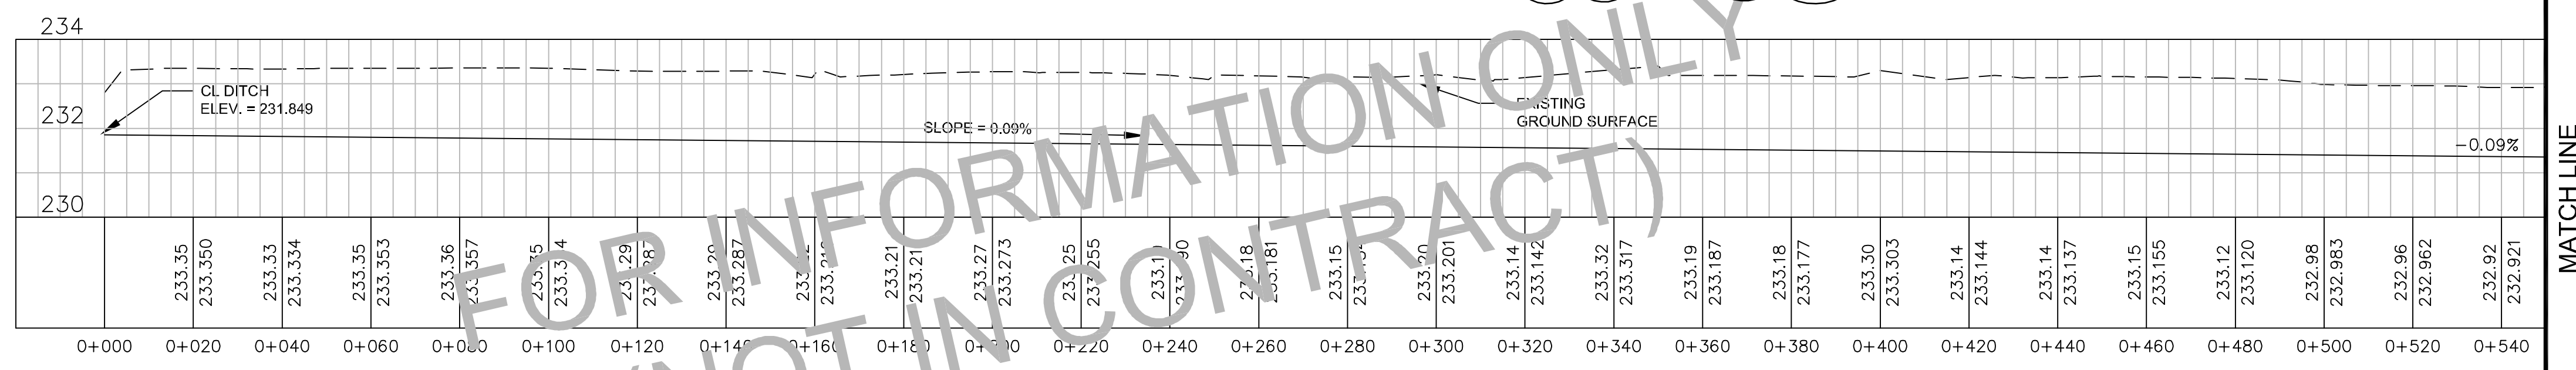

5 DITCH 5 PROFILE
H: 1:1000 V: 1:100

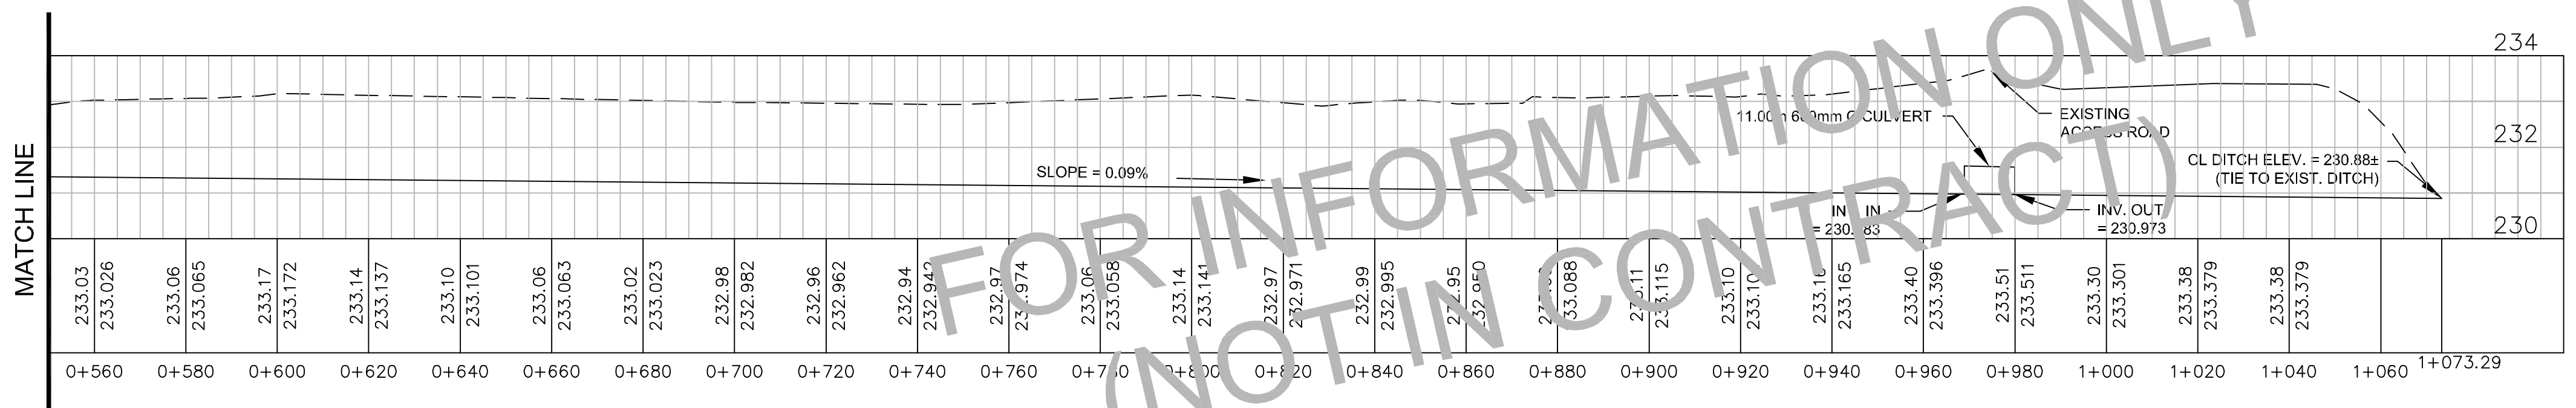

DITCH 5 PROFILE (CONT'D)
H: 1:1000 V: 1:100

B.M. ELEV.			
CONSTRUCTION COMPLETION DATE: YYYY MM DD			
DESIGNED BY	BW	CHECKED BY	SG
DRAWN BY	JBC	APPROVED BY	BW
1 ISSUED FOR ADDENDUM 3	13/03/04	JBC	
0 ISSUED FOR CONSTRUCTION	13/01/25	GMH	
NO.	REVISIONS	DATE	BY

CH2MHILL

SCALE: HORIZONTAL AS NOTED
VERTICAL FOR CONSTRUCTION

DATE: 2013 01 25

ENGINEER'S SEAL

ORIGINAL SIGNED BY
S.B. WILLIAMSON
13/01/25

CONSULTANT DRAWING NUMBER
C-304

THE CITY OF WINNIPEG
WATER AND WASTE DEPARTMENT
ENGINEERING DIVISION

BRADY ROAD RESOURCE MANAGEMENT FACILITY
LEAF AND YARD WASTE AND
PILOT BIOSOLIDS COMPOSTING

CIVIL
DRAINAGE DITCH PROFILES SHEET 2 OF 2

SHEET 13 OF 45
CITY DRAWING NUMBER
1-0400B-C0009-002-01