


WEST MULTI-USE PATH NORTH OF WAVERLEY CONTROL LINE		
Station	Elevation (m)	Grade Out (%)
6+800.000	233.700	0.00%
6+828.000	233.700	-1.22%
6+880.008	233.065	0.09%
6+926.015	233.104	-0.14%
7+005.685	232.990	0.17%
7+405.755	233.665	0.36%
7+498.060	234.000	

EAST MULTI-USE PATH NORTH OF WAVERLEY CONTROL LINE		
Station	Elevation (m)	Grade Out (%)
4+810.000	233.300	0.00%
4+836.000	233.300	-0.47%
4+884.000	233.075	0.25%
4+930.000	233.190	-0.36%
4+985.397	232.989	0.00%
4+995.000	232.990	0.17%
5+395.000	233.665	0.36%
5+488.672	234.000	

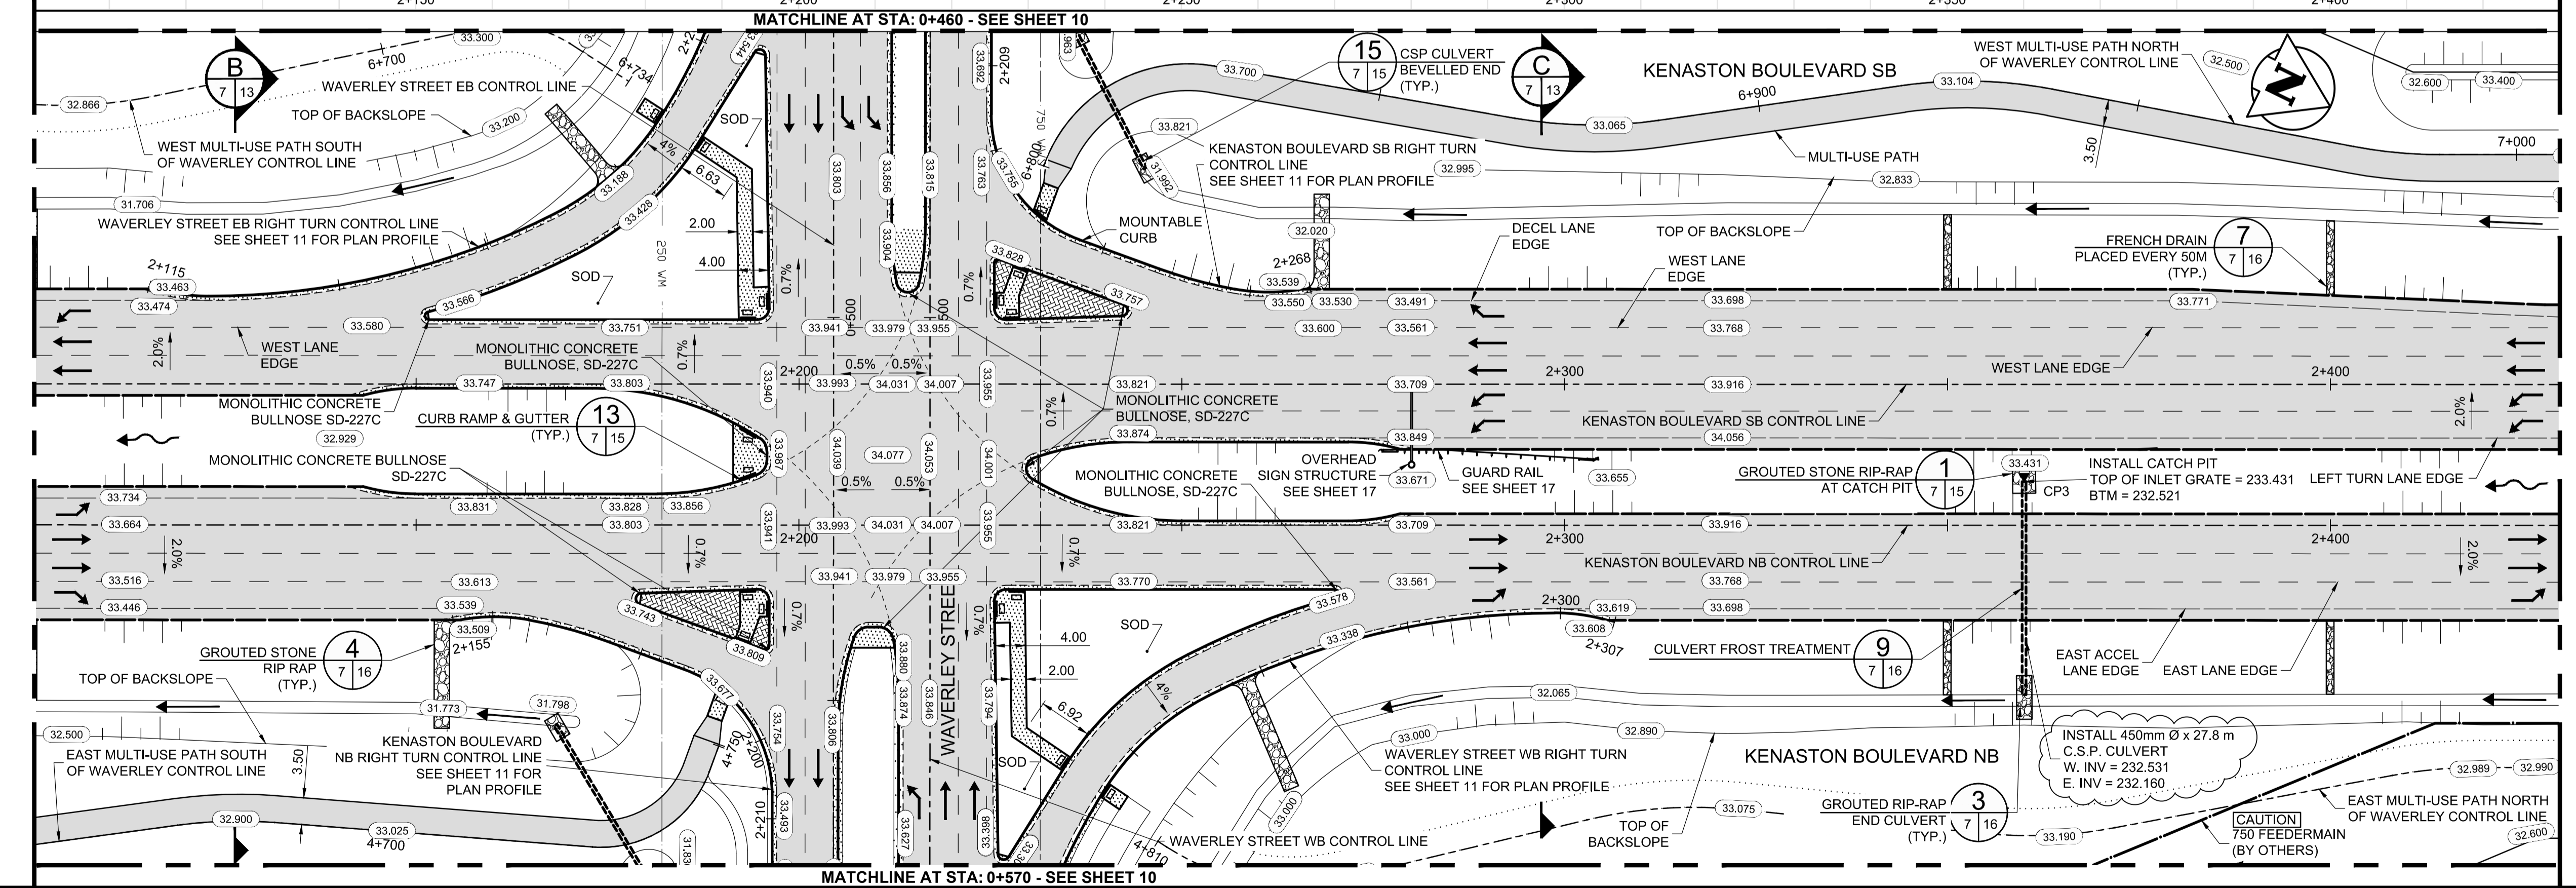

CATCH BASIN, CATCH PIT STRUCTURE AND LOCATION SCHEDULE					
ID	STA	O/S NB KENASTON CONTROL LINE	RIM ELEV	BTM ELEV	INV ELEV
CP3	2+360	5.7 L	233.431	232.521	232.531

APEGM
 Certificate of Authorization
Dillon Consulting Limited (MB)
 No. 1789 Date: 2013-04-05

METRIC
 WHOLE NUMBERS INDICATE MILLIMETRES
 DECIMALIZED NUMBERS INDICATE METRES

WARNING
 IF POWER EQUIPMENT OR EXPLOSIVES ARE TO BE USED FOR EXCAVATION ON THIS PROJECT THE CONTRACTOR MUST:
 1. NOTIFY THE GAS COMPANY OF THE PROPOSED LOCATION OF EXCAVATION.
 2. TAKE PRECAUTION TO AVOID DAMAGE TO GAS COMPANY INSTALLATIONS SEE PROVINCIAL REGULATION 210/72 FOR DETAILS.
 3. OBTAIN EXCAVATION PERMITS PRIOR TO CONSTRUCTION.

150 MM	150 MM	MTS	MTS	150 mm W.M.	150 mm W.M.
WATERMAIN	CONCRETE VALVE	CONCRETE ASPHALT PLANNING SIDEWALK	PAVING STONES PROPERTY LINE	WATERMAIN	HYDRANT VALVE
LAND DRAINAGE SEWER	WASTE WATER SEWER	MANHOLE	CATCH BASIN CURB INLET	LAND DRAINAGE SEWER	WASTE WATER SEWER
TEST HOLES	CULVERT	100 GAS	EXISTING	LAND DRAINAGE SEWER	WASTE WATER SEWER
LEGEND-PLAN	PROPOSED	EXISTING	LEGEND-PLAN	PROPOSED	EXISTING

UNDERGROUND STRUCTURES	
SUPPL. U/G STRUCTURES COMMITTEE	DATE
NOTE: LOCATION OF UNDERGROUND STRUCTURES AS SHOWN ARE BASED ON THE BEST INFORMATION AVAILABLE. BUT NO GUARANTEE IS GIVEN THAT ALL EXISTING UTILITIES ARE SHOWN OR THAT THE GIVEN LOCATIONS ARE EXACT. CONFIRMATION OF EXISTENCE AND EXACT LOCATION OF ALL SERVICES MUST BE OBTAINED FROM THE INDIVIDUAL UTILITIES BEFORE PROCEEDING WITH CONSTRUCTION.	

B.M. 654008 N: 5515764.610 E: 633359.697 ELEV. 232.463 m	
DESIGNED BY	MRD
DRAWN BY	PMW
CHECKED BY	DBW
APPROVED BY	DPK
HOR. SCALE	1:500
VERTICAL	1:20
RELEASED FOR CONSTRUCTION	
DATE	2013-04-05

DESIGN TEAM	
DESIGNED BY	MRD
DRAWN BY	PMW
CHECKED BY	DBW
APPROVED BY	DPK
HOR. SCALE	1:500
VERTICAL	1:20
RELEASED FOR CONSTRUCTION	
DATE	2013-04-05

ENGINEER'S SEAL
 ORIGINAL STAMPED BY
M.R. DOUCET
 2013-04-05
 Member 22306
 REGISTERED PROFESSIONAL ENGINEER

THE CITY OF WINNIPEG
 PUBLIC WORKS DEPARTMENT

WWARP PART 3 - CONTRACT 3
 STA: 1+450 TO STA: 2+922.4

PLAN PROFILE KENASTON
 STA: 2+100 TO 2+430

CITY DRAWING NUMBER: P-3344-7
 SHEET 7 OF 23
 CONSULTANT DRAWING NUMBER

G:\CAD\126606\Contract\Contract_3\Current\Plan_Profile.dwg