

SEWER JUNCTION INFORMATION*			
REF MH	DIST FROM MH	SIZE	CLOCK AT
MH20001430	31.1	1500/2000	03


*JUNCTION INFORMATION FROM VIDEO INSPECTION

REFERENCE NOTES

- A. PAVEMENT DIMENSIONS ARE TO BACK OF CURB
- B. BASELINE IS CENTRE LINE RIGHT-OF-WAY
- C. PROPERTY LINES OBTAINED FROM CITY OF WINNIPEG, L.B.S., AND NO SCALE FACTOR WAS APPLIED
- D. REFER TO AECOM FIELD BOOK NO. 4791

CONSTRUCTION NOTES

1. PLACE NEW ASPHALTIC PAVEMENT TYPE 1A (AVERAGE THICKNESS 75mm)
2. REMOVE EXISTING CONCRETE PAVEMENT AND CONSTRUCT NEW 150mm REINFORCED CONCRETE PAVEMENT c/w 75mm ASPHALT OVERLAY
3. RENEW EXISTING CONCRETE PAVEMENT c/w 75mm ASPHALT OVERLAY
4. RENEW EXISTING ASPHALT PAVEMENT CURB (150mm REVEAL HT. DOWNELLED)
5. CONSTRUCT NEW ASPHALT PAVEMENT CURB (150mm REVEAL HT. DOWNELLED)
6. CONSTRUCT NEW CURB RAMP (100mm REVEAL HT. MOUNTOUT/HIC)
7. (150mm EXISTING 120mm MOUNTABLE CURB AND CONSTRUCT NEW BARRIER CURB (150mm REVEAL HT. DOWNELLED)
8. RENEW EXISTING 100mm CONCRETE SIDEWALK

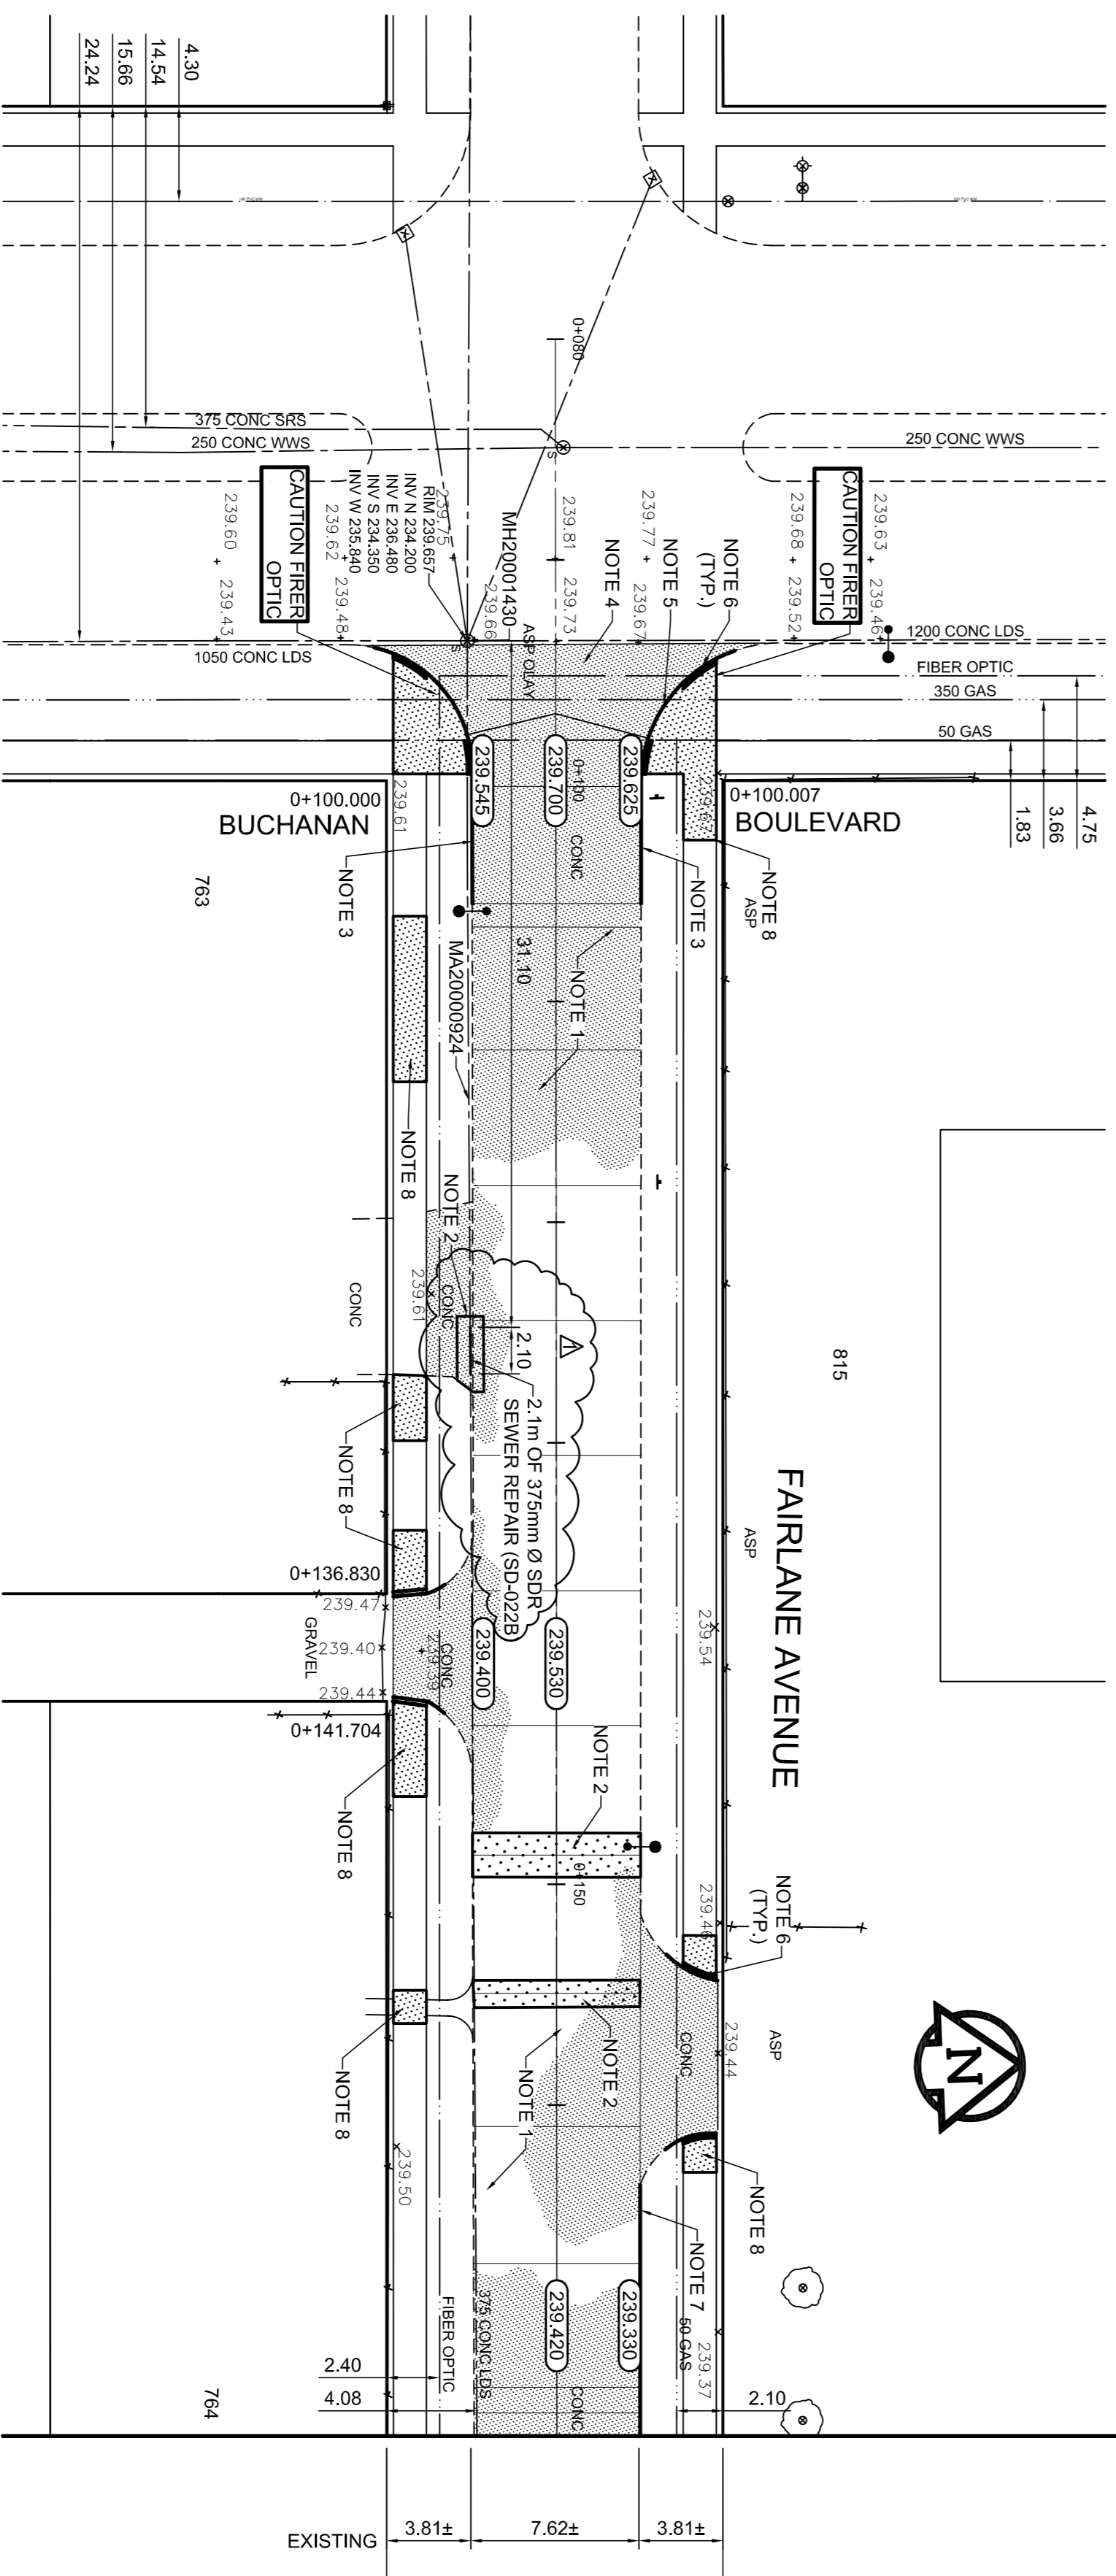

METRIC
WHOLE NUMBERS INDICATE MILLIMETRES
DECIMALIZED NUMBERS INDICATE METRES

EXISTING		PROPOSED		EXISTING		PROPOSED		EXISTING		PROPOSED	
	WATERMAIN		150 mm W.M.		HYDRO		M.T.S.		NORTHWEST GUTTER		SOUTH-EAST GUTTER



THE CITY OF WINNIPEG
PUBLIC WORKS DEPARTMENT
ENGINEERING DIVISION

2013 LOCAL STREET
RENEWAL PROGRAM
FAIRLANE AVE. - BUCHANAN BOULEVARD TO GOSWELL ROAD
PAVEMENT REHABILITATION
BUCHANAN BOULEVARD TO STATION 0+175

CITY DRAWING NUMBER
SHEET 6 OF 16

LOCATION APPROVED UNDERGROUND STRUCTURES

STIP. USE STRUCTURES COMMITTEE	DATE
B.M. 8395659, NW Cor. Buchanan Blvd. & Fairlane Ave., Thelon	ELEV. 239.659
ADDENDUM 1	06/06/2013
ISSUED FOR TENDER	05/30/2013
ISSUED FOR REVIEW	05/24/2013

NO.	REVISIONS	DATE	BY
1	ISSUED FOR REVIEW	05/24/2013	BC
2	ISSUED FOR TENDER	05/30/2013	BC
3	ADDENDUM 1	06/06/2013	BC

DESIGNED	BY	DATE	CHECKED	BY	DATE
BC	BC		KWR	KWR	

DESIGNED BY: BC
DRAWN BY: SS
HORIZ. SCALE: 1:250
VERTICAL: 1:10
DATE: MAY 2013