



A MOLSON STREET - STA. 0+225
SCALE - H:1:100 V:1:50

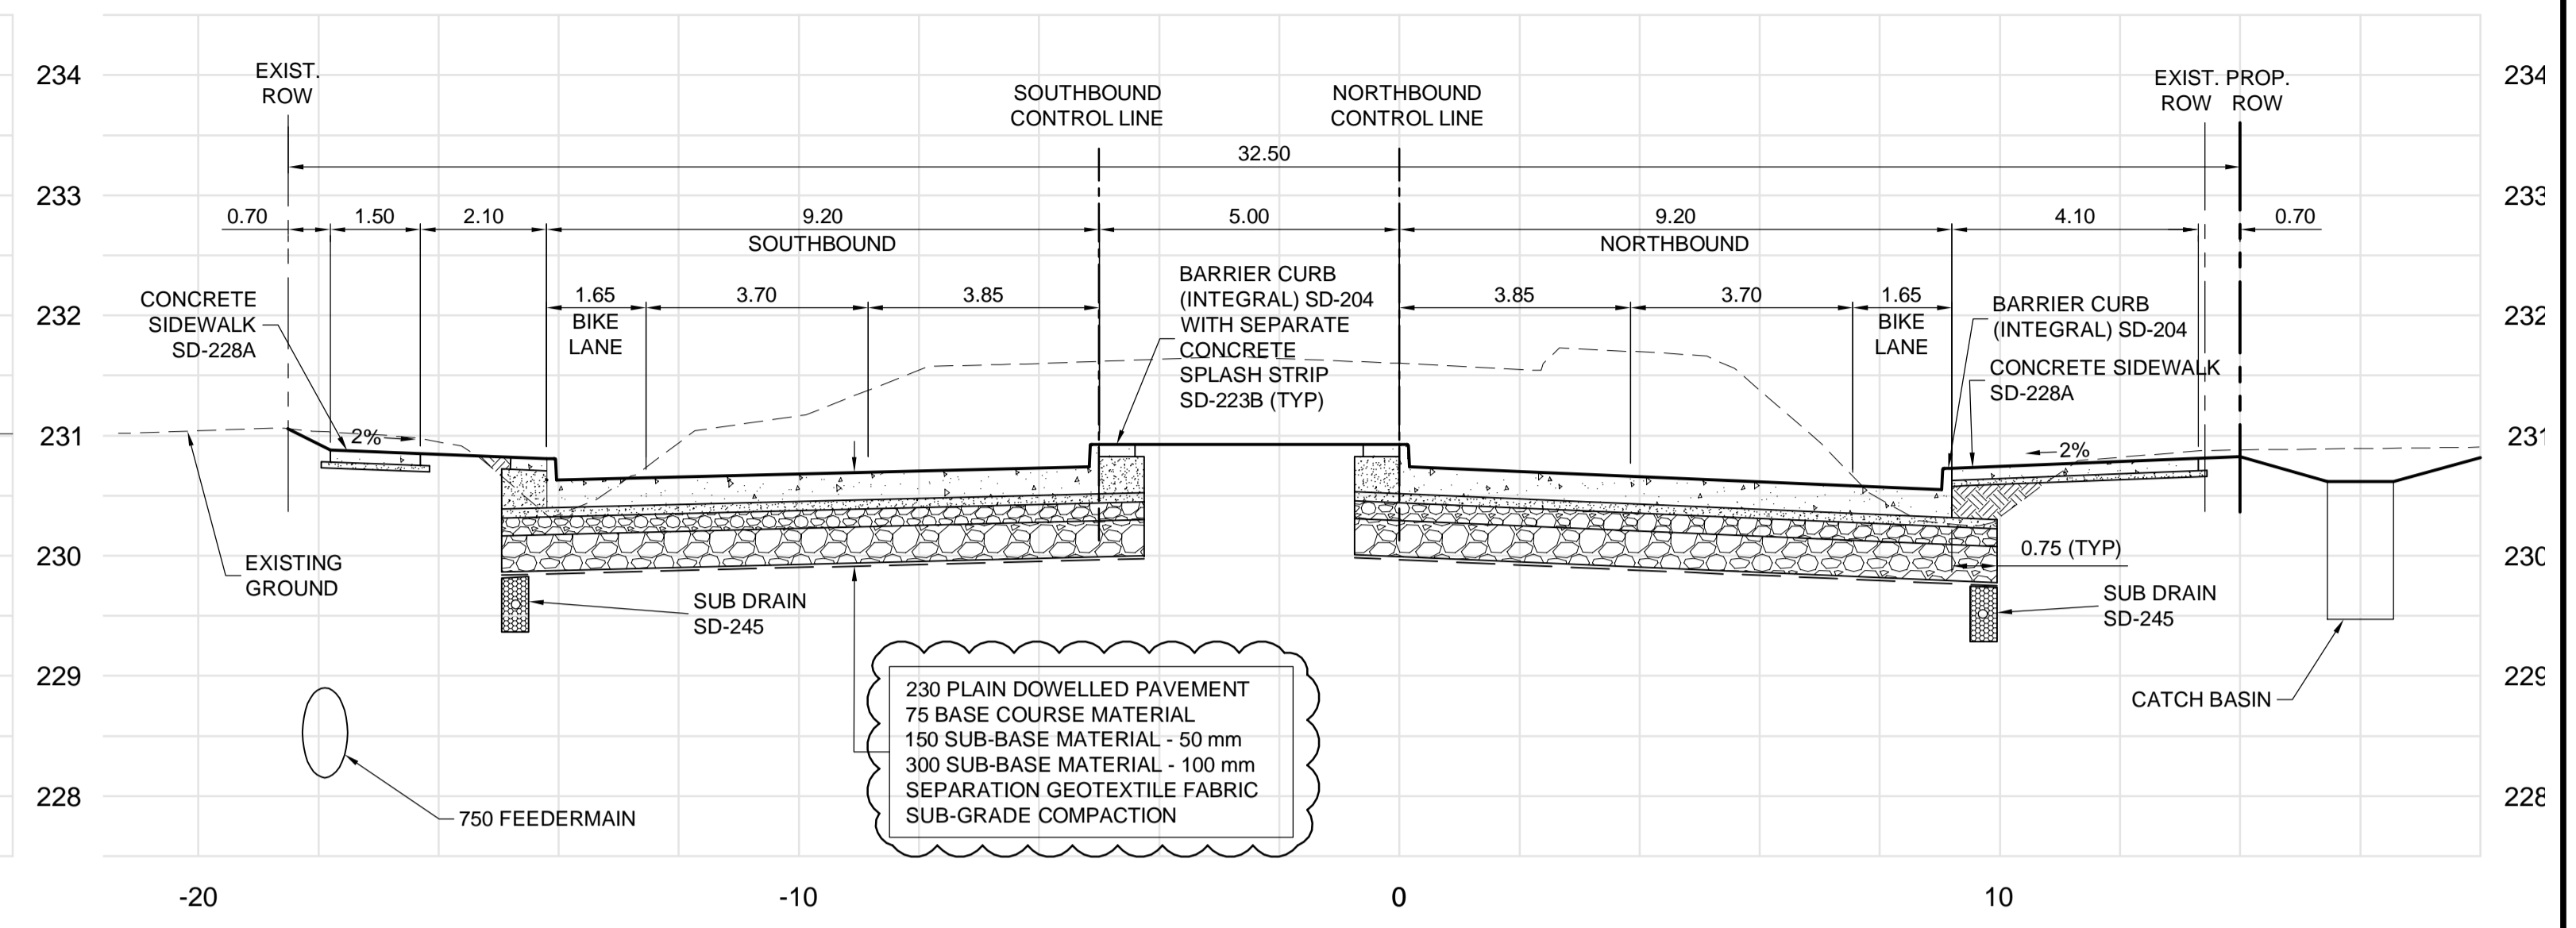

B MOLSON STREET - STA. 0+250
SCALE - H:1:100 V:1:50

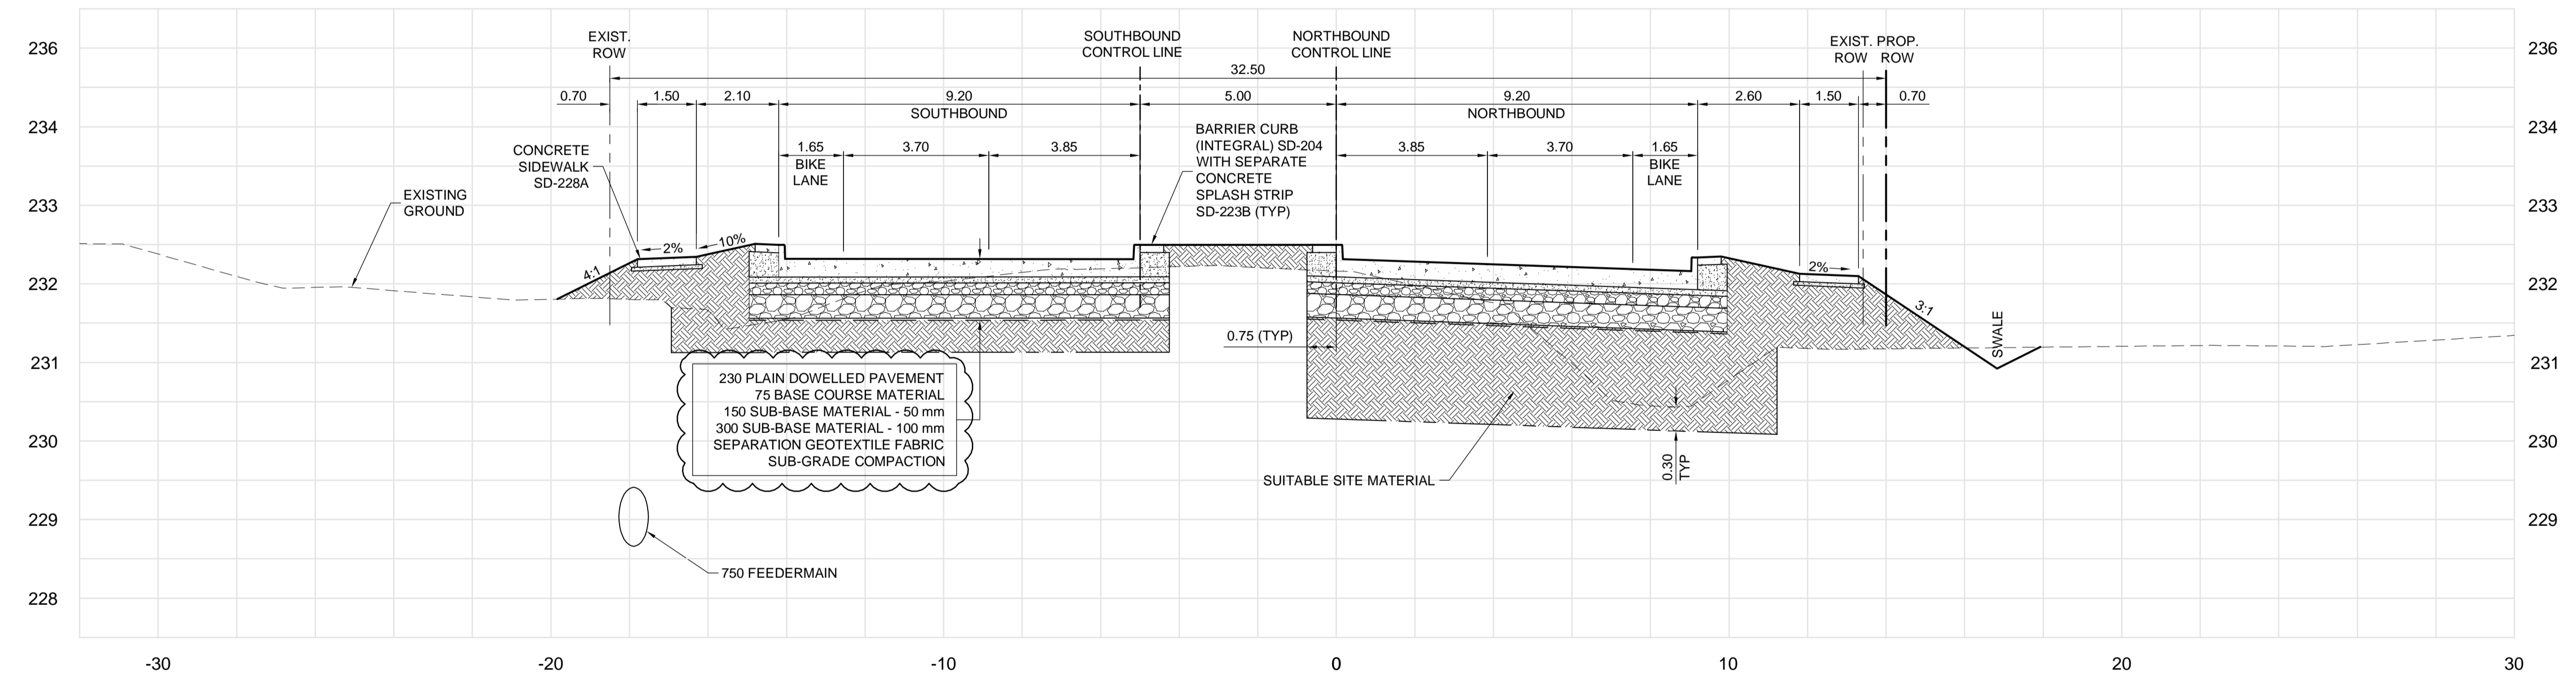

C MOLSON STREET - STA. 0+325
SCALE - H:1:100 V:1:50

METRIC

WHOLE NUMBERS INDICATE MILLIMETRES
DECIMALIZED NUMBERS INDICATE METRES

APEGM
Certificate of Authorization
Dillon Consulting Limited (MB)
No. 1789 Date: 01/14/2014

G:\CAD\127055\02-Civil\01-Contract\20-Sections-Details.dwg

| | | | | | | | |
|----------|---------------------|----------|----------|-------------|----------|---------------------|----------------|
| 150 WM | WATERMAIN | 150 WM | HYDRO | HYDRO | 150 WM | WATERMAIN | 150 WM |
| + | HYDRANT | + | MTS | MTS | + | HYDRANT | + |
| + | VALVE | + | MTS | MTS | + | VALVE | + |
| 300 LDS | LAND DRAINAGE SEWER | 300 LDS | | | 300 LDS | LAND DRAINAGE SEWER | 300 LDS |
| 250 WWS | WASTE WATER SEWER | 250 WWS | | | 250 WWS | WASTE WATER SEWER | 250 WWS |
| ○ | MANHOLE | ● | | | ○ | MANHOLE | ● |
| □ | CATCH BASIN | ■ | | | □ | CATCH BASIN | ■ |
| ▽ | CURB INLET | ▽ | | | ▽ | CURB INLET | ▽ |
| + | JUNCTIONS | + | | | + | JUNCTIONS | + |
| + | CULVERT | + | | | + | CULVERT | + |
| 100 GAS | GAS | 100 GAS | | | 100 GAS | GAS | 100 GAS |
| EXISTING | LEGEND-PLAN | PROPOSED | EXISTING | LEGEND-PLAN | PROPOSED | EXISTING | LEGEND-PROFILE |

| | | | | |
|------------------------|---------------------------|------------|-------------|------------|
| UNDERGROUND STRUCTURES | | B.M. ELEV. | DESIGNED BY | JMS/MRD |
| SUPV. U/G STRUCTURES | DATE | | DRAWN BY | TJH |
| | | | CHECKED BY | JNC |
| | | | APPROVED BY | DPK |
| 4 | ISSUED FOR ADDENDUM NO. 3 | 01/14/14 | JNC | |
| 3 | ISSUED FOR TENDER | 12/16/13 | JNC | |
| 2 | ISSUED FOR REVIEW | 07/22/13 | JNC | |
| 1 | ISSUED FOR REVIEW | 06/21/13 | JNC | |
| NO. | REVISIONS | DATE | BY | DATE |
| | | | | 01/14/2014 |

DILLON CONSULTING

RELEASED FOR CONSTRUCTION

DATE

ENGINEER'S SEAL

PROVINCE OF MANITOBA

REGISTERED PROFESSIONAL ENGINEER

J.N. CRANG

01/14/2014

CONSULTANT PROJECT NUMBER

12-7055

THE CITY OF WINNIPEG
PUBLIC WORKS DEPARTMENT

PANET ROAD/MOLSON STREET
RECONSTRUCTION AND TWINNING

CITY DRAWING NUMBER
P-3350-27

SHEET 27 OF 47

CONSULTANT DRAWING NUMBER

SECTIONS (1 OF 5)