


FILE NAME: 1120WV01.dwg DATE: 2013.07.18 SHEET TITLE: MAIN FLOOR PLAN - DEMO PROJECT No: ADDRESS: 1120 WAVERLEY STREET

NOTES:

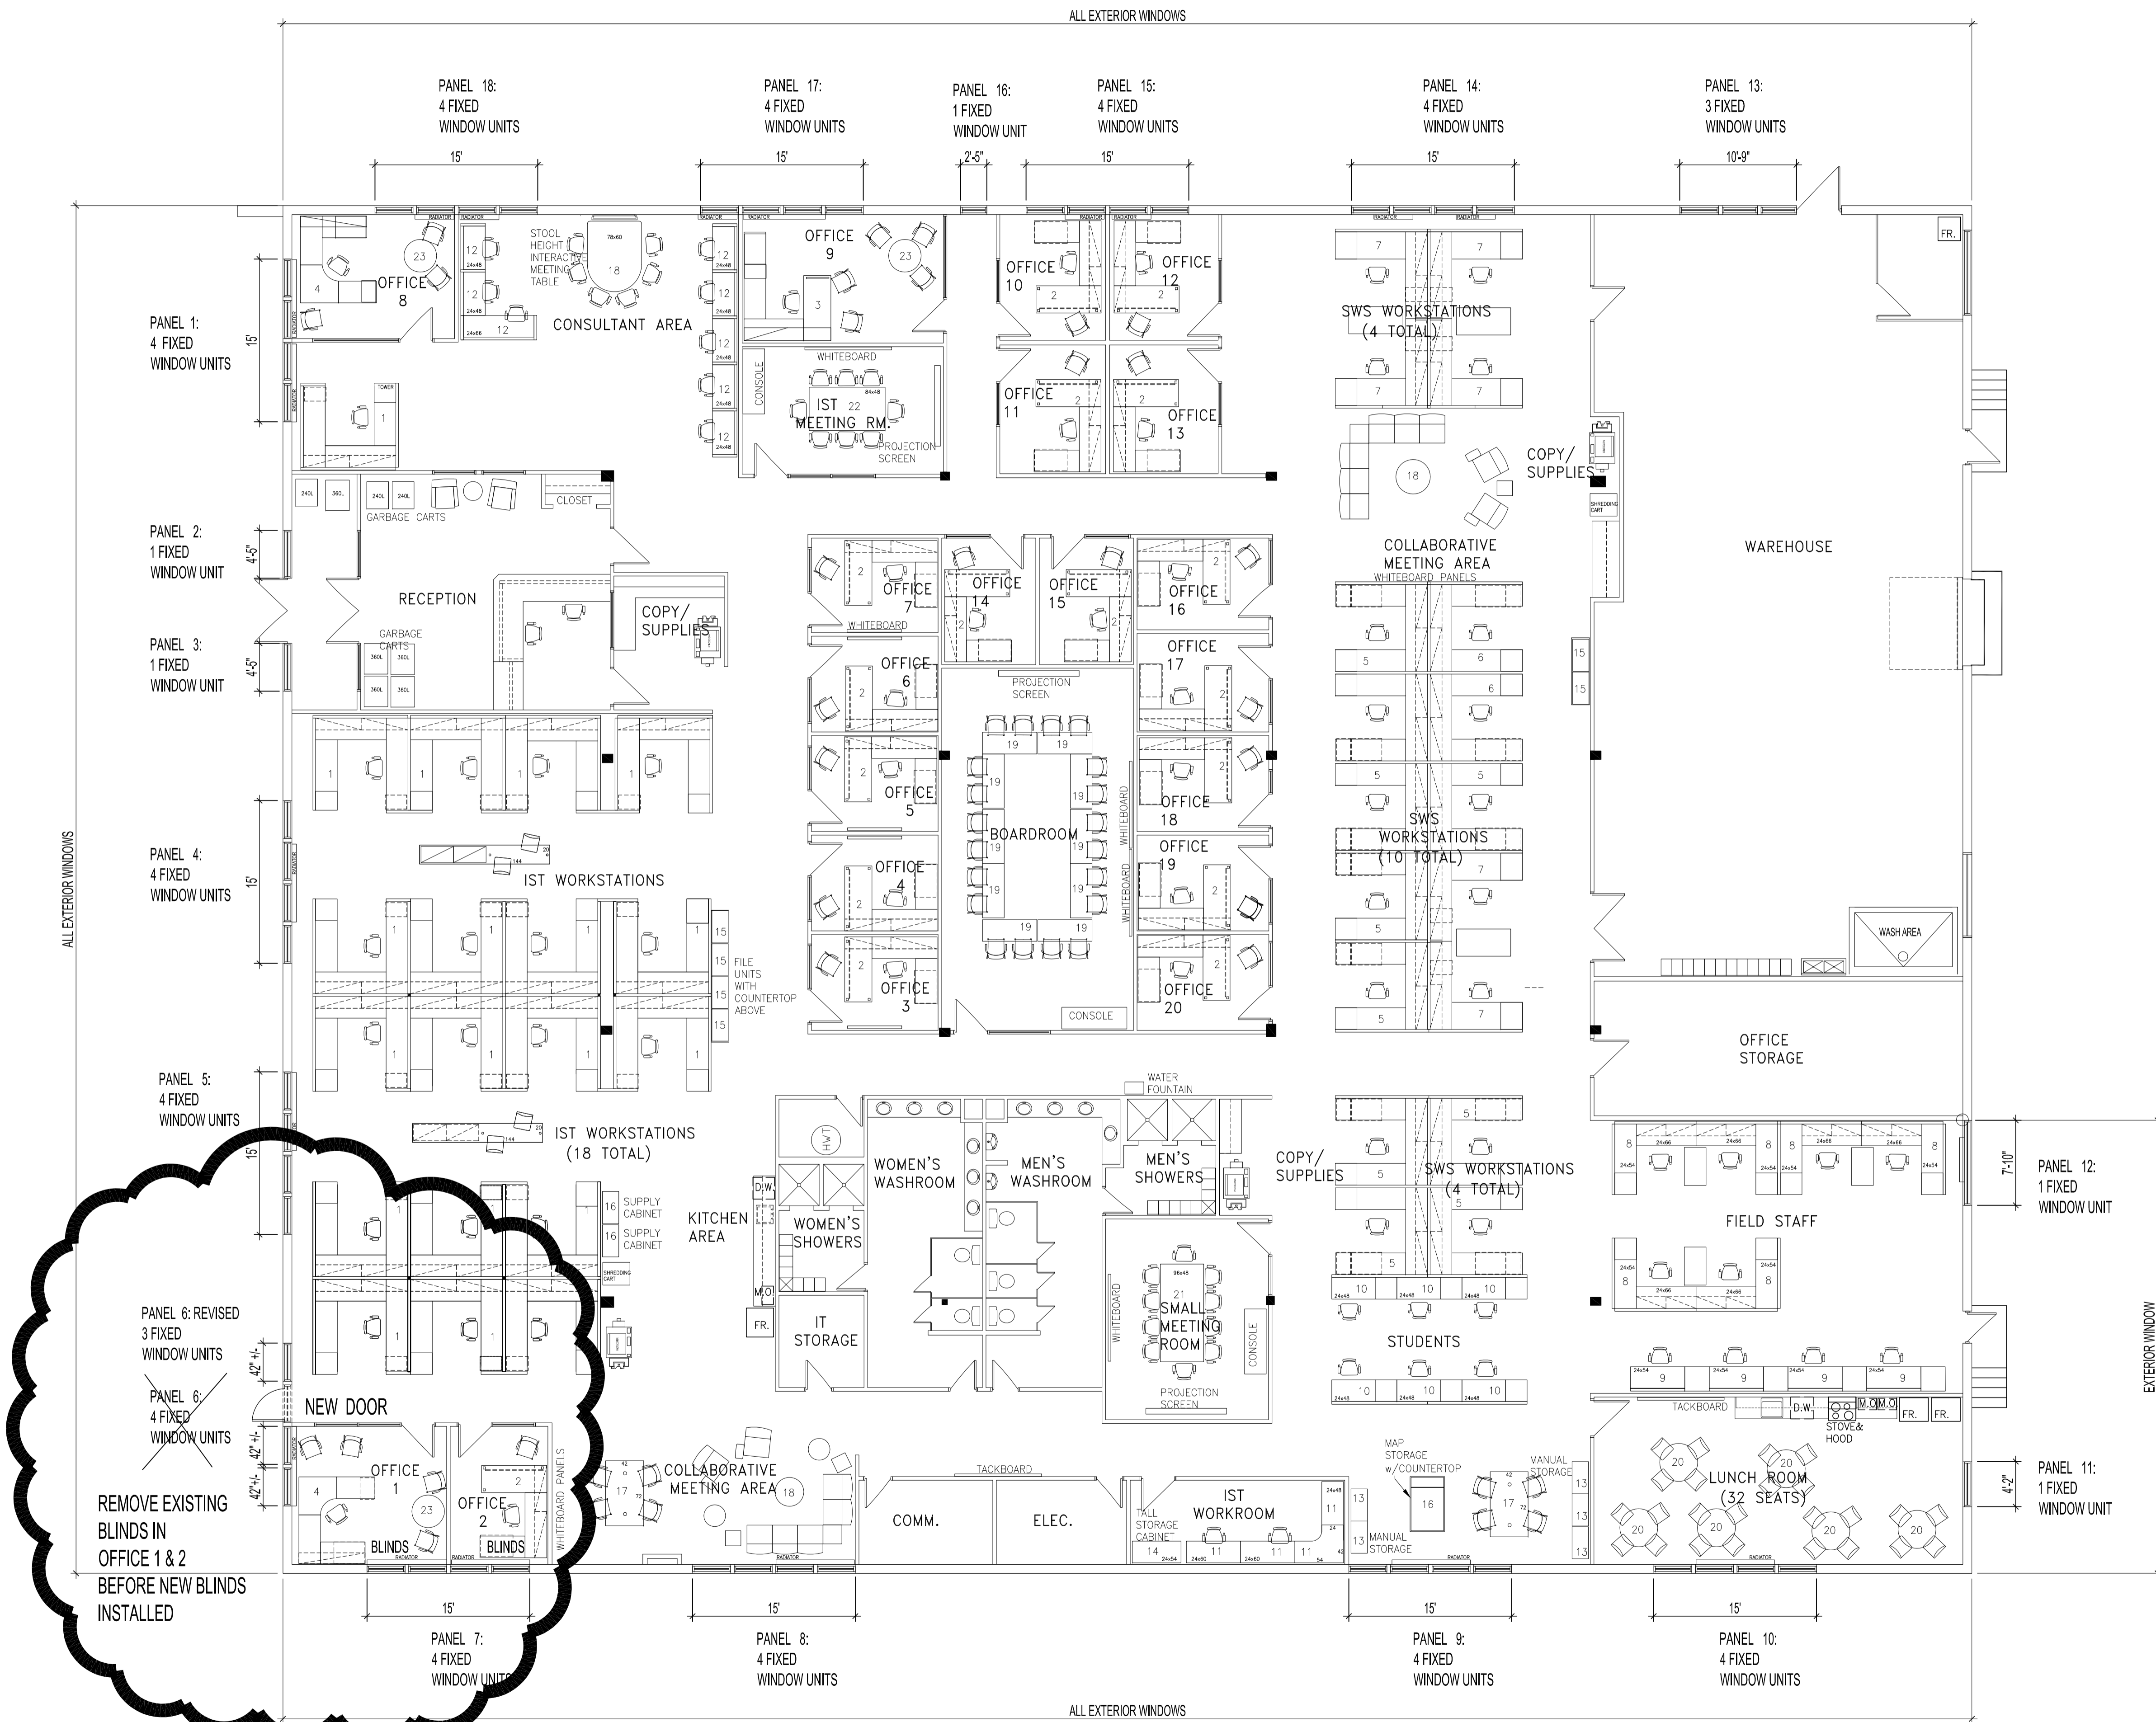

1120 WAVERLEY STREET - MAIN FLOOR PLAN
SCALE: 1/8"=1'-0"

No.	REVISION/DESCRIPTION	BY	DATE
1.	NEW EXT. DOOR INSTALLED. ONE FIXED WINDOW UNIT REMOVED.	TC	2013.07.18

DRAWN	TC	CHECKED	DESIGNED	APPROVED
DATE 2013.07.18				USER APPROVAL

THE CITY OF WINNIPEG
PLANNING, PROPERTY AND
DEVELOPMENT DEPARTMENT
MUNICIPAL ACCOMMODATIONS DIVISION
3-65 GARRY STREET, R3C 4K4

PROJECT
WATER & WASTE DEPARTMENT
BLIND REPLACEMENT

1120 WAVERLEY STREET
SHEET TITLE
MAIN FLOOR PLAN

SCALE	PROJECT No:	SHEET No:
AS SHOWN		A1R1

DRAWING SHEET SIZE: A1 (841mm x 594mm) PLOT 1:1